
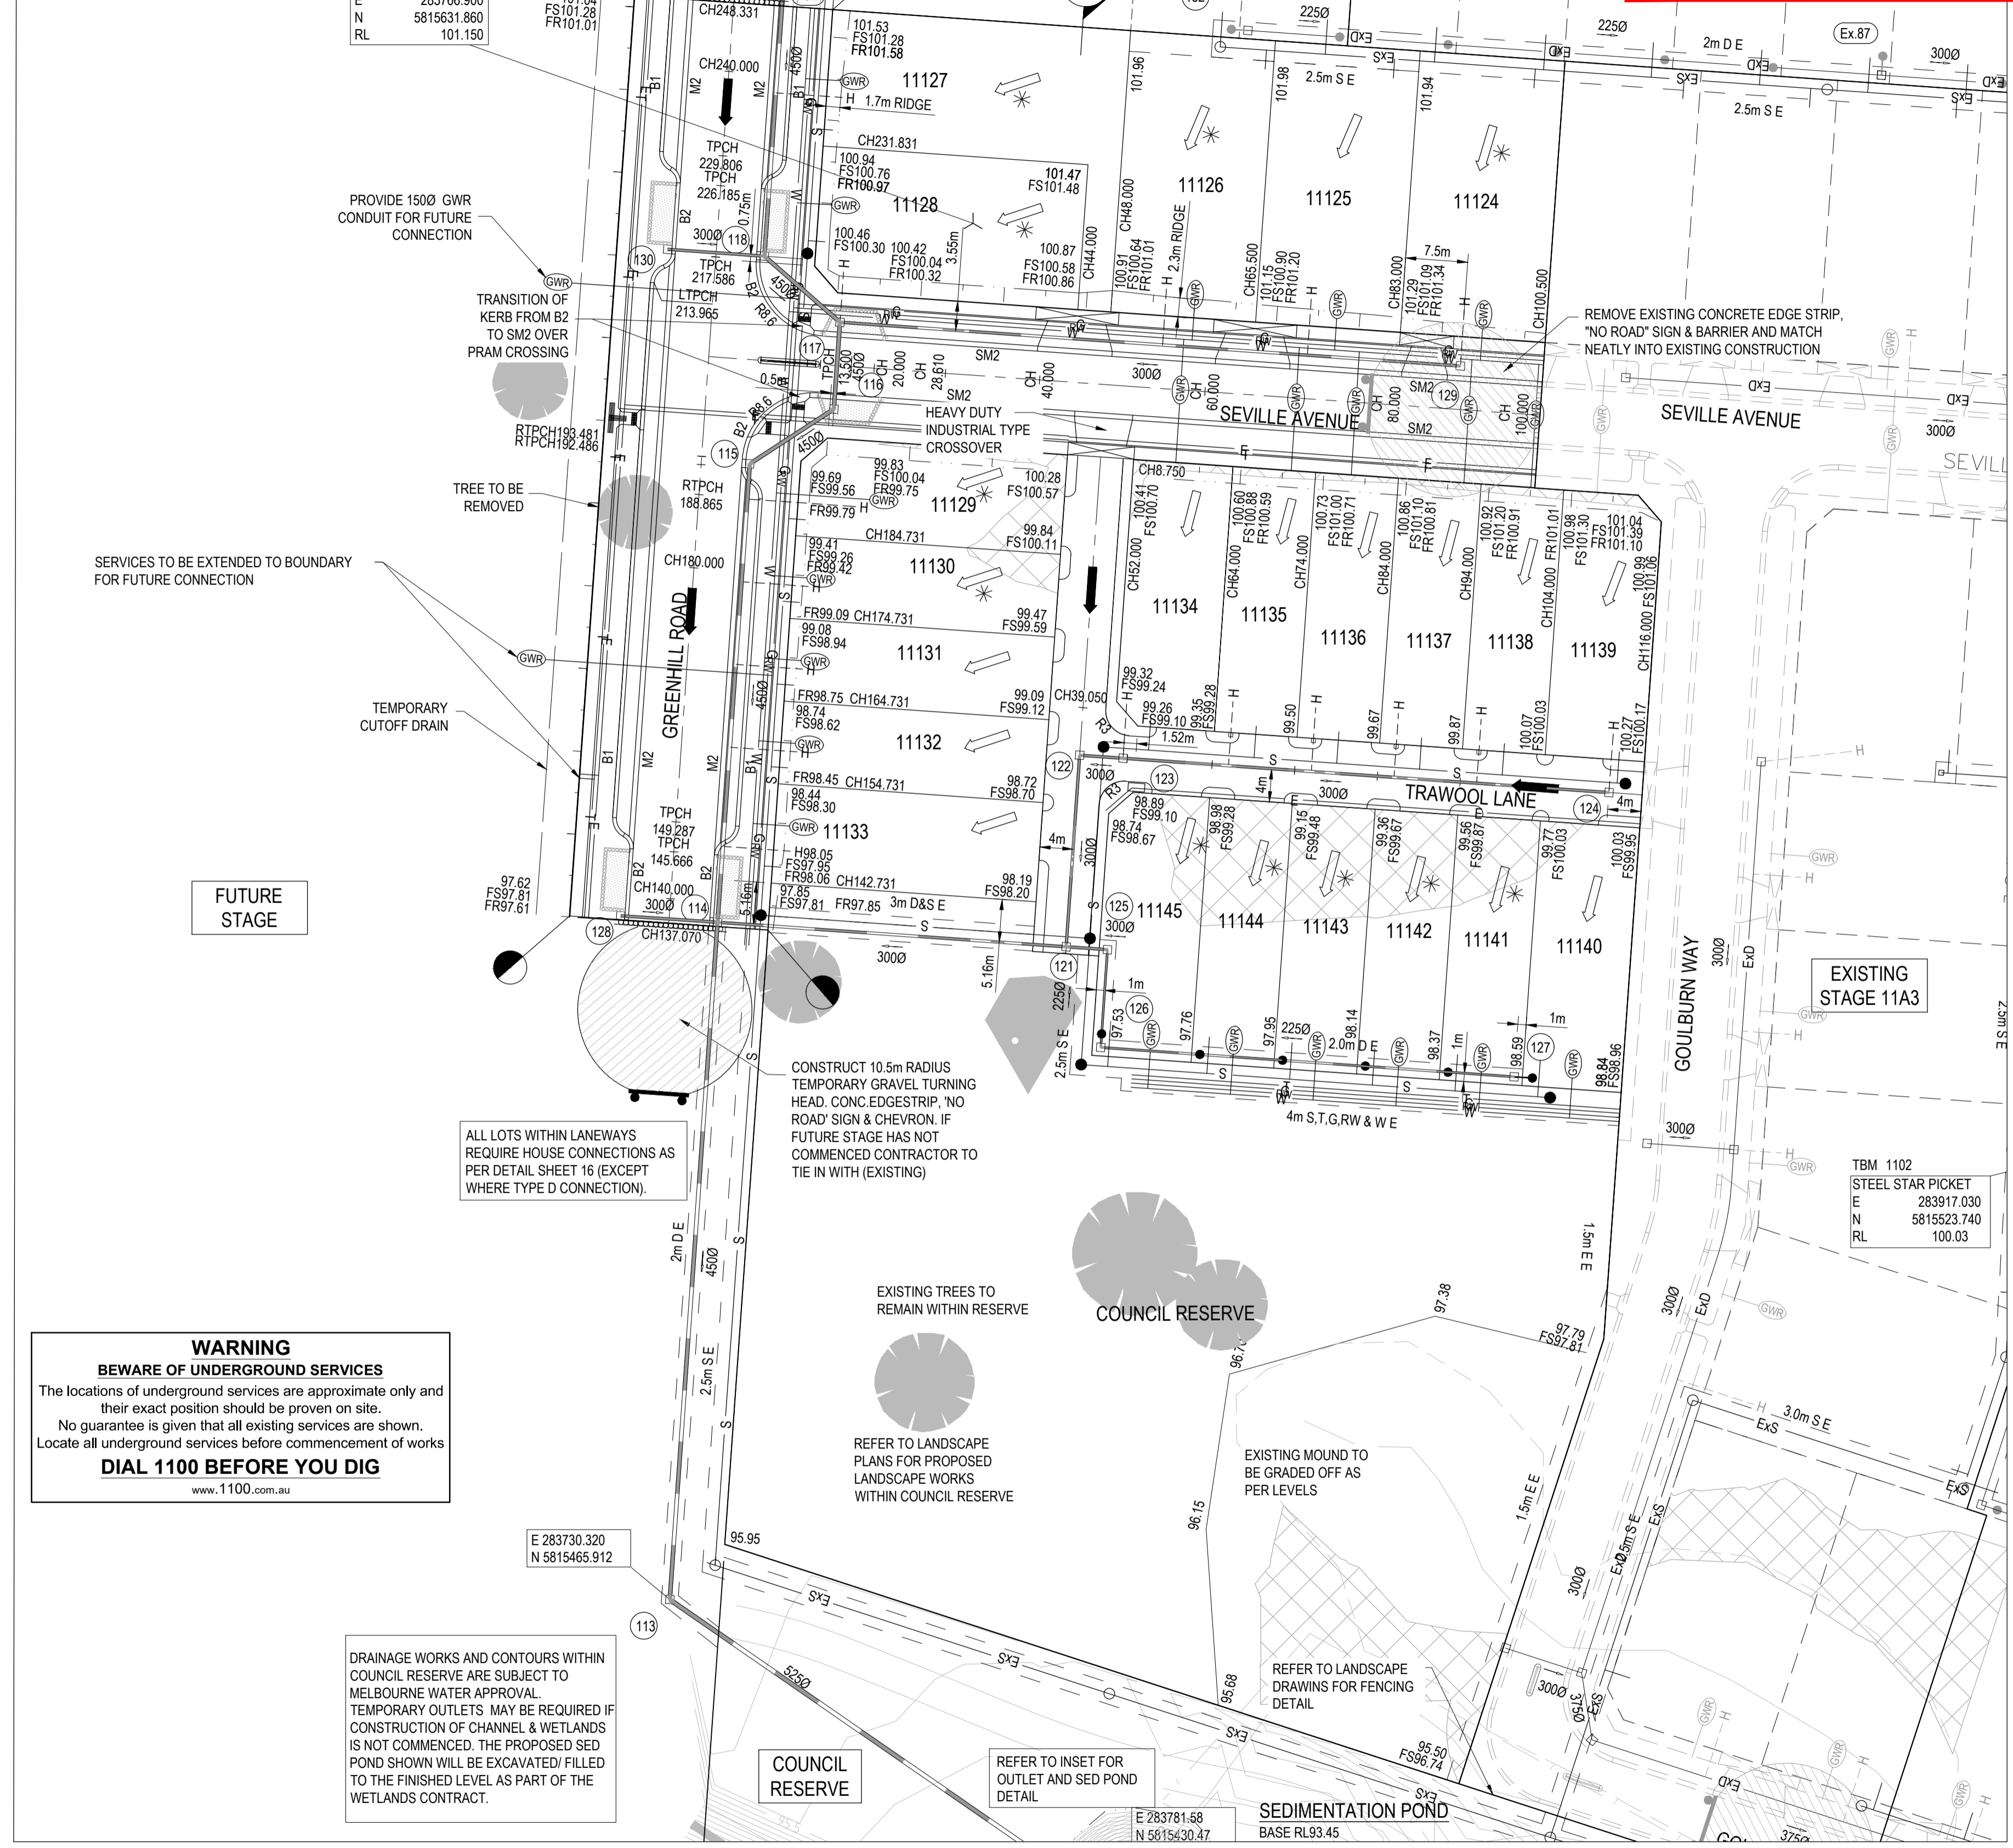


**NOTE:**  
THIS DRAWING HAS BEEN CONVERTED FROM SMEC DESIGN DRAWINGS TO ARCADIS CONSTRUCTION DRAWINGS AT THE REQUEST OF MELTON CITY COUNCIL. THE ORIGINAL PRESENTATION HAS NOT BEEN ALTERED IN ORDER TO MAINTAIN CONSISTENCY THROUGHOUT THE ENTIRE DRAWING PACKAGE.


**AS CONSTRUCTED RECORDS**  
THE OBJECTIVE OF THESE 'AS-CONSTRUCTED DRAWINGS' IS TO REFLECT ANY SIGNIFICANT CHANGES TO THE APPROVED CONSTRUCTION DRAWINGS AND PROVIDE COUNCIL WITH A RECORD OF DESIGN INTENT. ANY LEVELS AND COORDINATES SHOWN ON THESE PLANS ARE SUBJECT TO SURVEY AND WILL DIFFER. ARCADIS ACCEPTS NO RESPONSIBILITY FOR LOSS OR DAMAGES RESULTING FROM THE INTERPRETATION OF THESE DRAWINGS. ALL DETAILS AND ASSETS MUST BE ASCERTAINED AND VERIFIED BY THE END USER.

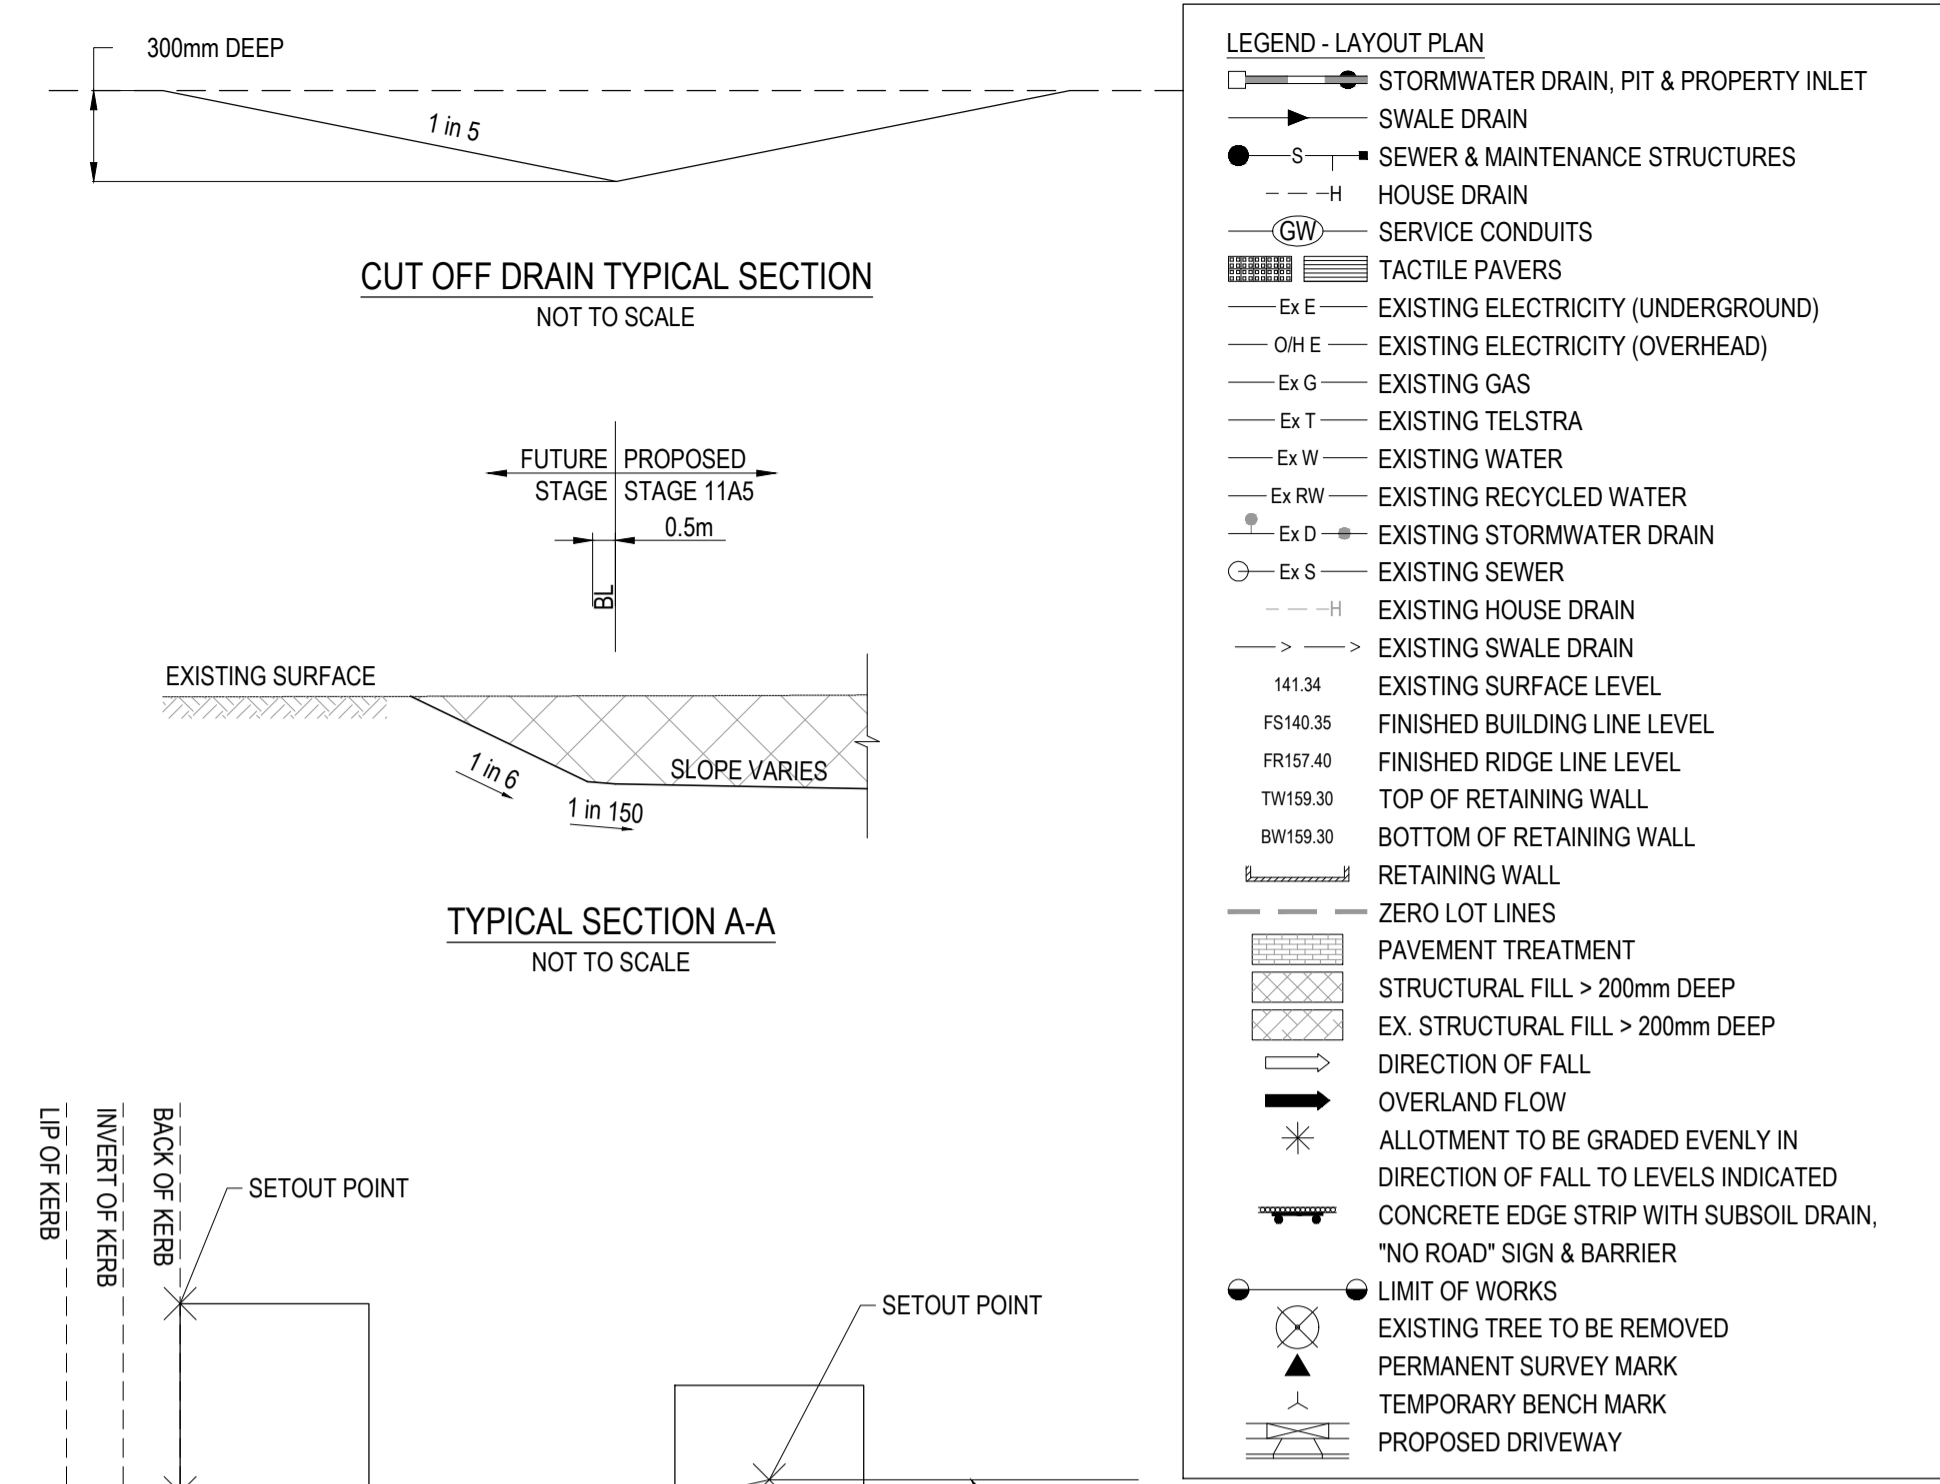


ROAD NAME	ROAD CLASSIFICATION	RESERVE WIDTH (m)	ROAD WIDTH (m)			KERB TYPE		VERGE WIDTH (m)	
			LIP to LIP	INV to INV	BACK to BACK	NTH/WEST	STH/EAST	NTH/WEST	STH/EAST
GREENHILL ROAD	CS1	24.00	9.80	10.40	11.00	B2/M2	B2/M2	6.65	6.65
TRAWOOL LANE	AL	8.00	5.50	-	-	-	-	1.25	1.25
SEVILLE AVENUE	AS2	17.60	6.90	7.50	8.10	SM2	SM2	4.75	4.75

ROAD NAME	SIDE	GAS		RECYCLED WATER		WATER		ELECTRICITY		TELSTRA	
		OFFSET (m)	DEPTH (m)	OFFSET (m)	DEPTH (m)	OFFSET (m)	DEPTH (m)	OFFSET (m)	DEPTH (m)	OFFSET (m)	DEPTH (m)
GREENHILL ROAD	EAST	1.70	-	2.20	-	2.70	-	WEST	2.30	WEST	1.80
SEVILLE AVENUE	NORTH	1.70	-	2.20	-	2.70	-	SOUTH	2.30	SOUTH	1.80

Issue	Description	By	Ckd	PM	Date
04	AS CONSTRUCTED	RT	ZS	JM	30.07.20
03	GREENHILL ROAD SERVICES LAYOUT REVISED	SH	ZS	JM	15.04.19
02	TACTILE LAYOUT UPDATED	HM	ZS	JM	08.03.19
01	ISSUED FOR CONSTRUCTION	RT	ZS	JM	08.02.19

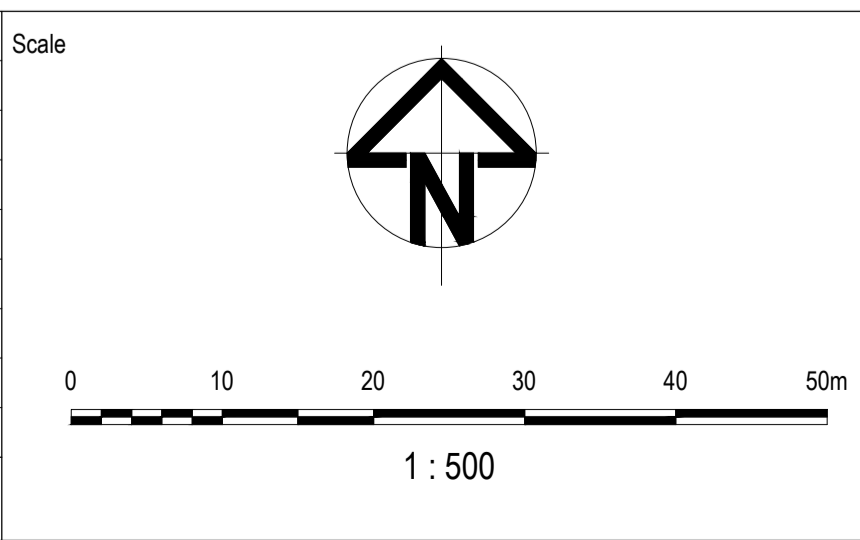

Surveyor: \_\_\_\_\_  
Client: \_\_\_\_\_  
Architect: \_\_\_\_\_  
Filename: 0520E-11A5-02C.dwg

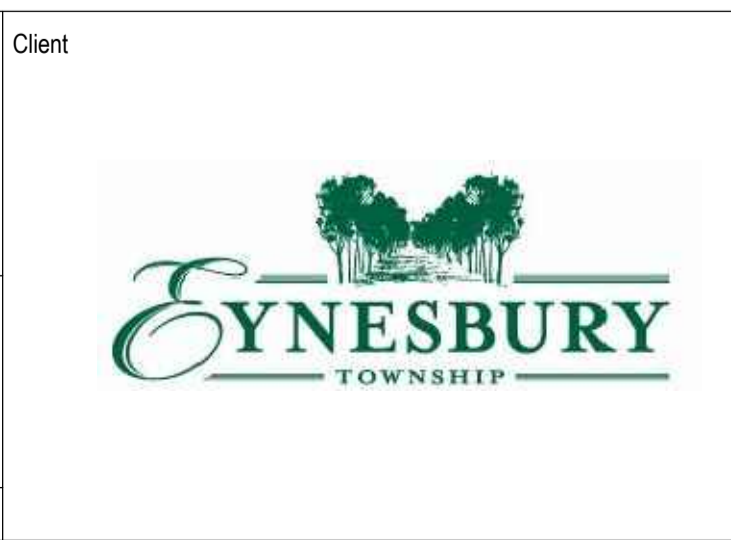

Status: **AS CONSTRUCTED**  
Approved: \_\_\_\_\_  
Scales: 1:500  
Original Issue Signatures: \_\_\_\_\_  
Original Size: **A1**  
Height Datum: **AHD**  
Grid: **MGA**

Project: **EYNEBURY TOWNSHIP STAGE 11A5 CITY OF MELTON ROADWORKS AND DRAINAGE**  
Title: **LAYOUT PLAN - 1**

