
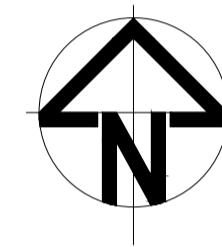


# EYNESBURY TOWNSHIP

## STAGE 8C CIVIL WORKS

### MELTON CITY COUNCIL

DRAWING SCHEDULE	
DRAWING No.	DRAWING DESCRIPTION
C-08C-001	COVER SHEET, LOCALITY PLAN AND DRAWING SCHEDULE
C-08C-002	GENERAL NOTES
C-08C-100	EARTHWORKS LAYOUT PLAN
C-08C-200	SETOUT PLAN
C-08C-220	ROADWORKS AND DRAINAGE LAYOUT PLAN
C-08C-240	LOGAN STREET ROAD LONGITUDINAL & CROSS SECTIONS
C-08C-241	CROWLANDS CIRCUIT ROAD LONGITUDINAL SECTIONS
C-08C-242	CROWLANDS CIRCUIT ROAD CROSS SECTIONS
C-08C-243	AMPHITHEATRE STREET ROAD LONGITUDINAL & CROSS SECTIONS
C-08C-244	NUGGETTY LANE ROAD LONGITUDINAL & CROSS SECTIONS
C-08C-260	INTERSECTION DETAILS SHEET 1 OF 2
C-08C-261	INTERSECTION DETAILS SHEET 2 OF 2
C-08C-270	SWALE DETAILS SHEET 1 OF 2
C-08C-271	SWALE DETAILS SHEET 2 OF 2
C-08C-280	TYPICAL DETAILS SHEET 1 OF 2
C-08C-281	TYPICAL DETAILS SHEET 2 OF 2
C-08C-290	LINEMARKING AND SIGNAGE PLAN
C-08C-300	STORMWATER DRAINAGE LONGITUDINAL SECTIONS SHEET 1 OF 2
C-08C-301	STORMWATER DRAINAGE LONGITUDINAL SECTIONS SHEET 2 OF 2
C-08C-320	STORMWATER DRAINAGE PIT SCHEDULE
C-08C-350	STORMWATER DRAINAGE Q5 CATCHMENT PLAN
C-08C-351	STORMWATER DRAINAGE Q100 CATCHMENT PLAN
C-08C-360	STORMWATER DRAINAGE CALCULATION TABLES SHEET 1 OF 2
C-08C-361	STORMWATER DRAINAGE CALCULATION TABLES SHEET 2 OF 2
C-08C-700	RETAINING WALL LAYOUT PLAN SHEET 1 OF 2
C-08C-701	RETAINING WALL LAYOUT PLAN SHEET 2 OF 2
C-08C-710	PASSIVE IRRIGATION LAYOUT PLAN
C-08C-711	PASSIVE IRRIGATION DETAILS

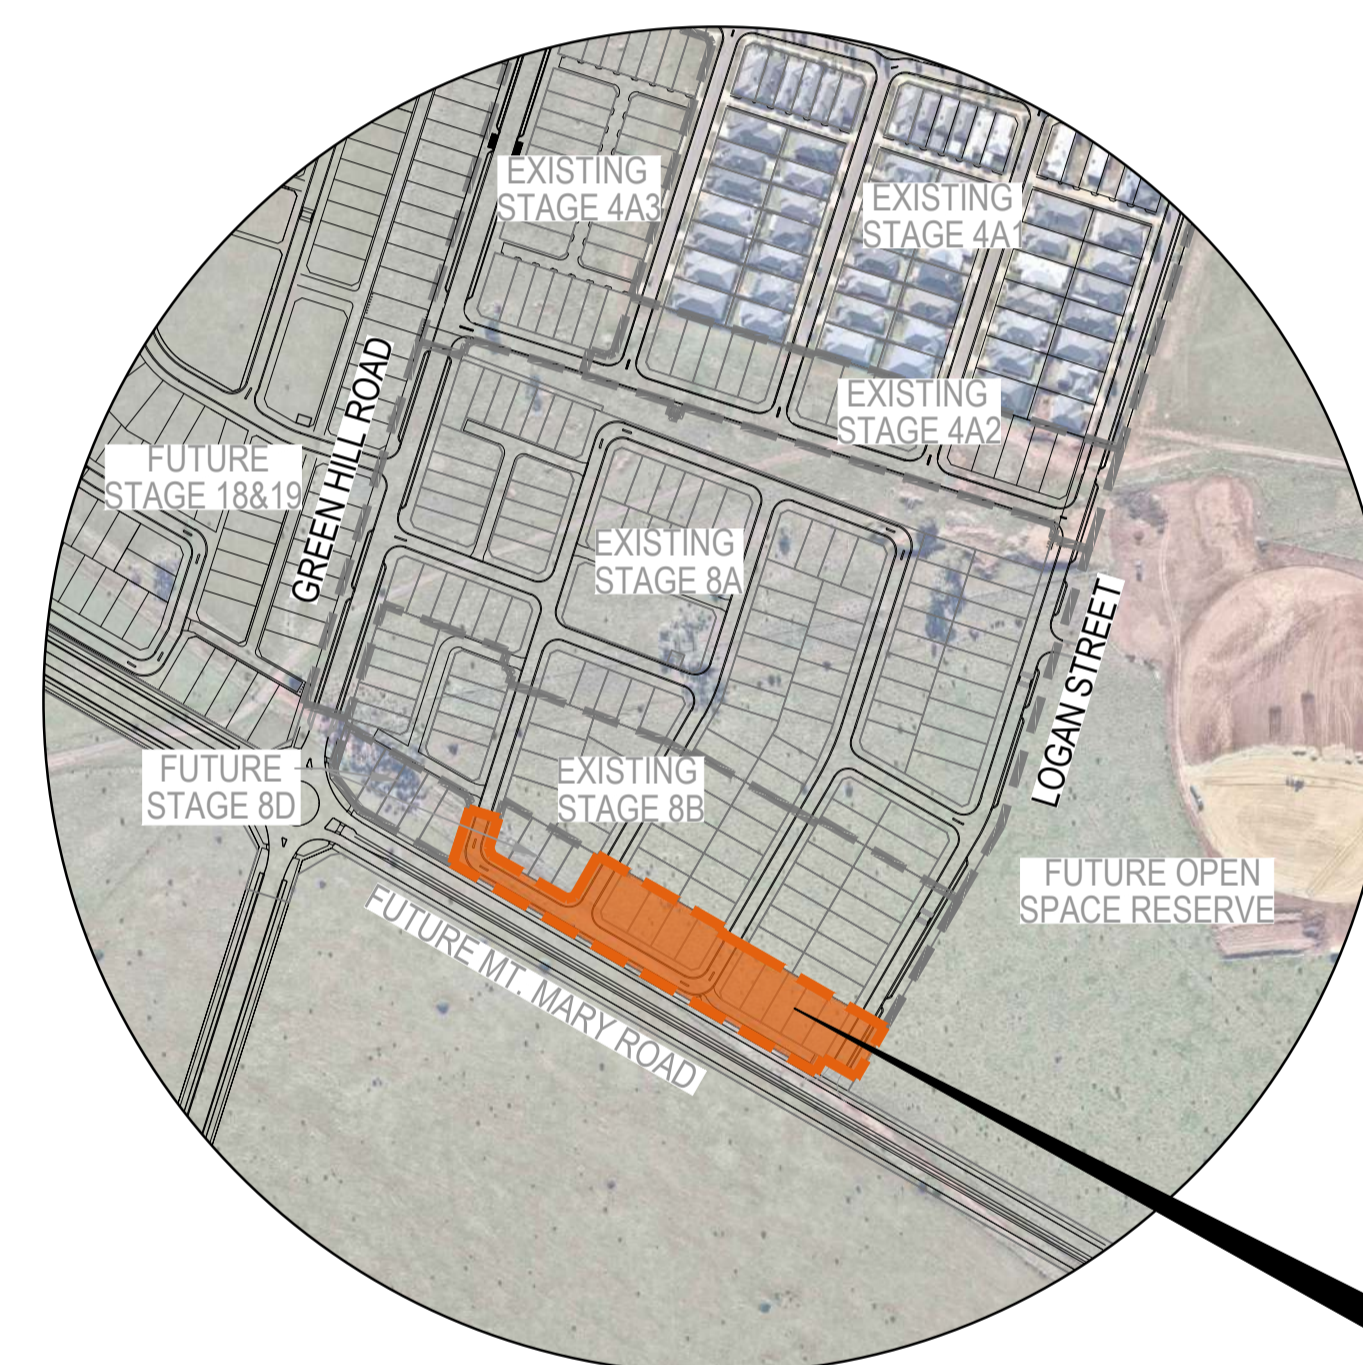

LOCALITY PLAN  
N.T.S  
MELWAY REF 110 B10

LOCATION OF SITE OF WORKS

LEVEL DATUM
PSM 31
RL 88.74

REAL PROPERTY DESCRIPTION
LOT S83 ON PS543210K
PARISH OF MOORADORANOOK
LOCAL AUTHORITY - MELTON CITY COUNCIL

nearmap IMAGERY EXTRACTED FROM nearmap.com

**DISCLAIMER**  
THIS MAP HAS BEEN PREPARED USING nearmap.com IMAGERY. THIS DATA IS NOT GUARANTEED TO BE FREE FROM ERROR OR OMISSION. THEREFORE ARCADIS AND ITS EMPLOYEES DISCLAIM LIABILITY OF ANY ACT DONE OR OMISSION MADE ON THE INFORMATION CONTAINED IN THIS DATA AND ANY CONSEQUENCES OF SUCH ACTS OR OMISSIONS. THIS DRAWING IS PROVIDED FOR THE INFORMATION OF THE PERSON OR ORGANISATION TO WHOM ARCADIS PROVIDES IT. IT MAY NOT BE PROVIDED TO, OR USED BY, ANY OTHER PERSON WITHOUT ARCADIS PRIOR WRITTEN CONSENT.

#### AS CONSTRUCTED RECORDS

THE OBJECTIVE OF THESE 'AS-CONSTRUCTED DRAWINGS' IS TO REFLECT ANY SIGNIFICANT CHANGES TO THE APPROVED CONSTRUCTION DRAWINGS AND PROVIDE COUNCIL WITH A RECORD OF DESIGN INTENT. ANY LEVELS AND COORDINATES SHOWN ON THESE PLANS ARE SUBJECT TO SURVEY AND WILL DIFFER. ARCADIS ACCEPT NO RESPONSIBILITY FOR LOSS OR DAMAGES RESULTING FROM THE INTERPRETATION OF THESE DRAWINGS. ALL DETAILS AND ASSETS MUST BE ASCERTAINED AND VERIFIED BY THE END USER.

Issue	Description	By	Ckd	PM	Date
B	AS CONSTRUCTED	WB	ZS	SE	07.10.21
A	ISSUED FOR CONSTRUCTION	WB	ZS	SE	04.12.20
03	UPDATES TO ADDRESS COUNCIL COMMENTS	HP	ZS	SE	19.08.20
02	ISSUED FOR APPROVAL	WB	ZS	SE	10.07.20
01	ISSUED TO CLIENT FOR REVIEW	WB	ZS	SE	07.11.19

Scale
Planner
Client
Status
Project
Title
Drawing No.
Project No.
Issue

Planner: **RD RobertsDay** *planning.design.place*

Client: **RESIMAX GROUP**

Filename C-08c-001-10029435-Cover.dwg

Status: **AS CONSTRUCTED**

Verifier: **Z.STROGUSZ**

Scales: **NTS**

Original Issue Signatures:  
Drawn: **W.BUMAGAT**  
Designed: **J.ROCK**

Original Size: **A1**

Height Datum: **AHD**

Project Manager: **S.EISEL**

Grid: **MGA**

© Copyright reserved

Project: **EYNESBURY TOWNSHIP STAGE 8C**

Title: **COVER SHEET, LOCALITY PLAN AND DRAWING SCHEDULE**

Drawing No. **C-08C-001**

Project No. **10029435**

Issue **B**

**ARCADIS**

Arcadis Australia Pacific Pty Limited  
Level 32, 140 William Street  
Melbourne VIC 3000  
ABN 76 104 485 289  
Tel No: +61 3 8623 4000  
www.arcadis.com






**LEGEND**

- 5.0 — EXISTING SURFACE CONTOURS
- 5.0 — PROPOSED SURFACE CONTOURS
- PROPOSED KERB & CHANNEL
- PROPOSED STAGE BOUNDARY
- EXISTING STAGE BOUNDARY
- PROPOSED RIDGE LINE
- ⊗ EXISTING TREES TO BE RETAINED
- ⊗ EXISTING TREES TO BE REMOVED

**NOTE:**  
FOR GENERAL NOTES, REFER TO DRAWING No. C-08C-002.

**CUT FILL DEPTH RANGE**

Lower_value	Upper_value	Colour
-1.4	-1.3	Red
-1.3	-1.2	Red
-1.2	-1.1	Red
-1.1	-1	Red
-1	-0.9	Red
-0.9	-0.8	Red
-0.8	-0.7	Red
-0.7	-0.6	Red
-0.6	-0.5	Red
-0.5	-0.4	Red
-0.4	-0.3	Red
-0.3	-0.2	Red
-0.2	-0.1	Red
-0.1	0.00	Red
0.000	0.1	Light Green
0.1	0.2	Light Green
0.2	0.3	Light Green
0.3	0.4	Light Green
0.4	0.5	Light Green
0.5	0.6	Light Green
0.6	0.7	Light Green
0.7	0.8	Light Green
0.8	0.9	Light Green
0.9	1	Light Green
1	1.1	Light Green
1.1	1.2	Light Green
1.2	1.3	Light Green
1.3	1.4	Light Green

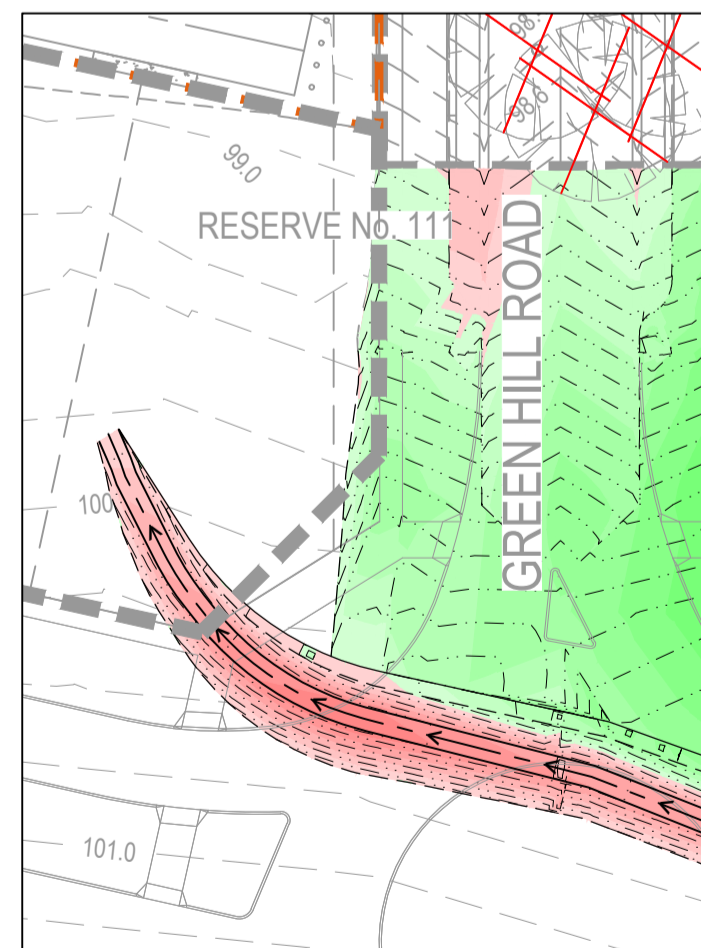


INSET - A

**AS CONSTRUCTED RECORDS**

THE OBJECTIVE OF THESE 'AS-CONSTRUCTED DRAWINGS' IS TO REFLECT ANY SIGNIFICANT CHANGES TO THE APPROVED CONSTRUCTION DRAWINGS AND PROVIDE COUNCIL WITH A RECORD OF DESIGN INTENT. ANY LEVELS AND COORDINATES SHOWN ON THESE PLANS ARE SUBJECT TO SURVEY AND WILL DIFFER. ARCADIS ACCEPTS NO RESPONSIBILITY FOR LOSS OR DAMAGES RESULTING FROM THE INTERPRETATION OF THESE DRAWINGS. ALL DETAILS AND ASSETS MUST BE ASCERTAINED AND VERIFIED BY THE END USER.

Issue	Description	By	Ckd	PM	Date
C	AS CONSTRUCTED	WB	ZS	SE	07.10.21
B	UPDATES TO LOT 8138	WB	ZS	SE	12.08.21
A	ISSUED FOR CONSTRUCTION	WB	ZS	SE	04.12.20
04	UPDATES TO ADDRESS COUNCIL COMMENTS	HP	ZS	SE	19.08.20
03	UPDATES TO ADDRESS COUNCIL COMMENTS	WB	ZS	SE	03.08.20
02	ISSUED FOR APPROVAL	WB	ZS	SE	10.07.20
01	ISSUED TO CLIENT FOR REVIEW	WB	ZS	SE	07.11.19

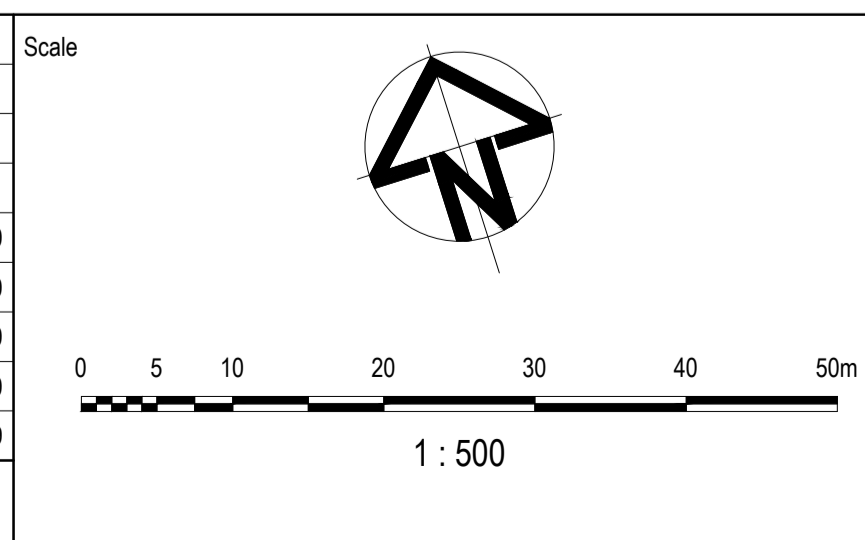

Planner

Client


Filename C-08c-100-10029435-EarthworksPlan.dwg

Status	AS CONSTRUCTED	
Verifier	Z.STROGUSZ	
Scales	1:500	Original Issue Signatures
	Original Size	Drawn W.BUMAGAT
Height Datum	AHD	Designed J.ROCK
Grid	MGA	Project Manager S.EISEL
		© Copyright reserved

Project	EYNESBURY TOWNSHIP STAGE 8C
Title	EARTHWORKS LAYOUT PLAN

Arcadis Australia Pacific Pty Limited  
Level 32, 140 William Street  
Melbourne VIC 3000  
ABN 76 104 485 289  
Tel No: +61 3 8623 4000  
www.arcadis.com

Drawing No.	Project No.	Issue
C-08C-100	10029435	C

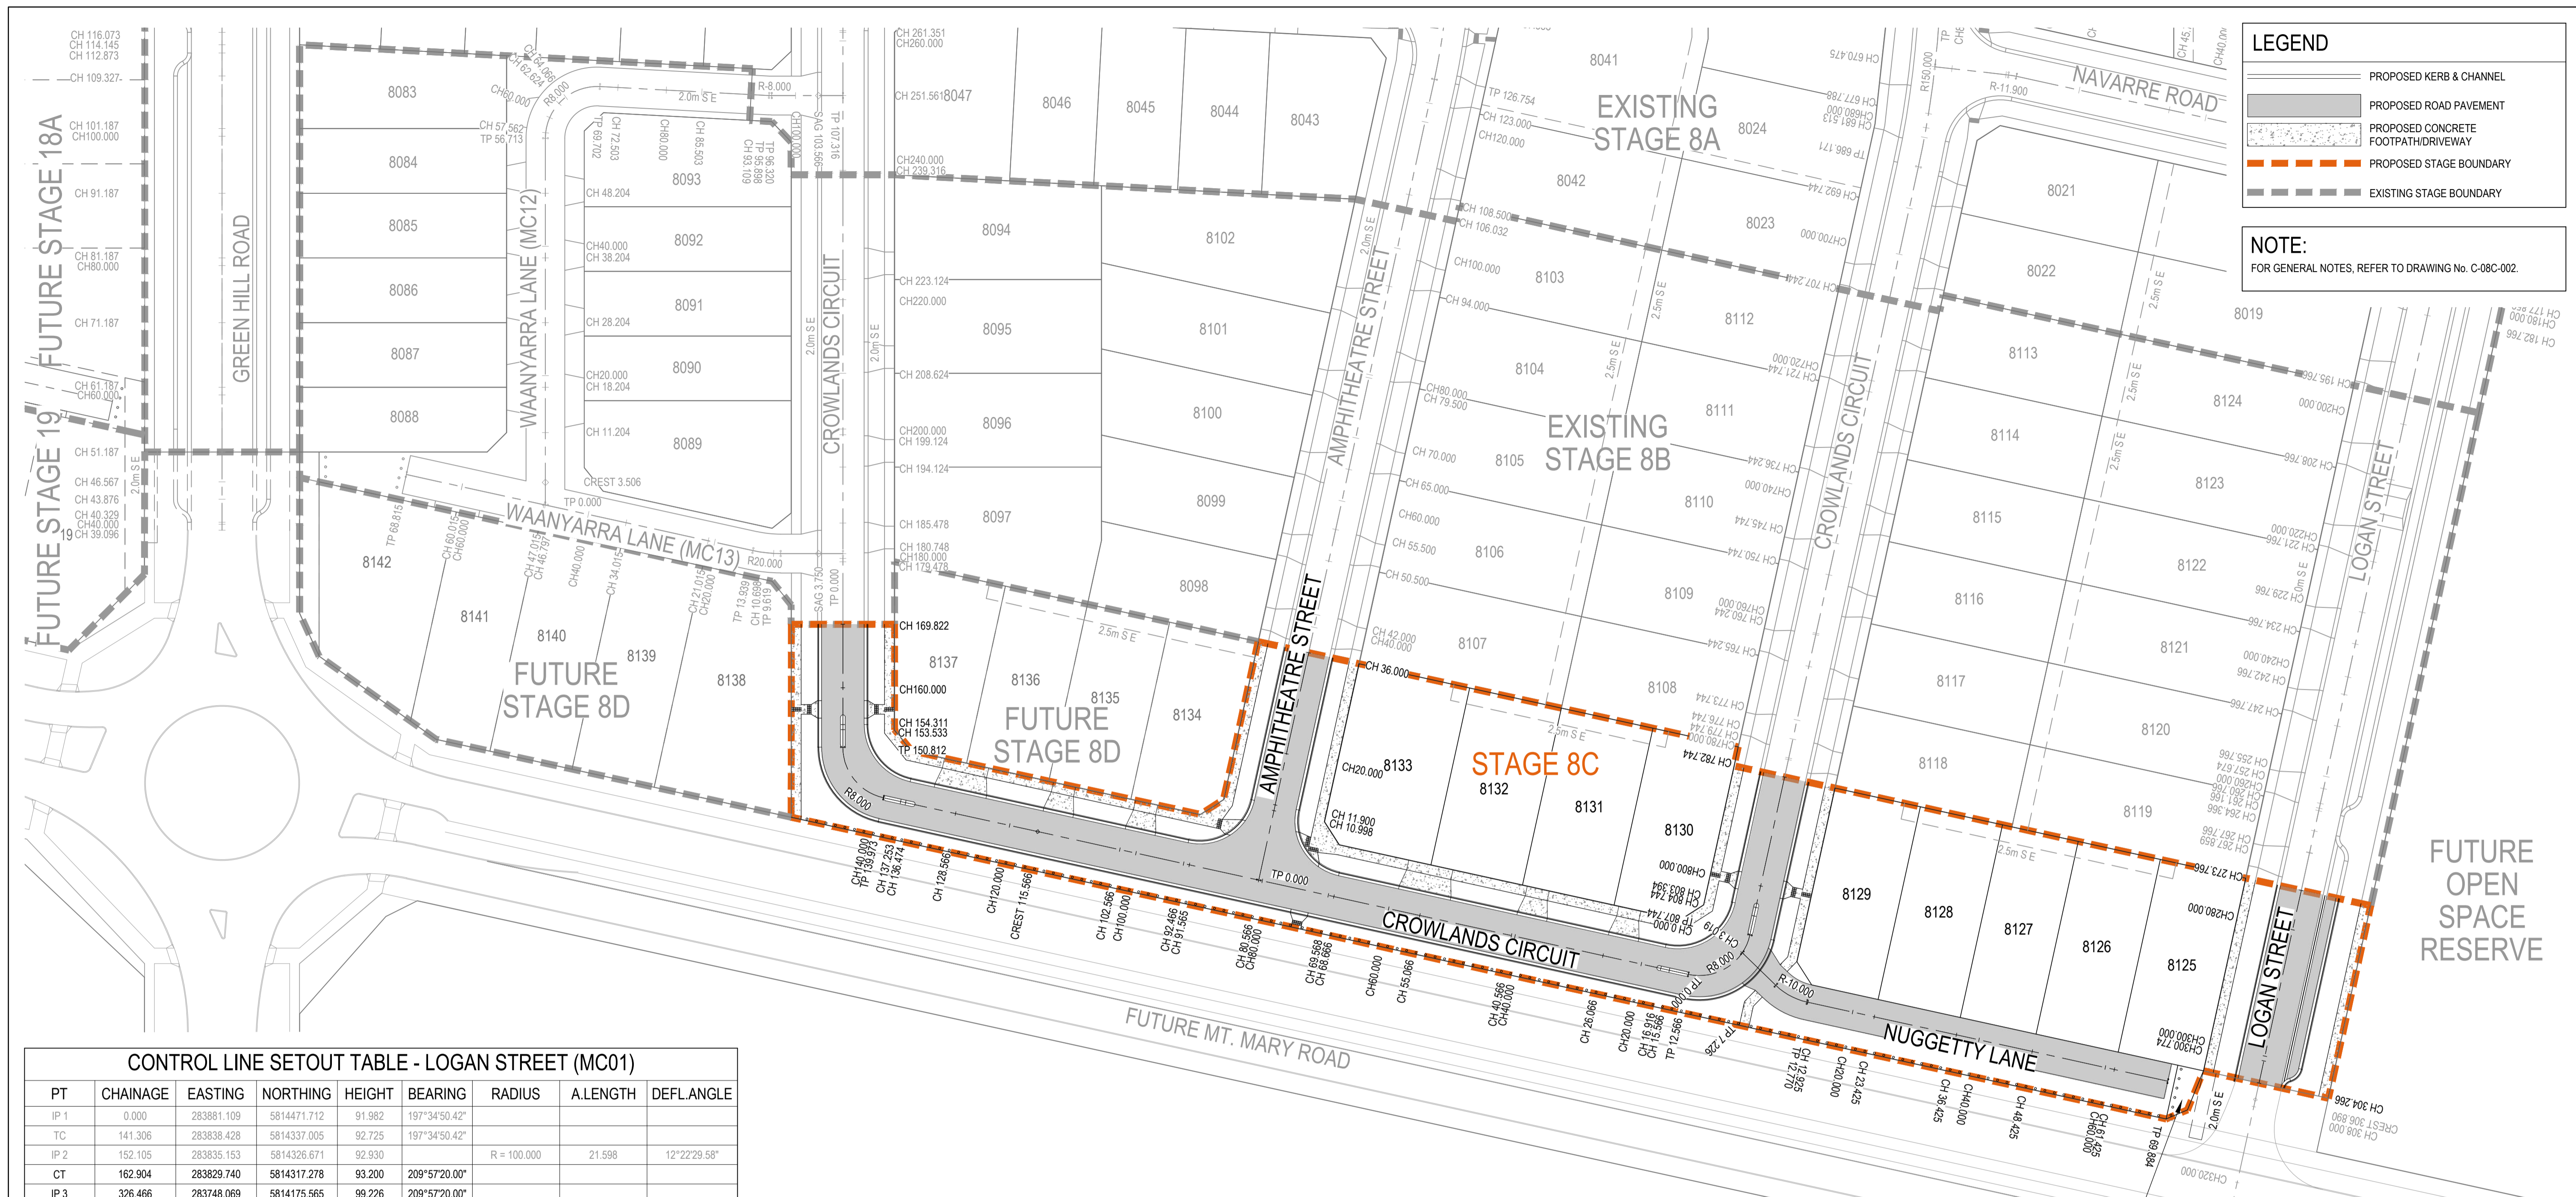

**LEGEND**

- PROPOSED KERB & CHANNEL
- PROPOSED ROAD PAVEMENT
- PROPOSED CONCRETE FOOTPATH/DRIVEWAY
- PROPOSED STAGE BOUNDARY
- EXISTING STAGE BOUNDARY

**NOTE:**  
FOR GENERAL NOTES, REFER TO DRAWING No. C-08C-002.

**CONTROL LINE SETOUT TABLE - LOGAN STREET (MC01)**

PT	CHAINAGE	EASTING	NORTHING	HEIGHT	BEARING	RADIUS	A.LENGTH	DEFL.ANGLE
IP 1	0.000	283881.109	5814471.712	91.982	197°34'50.42"			
TC	141.306	283838.428	5814337.005	92.725	197°34'50.42"			
IP 2	152.105	283835.153	5814326.671	92.930		R = 100.000	21.598	12°22'29.58"
CT	162.904	283829.740	5814317.278	93.200	209°57'20.00"			
IP 3	326.466	283748.069	5814175.565	99.226	209°57'20.00"			

**CONTROL LINE SETOUT TABLE - CROWLANDS CIRCUIT (MC03)**

PT	CHAINAGE	EASTING	NORTHING	HEIGHT	BEARING	RADIUS	A.LENGTH	DEFL.ANGLE
IP 1	0.000	283691.028	5814240.410	99.369				
IP 2	6.283	283687.033	5814233.479	99.463		R = 8.000	12.566	90°00'00.00"
CT	12.566	283680.102	5814237.473	99.557	299°57'20.00"			
TC	139.973	283569.715	5814301.091	99.936	299°57'20.00"			
IP 3	145.393	283564.139	5814304.304	99.801		R = 8.000	10.839	77°37'31.64"
IP 4	150.812	283566.083	5814310.439	99.665				
IP 5	377.723	283634.621	5814526.752	94.975				
IP 6	384.218	283637.169	5814534.792	94.923		R = 8.000	12.989	93°01'49.02"
IP 7	390.712	283645.063	5814531.824	94.871				
TC	544.727	283789.223	5814477.616	93.471	110°36'27.16"			
IP 8	550.799	283796.326	5814474.945	93.501		R = 8.000	12.144	86°58'23.27"
CT	556.871	283794.034	5814467.711	93.531	197°34'50.42"			
IP 9	653.773	283764.765	5814375.335	94.016				
IP 10	669.972	283759.853	5814359.832	94.097		R = 150.000	32.398	12°22'30.90"
IP 11	686.171	283751.732	5814345.742	94.224				
IP 12	807.744	283691.028	5814240.410	99.369	209°57'20.00"			

**CONTROL LINE SETOUT TABLE - AMPHITRE STREET (MC04)**

PT	CHAINAGE	EASTING	NORTHING	HEIGHT	BEARING	RADIUS	A.LENGTH	DEFL.ANGLE
IP 1	0.000	283621.186	5814271.428	100.032	29°57'20.00"			
TC	126.754	283684.478	5814381.249	95.129	29°57'20.00"			
IP 2	137.553	283689.891	5814390.642	94.967		R = -100.000	21.598	12°22'29.58"
CT	148.353	283693.166	5814400.977	94.805	17°34'50.42"			
TC	241.498	283721.300	5814489.772	94.214	17°34'50.42"			
IP 3	241.812	283721.395	5814490.072	94.205		R = 11.900	0.629	3°01'36.73"
CT	242.126	283721.506	5814490.366	94.197	20°36'27.16"			
IP 4	254.026	283725.694	5814501.504	94.087	20°36'27.16"			


**CONTROL LINE SETOUT TABLE - NUGGETTY LANE (MC11)**

PT	CHAINAGE	EASTING	NORTHING	HEIGHT	BEARING	RADIUS	A.LENGTH	DEFL.ANGLE
IP 1	0.000	283689.068	5814238.137	99.414	151°43'11.57"			
TC	7.226	283692.492	5814231.773	99.597	151°43'11.57"			
IP 2	9.998	283693.840	5814229.268	99.639		R = -10.000	5.544	31°45'51.58"
CT	12.770	283696.305	5814227.847	99.680	119°57'20.00"			
IP 3	69.884	283745.789	5814199.328	100.032	119°57'20.00"			

**AS CONSTRUCTED RECORDS**

THE OBJECTIVE OF THESE 'AS-CONSTRUCTED DRAWINGS' IS TO REFLECT ANY SIGNIFICANT CHANGES TO THE APPROVED CONSTRUCTION DRAWINGS AND PROVIDE COUNCIL WITH A RECORD OF DESIGN INTENT. ANY LEVELS AND COORDINATES SHOWN ON THESE PLANS ARE SUBJECT TO SURVEY AND WILL DIFFER. ARCADIS ACCEPTS NO RESPONSIBILITY FOR LOSS OR DAMAGES RESULTING FROM THE INTERPRETATION OF THESE DRAWINGS. ALL DETAILS AND ASSETS MUST BE ASCERTAINED AND VERIFIED BY THE END USER.

Issue	Description	By	Ckd	PM	Date
A	AS CONSTRUCTED	WB	ZS	SE	07.10.21
B	ISSUED FOR CONSTRUCTION	WB	ZS	SE	04.12.20
04	UPDATES TO ADDRESS COUNCIL COMMENTS	HP	ZS	SE	19.08.20
03	UPDATES TO ADDRESS COUNCIL COMMENTS	WB	ZS	SE	03.08.20
02	ISSUED FOR APPROVAL	WB	ZS	SE	10.07.20
01	ISSUED TO CLIENT FOR REVIEW	WB	ZS	SE	07.11.19

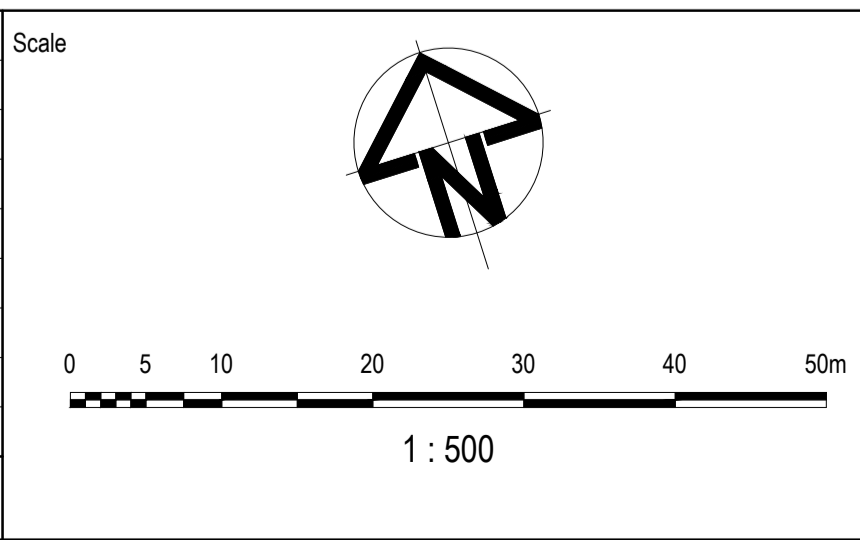

Planner

Client

Filename C-08c-200-10029435-Setout.dwg

Status	AS CONSTRUCTED	
Verifier	Z.STROGUSZ	
Scales	1:500	Original Issue Signatures
Original Size	A1	Drawn W.BUMAGAT
Height Datum	AHD	Designed J.ROCK
Grid	MGA	Project Manager S.EISEL
		© Copyright reserved

Project


EYNEBURY TOWNSHIP  
STAGE 8C

Title

SETOUT PLAN


Arcadis Australia Pacific Pty Limited  
Level 32, 140 William Street  
Melbourne VIC 3000  
ABN 76 104 485 289  
Tel No: +61 3 8623 4000  
www.arcadis.com

Drawing No. C-08C-200  
Project No. 10029435  
Issue B

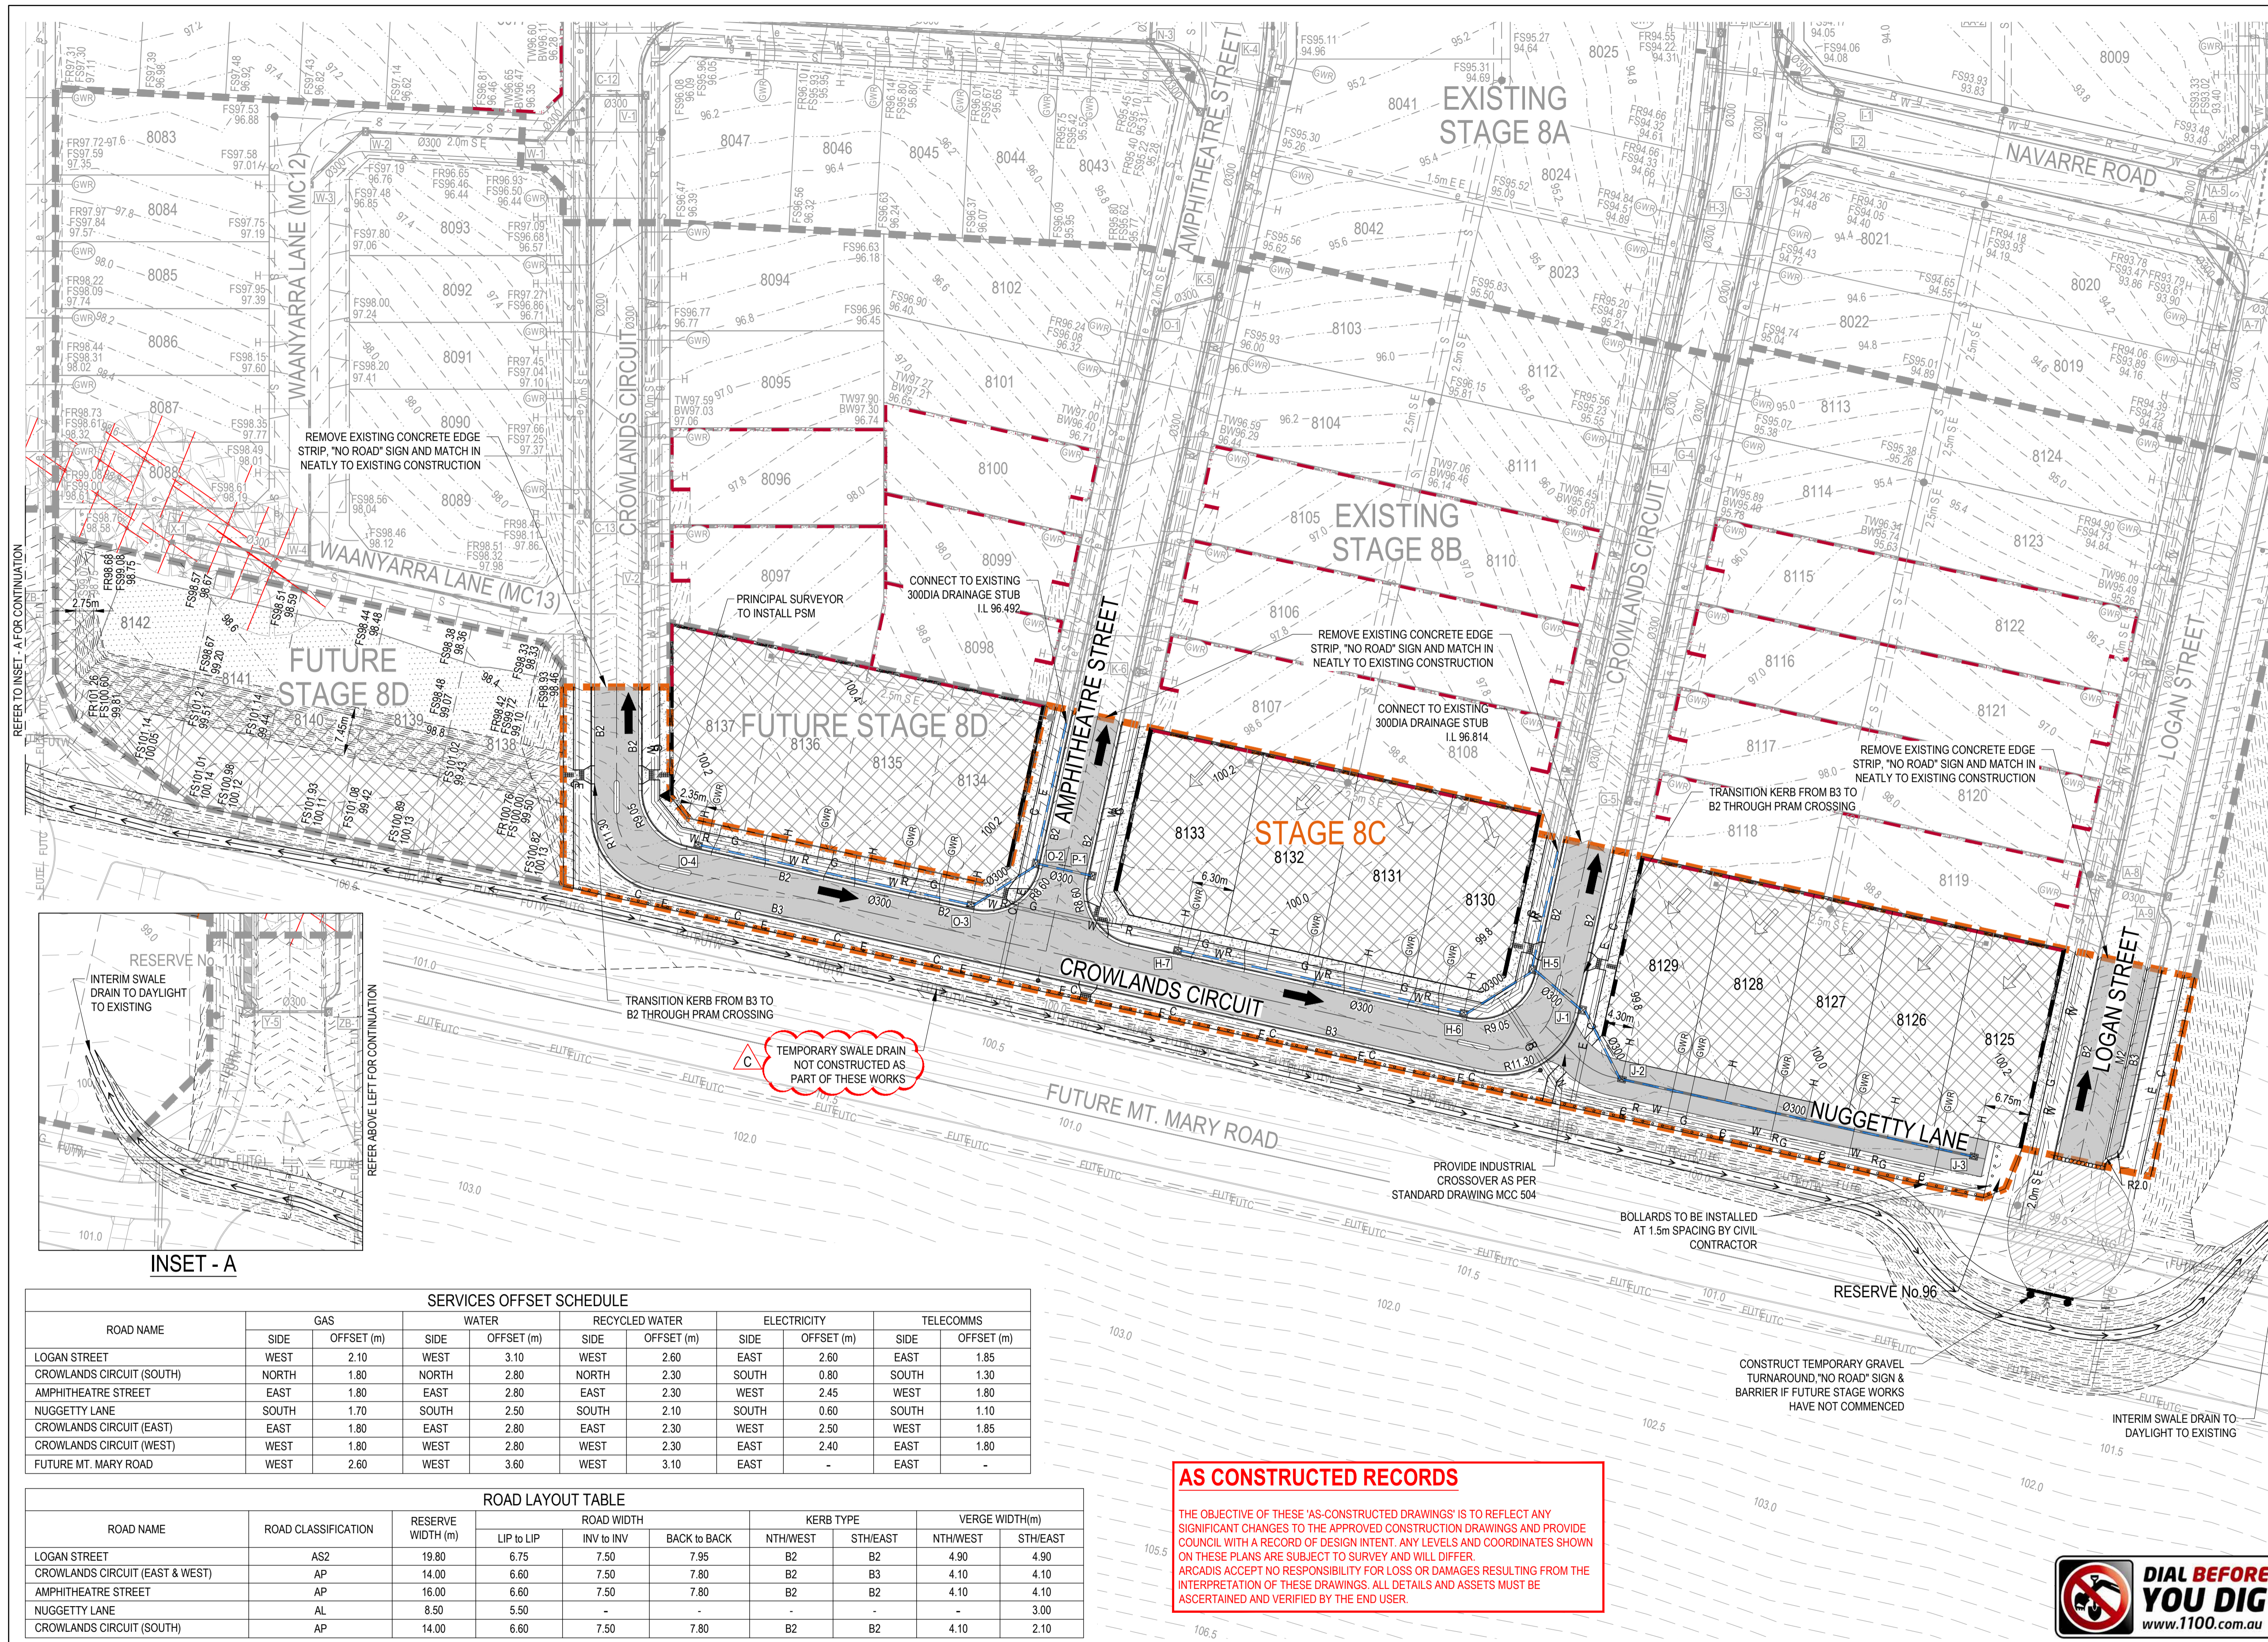

### LEGEND

- PROPOSED STAGE BOUNDARY
- PROPOSED DESIGN CONTOURS
- PROPOSED KERB & CHANNEL
- FALL OF ALLOTMENT
- DIRECTION OF OVERLAND FLOW
- PROPOSED STORMWATER DRAINAGE
- PROPOSED PIT LABEL
- PROPOSED SEWERAGE RETICULATION
- PROPOSED WATER RETICULATION
- PROPOSED RECYCLED WATER RETICULATION
- PROPOSED ELECTRICITY UNDER GROUND
- PROPOSED COMMUNICATIONS
- PROPOSED GAS RETICULATION
- PROPOSED DRAINAGE INLET
- PROPOSED CONCRETE FOOTPATH/DRIVEWAY
- PROPOSED ROAD PAVEMENT
- PROPOSED GAS / CLASS A / POTABLE WATER HOUSE CONNECTION
- BOLLARD
- FR98.86 FINISHED RIDGE LEVEL
- FS97.14 FINISHED SURFACE LEVEL
- TW98.16 TOP OF WALL LEVEL
- BW98.16 BOTTOM OF WALL LEVEL
- 93.750 EXISTING SURFACE LEVEL
- PROPOSED RETAINING WALL
- EXISTING RETAINING WALL
- PROPOSED RIDGE LINE
- PROPOSED TEMPORARY SWALE DRAIN
- CUT (> 0.2m)
- FILL (> 0.2m)
- EXISTING STAGE BOUNDARY
- EXISTING SURFACE CONTOURS
- EXISTING STORMWATER DRAINAGE
- S EXISTING SEWER RETICULATION
- W EXISTING WATER RETICULATION
- R EXISTING RECYCLED WATER RETICULATION
- e EXISTING ELECTRICITY UNDER GROUND
- c EXISTING COMMUNICATIONS
- g EXISTING GAS RETICULATION
- EXISTING TREES TO BE RETAINED
- EXISTING TREES TO BE REMOVED

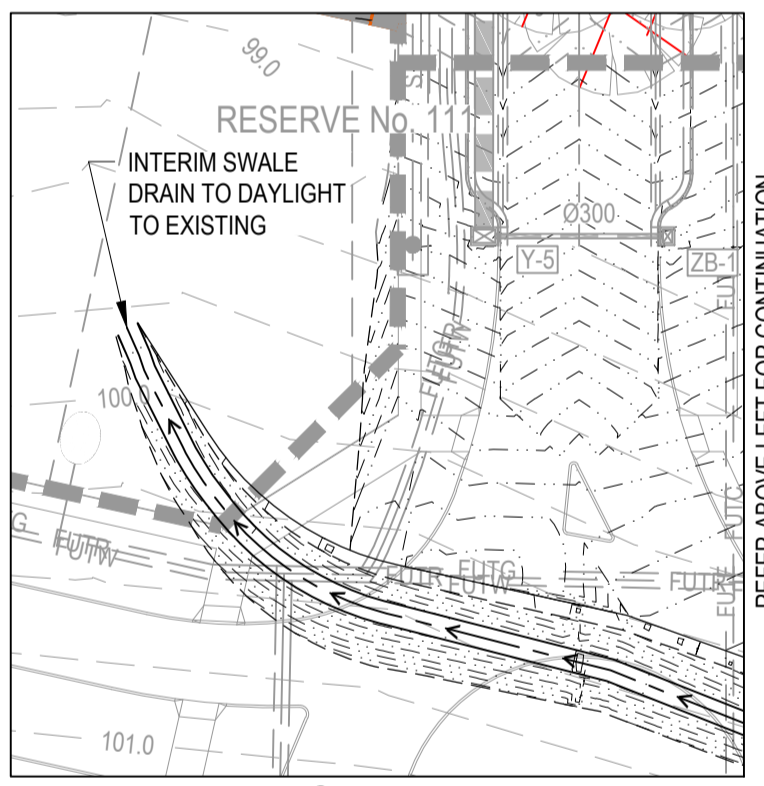

INSET - A

#### SERVICES OFFSET SCHEDULE

ROAD NAME	GAS		WATER		RECYCLED WATER		ELECTRICITY		TELECOMMS	
	SIDE	OFFSET (m)	SIDE	OFFSET (m)	SIDE	OFFSET (m)	SIDE	OFFSET (m)	SIDE	OFFSET (m)
LOGAN STREET	WEST	2.10	WEST	3.10	WEST	2.60	EAST	2.60	EAST	1.85
CROWLANDS CIRCUIT (SOUTH)	NORTH	1.80	NORTH	2.80	NORTH	2.30	SOUTH	0.80	SOUTH	1.30
AMPHITHEATRE STREET	EAST	1.80	EAST	2.80	EAST	2.30	WEST	2.45	WEST	1.80
NUGGETTY LANE	SOUTH	1.70	SOUTH	2.50	SOUTH	2.10	SOUTH	0.60	SOUTH	1.10
CROWLANDS CIRCUIT (EAST)	EAST	1.80	EAST	2.80	EAST	2.30	WEST	2.50	WEST	1.85
CROWLANDS CIRCUIT (WEST)	WEST	1.80	WEST	2.80	WEST	2.30	EAST	2.40	EAST	1.80
FUTURE MT. MARY ROAD	WEST	2.60	WEST	3.60	WEST	3.10	EAST	-	EAST	-

#### ROAD LAYOUT TABLE

ROAD NAME	ROAD CLASSIFICATION	RESERVE WIDTH (m)	ROAD WIDTH			KERB TYPE		VERGE WIDTH (m)	
			LIP to LIP	INV to INV	BACK to BACK	NTH/WEST	STH/EAST	NTH/WEST	STH/EAST
LOGAN STREET	AS2	19.80	6.75	7.50	7.95	B2	B2	4.90	4.90
CROWLANDS CIRCUIT (EAST & WEST)	AP	14.00	6.60	7.50	7.80	B2	B3	4.10	4.10
AMPHITHEATRE STREET	AP	16.00	6.60	7.50	7.80	B2	B2	4.10	4.10
NUGGETTY LANE	AL	8.50	5.50	-	-	-	-	-	3.00
CROWLANDS CIRCUIT (SOUTH)	AP	14.00	6.60	7.50	7.80	B2	B2	4.10	2.10

**AS CONSTRUCTED RECORDS**


THE OBJECTIVE OF THESE 'AS-CONSTRUCTED DRAWINGS' IS TO REFLECT ANY SIGNIFICANT CHANGES TO THE APPROVED CONSTRUCTION DRAWINGS AND PROVIDE COUNCIL WITH A RECORD OF DESIGN INTENT. ANY LEVELS AND COORDINATES SHOWN ON THESE PLANS ARE SUBJECT TO SURVEY AND WILL DIFFER. ARCADIS ACCEPT NO RESPONSIBILITY FOR LOSS OR DAMAGES RESULTING FROM THE INTERPRETATION OF THESE DRAWINGS. ALL DETAILS AND ASSETS MUST BE ASCERTAINED AND VERIFIED BY THE END USER.



**NOTE:**

- FOR GENERAL NOTES, REFER TO DRAWING No. C-08C-002.
- REFER TO DRG. NO. C-08C-700 & 701 FOR LEVEL INFORMATION FOR LOTS 8125 - 8129, 8130 - 8133 & 8134 - 8137

Issue	Description	By	Ckd	PM	Date
C	AS CONSTRUCTED	WB	ZS	SE	07.10.21
B	UPDATES TO LOT 8138	WB	ZS	SE	12.08.21
A	ISSUED FOR CONSTRUCTION	WB	ZS	SE	04.12.20
04	UPDATES TO ADDRESS COUNCIL COMMENTS	HP	ZS	SE	19.08.20
03	UPDATES TO ADDRESS COUNCIL COMMENTS	WB	ZS	SE	03.08.20
02	ISSUED FOR APPROVAL	WB	ZS	SE	10.07.20
01	ISSUED TO CLIENT FOR REVIEW	WB	ZS	SE	07.11.19

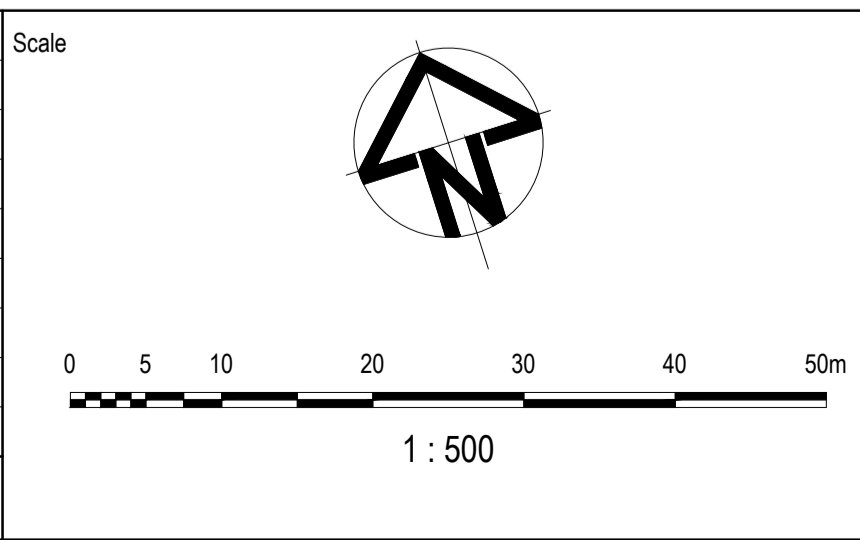

Planner

Client

Filename C-08c-220-10029435-Roadworks&DrainagePlan.dwg

Status

**AS CONSTRUCTED**

Verifier

Z.STROGUSZ

Scales

1:500

Original Issue Signatures

Drawn W.BUMAGAT

Designed J.ROCK

Project Manager S.EISEL

Grid

MGA

© Copyright reserved

Project

EYNEBURY TOWNSHIP  
STAGE 8C

Title

ROADWORKS AND DRAINAGE  
LAYOUT PLAN

Arcadis Australia Pacific Pty Limited  
Level 32, 140 William Street  
Melbourne VIC 3000  
ABN 76 104 485 289  
Tel No: +61 3 8623 4000  
www.arcadis.com

Drawing No. C-08C-220

Project No. 10029435

Issue C

Scale

1 : 500

Planner

Client

Status

Project

Title

Drawing No.

Project No.

Issue

**NOTE:**  
 1. FOR GENERAL NOTES, REFER TO DRAWING No. C-08C-002.  
 2. STRUCTURAL FILL IS REQUIRED WHERE FOOTPATH OR PAVEMENT IS CONSTRUCTED ABOVE EXISTING SURFACE.

REFER DRAWINGS C-08C-260 TO C-08C-261 FOR KERB RETURN LEVELS

Vertical Curve Length (m)  
 Vertical Curve Radius (m)  
 Vertical Grade (%)  
 Vertical Grade (1 in ...)  
 Horizontal Curve Radius (m)

DATUM RL.84.000

DESIGN LEVELS ON ROAD CONTROL LINE	DESIGN LIP OF KERB (LHS)	DESIGN LIP OF KERB (RHS)	EXISTING SURFACE ON ROAD CENTRELINE	CUT / FILL DEPTH	PEGGED CHAINAGE
94.159	94.080	94.049	94.539	-0.380	200.000
94.315	94.237	94.205	94.656	-0.340	204.003
94.537	94.459	94.427	94.795	-0.258	208.766
94.828	94.749	94.718	94.954	-0.126	214.008
95.187	95.109	95.077	95.135	0.052	220.000
95.283	95.215	95.183	95.188	0.105	221.766
95.773	95.695	95.663	95.454	0.319	229.766
96.073	95.995	95.963	95.651	0.422	234.766
96.387	96.309	96.277	95.856	0.531	240.000
96.553	96.475	96.443	95.964	0.589	242.766
96.853	96.775	96.743	96.160	0.693	247.766
97.333	97.255	97.223	96.485	0.849	255.766
97.448	97.338	97.306	96.564	0.882	257.674
97.587	97.477	97.445	96.654	0.933	260.000
97.653	97.543	97.511	96.697	0.956	261.766
97.643	97.543	97.511	96.650	1.000	264.366
98.053	97.943	97.911	96.994	1.059	267.766
98.059	97.949	97.917	96.950	1.061	267.859
98.413	98.303	98.271	97.248	1.165	273.766
98.787	98.677	98.645	97.511	1.276	280.000
99.554	99.475	99.444	98.201	1.352	292.772
99.876	99.798	99.766	98.619	1.257	300.000
99.898	99.820	99.788	98.664	1.234	302.774
99.841	99.831	99.799	98.779	1.162	304.266
99.863	99.863	99.831	98.865	1.097	304.266
99.867	99.867	99.835	98.891	1.000	306.891
99.975	99.975	99.943	98.980	1.028	308.000
99.975	99.975	99.943	99.147	0.828	308.000
99.904	99.904	99.872	99.456	0.448	312.772
99.766	99.766	99.734	99.796	-0.030	318.266
99.743	99.743	99.711	99.911	-0.168	320.000


**LOGAN STREET (MC01) - LONGITUDINAL SECTION**

SCALE: HORIZONTAL - 1:500  
 VERTICAL - 1:100

**AS CONSTRUCTED RECORDS**

THE OBJECTIVE OF THESE 'AS-CONSTRUCTED DRAWINGS' IS TO REFLECT ANY SIGNIFICANT CHANGES TO THE APPROVED CONSTRUCTION DRAWINGS AND PROVIDE COUNCIL WITH A RECORD OF DESIGN INTENT. ANY LEVELS AND COORDINATES SHOWN ON THESE PLANS ARE SUBJECT TO SURVEY AND WILL DIFFER. ARCADIS ACCEPTS NO RESPONSIBILITY FOR LOSS OR DAMAGES RESULTING FROM THE INTERPRETATION OF THESE DRAWINGS. ALL DETAILS AND ASSETS MUST BE ASCERTAINED AND VERIFIED BY THE END USER.

Issue	Description	By	Ckd	PM	Date
B	AS CONSTRUCTED	WB	ZS	SE	07.10.21
A	ISSUED FOR CONSTRUCTION	WB	ZS	SE	04.12.20
02	ISSUED FOR APPROVAL	WB	ZS	SE	10.07.20
01	ISSUED TO CLIENT FOR REVIEW	WB	ZS	SE	07.11.19

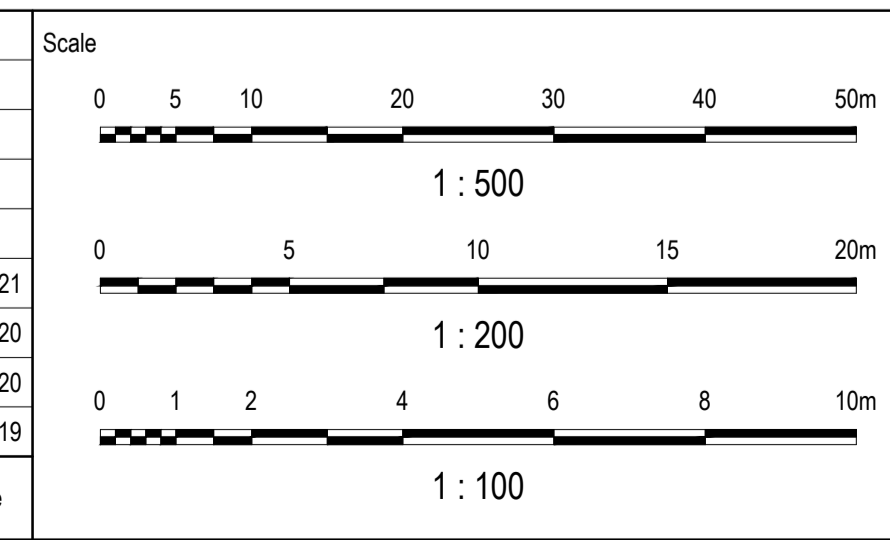

Planner: **RD RobertsDay** planning.design.place

Client: **RESIMAX GROUP**

Filename: C-08c-240-10029435-RoadLS-XS MC01.dwg

Status: **AS CONSTRUCTED**

Verifier: **Z.STROGUSZ**

Scales: **AS SHOWN**

Original Size: **A1**

Height Datum: **AHD**

Grid: **MGA**

Original Issue Signatures: Drawn **W.BUMAGAT**, Designed **J.ROCK**, Project Manager **S.EISEL**

© Copyright reserved

Project: **EYNESBURY TOWNSHIP STAGE 8C**

Title: **LOGAN STREET ROAD LONGITUDINAL AND CROSS SECTIONS**



Drawing No.: **C-08C-240**

Project No.: **10029435**


Issue: **B**

**ARCADIS**


Arcadis Australia Pacific Pty Limited  
 Level 32, 140 William Street  
 Melbourne VIC 3000  
 ABN 76 104 485 289  
 Tel No: +61 3 8623 4000  
 www.arcadis.com

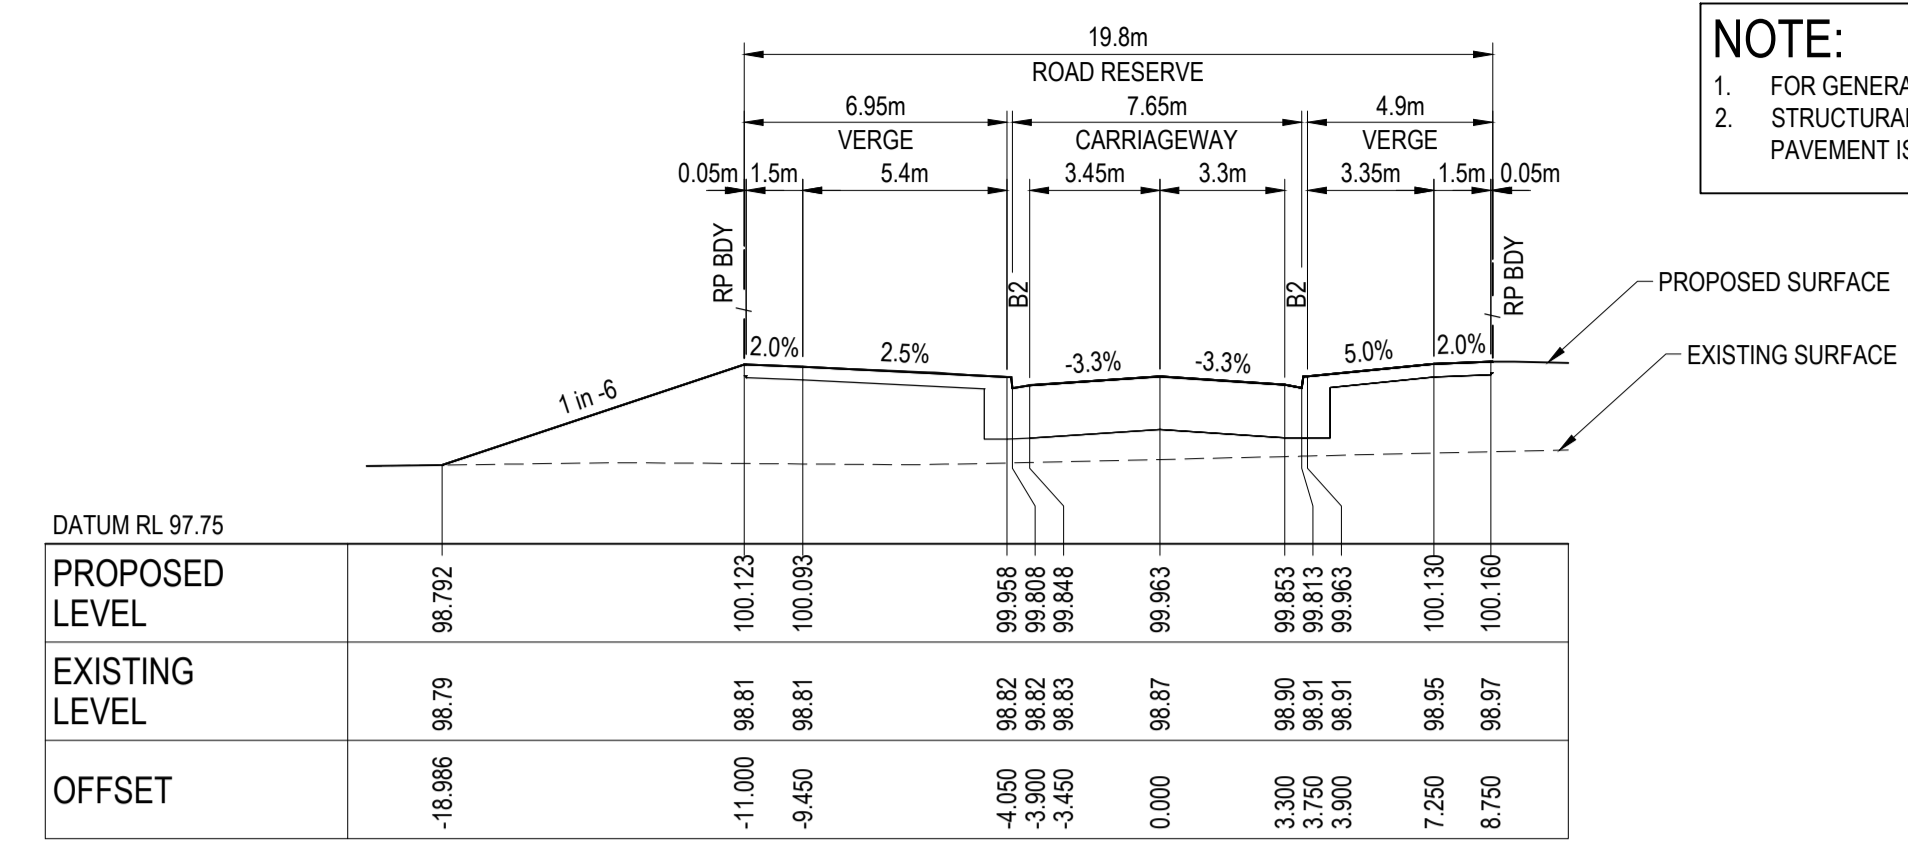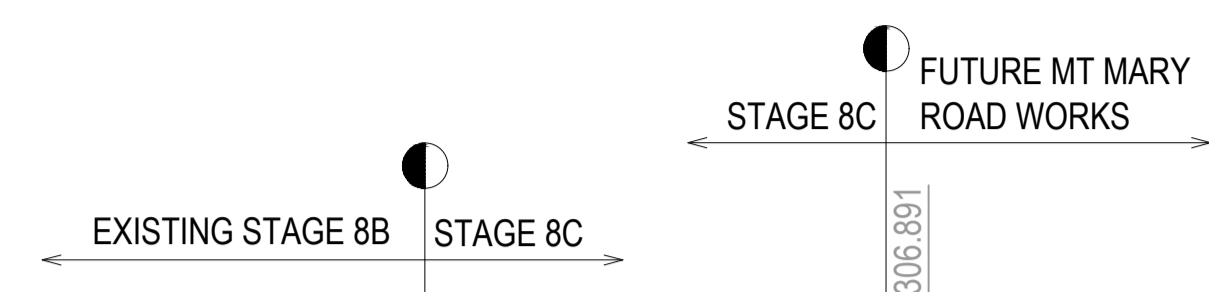


CH 304.266

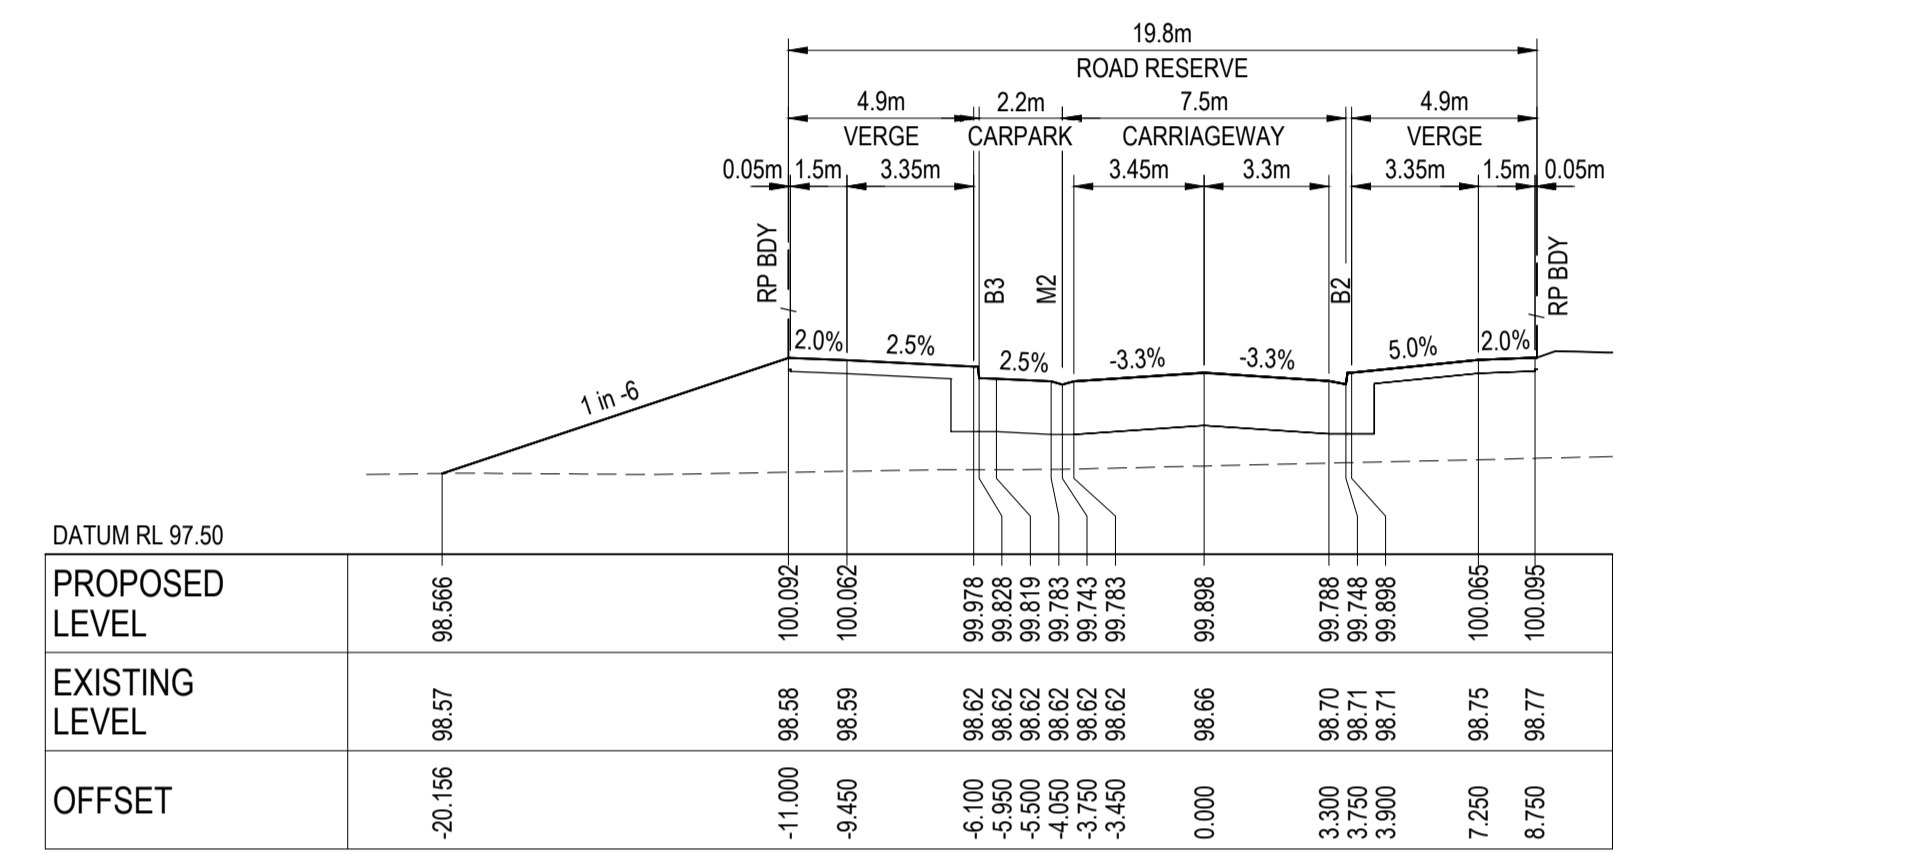

CH 300.774

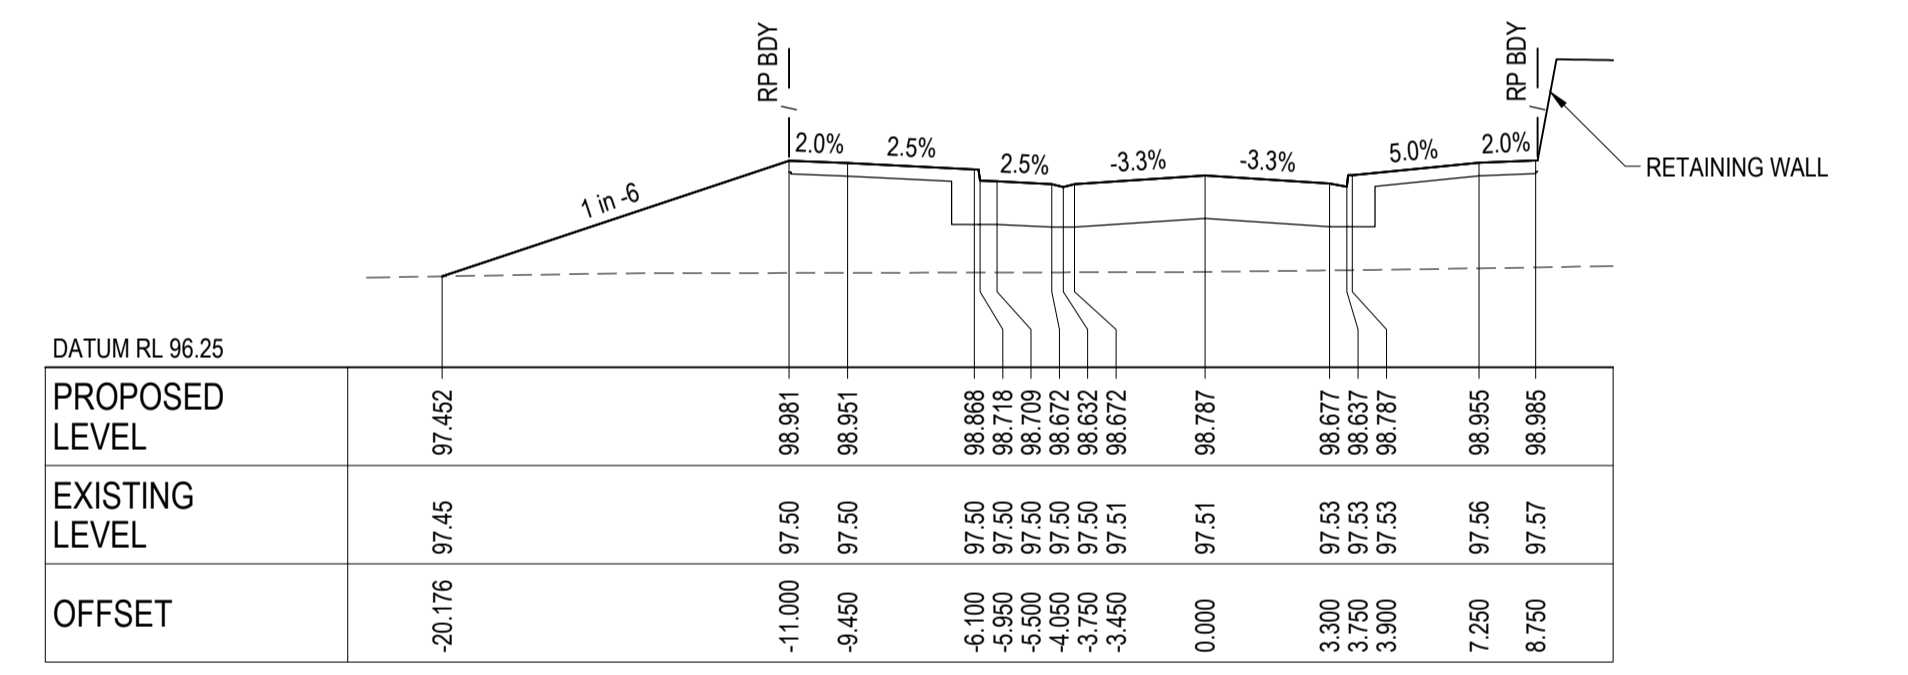

CH 280.000

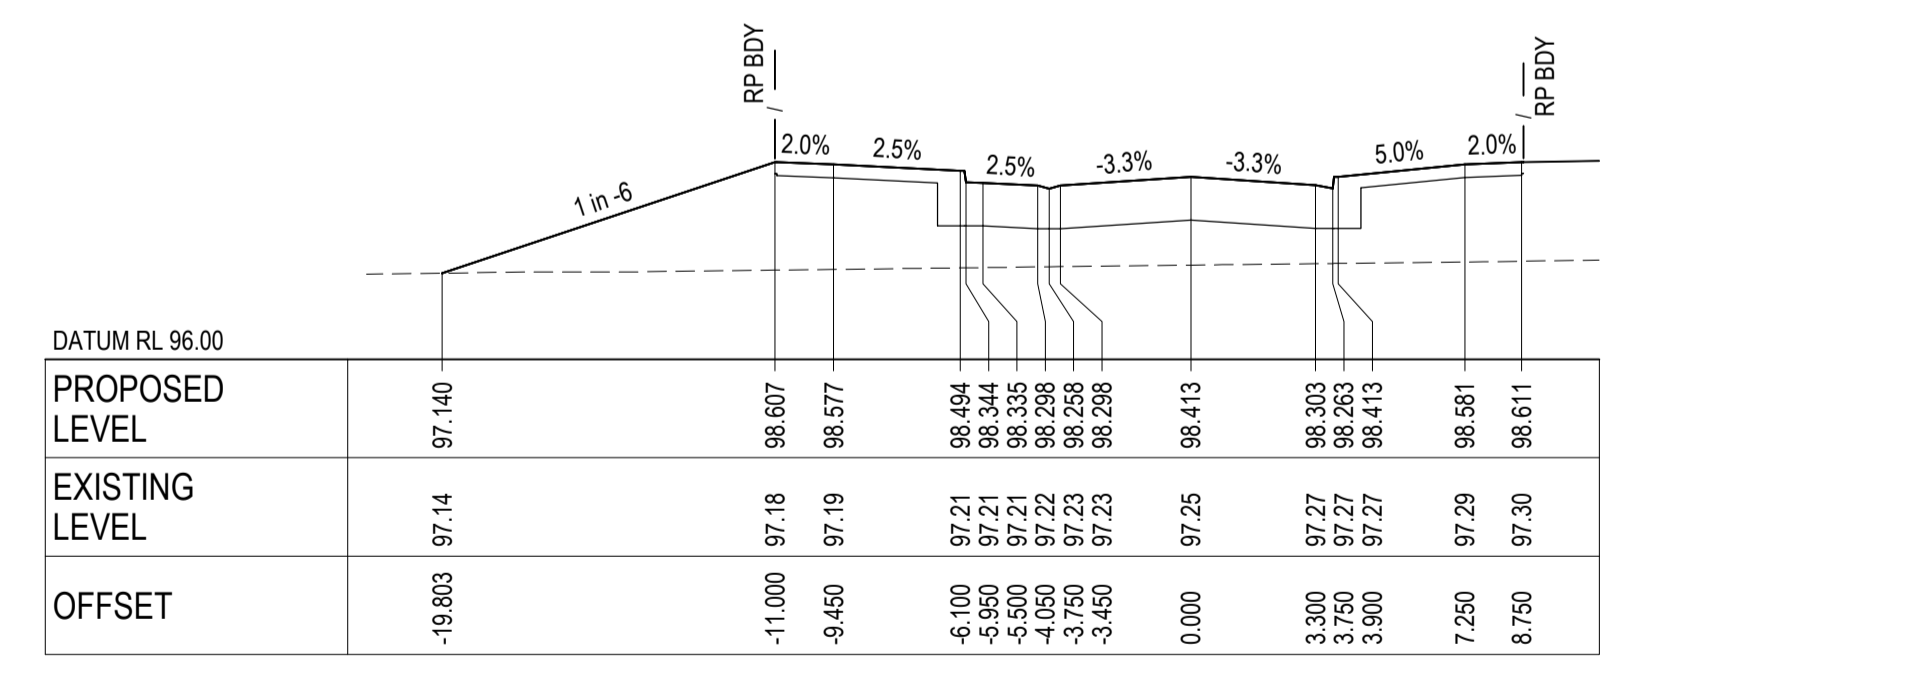


CH 273.766

**LOGAN STREET (MC01) - CROSS SECTIONS**

SCALE: 1:200 HORI.  
 1:100 VERT.

**NOTE:**  
FOR GENERAL NOTES, REFER TO DRAWING No. C-08C-002.

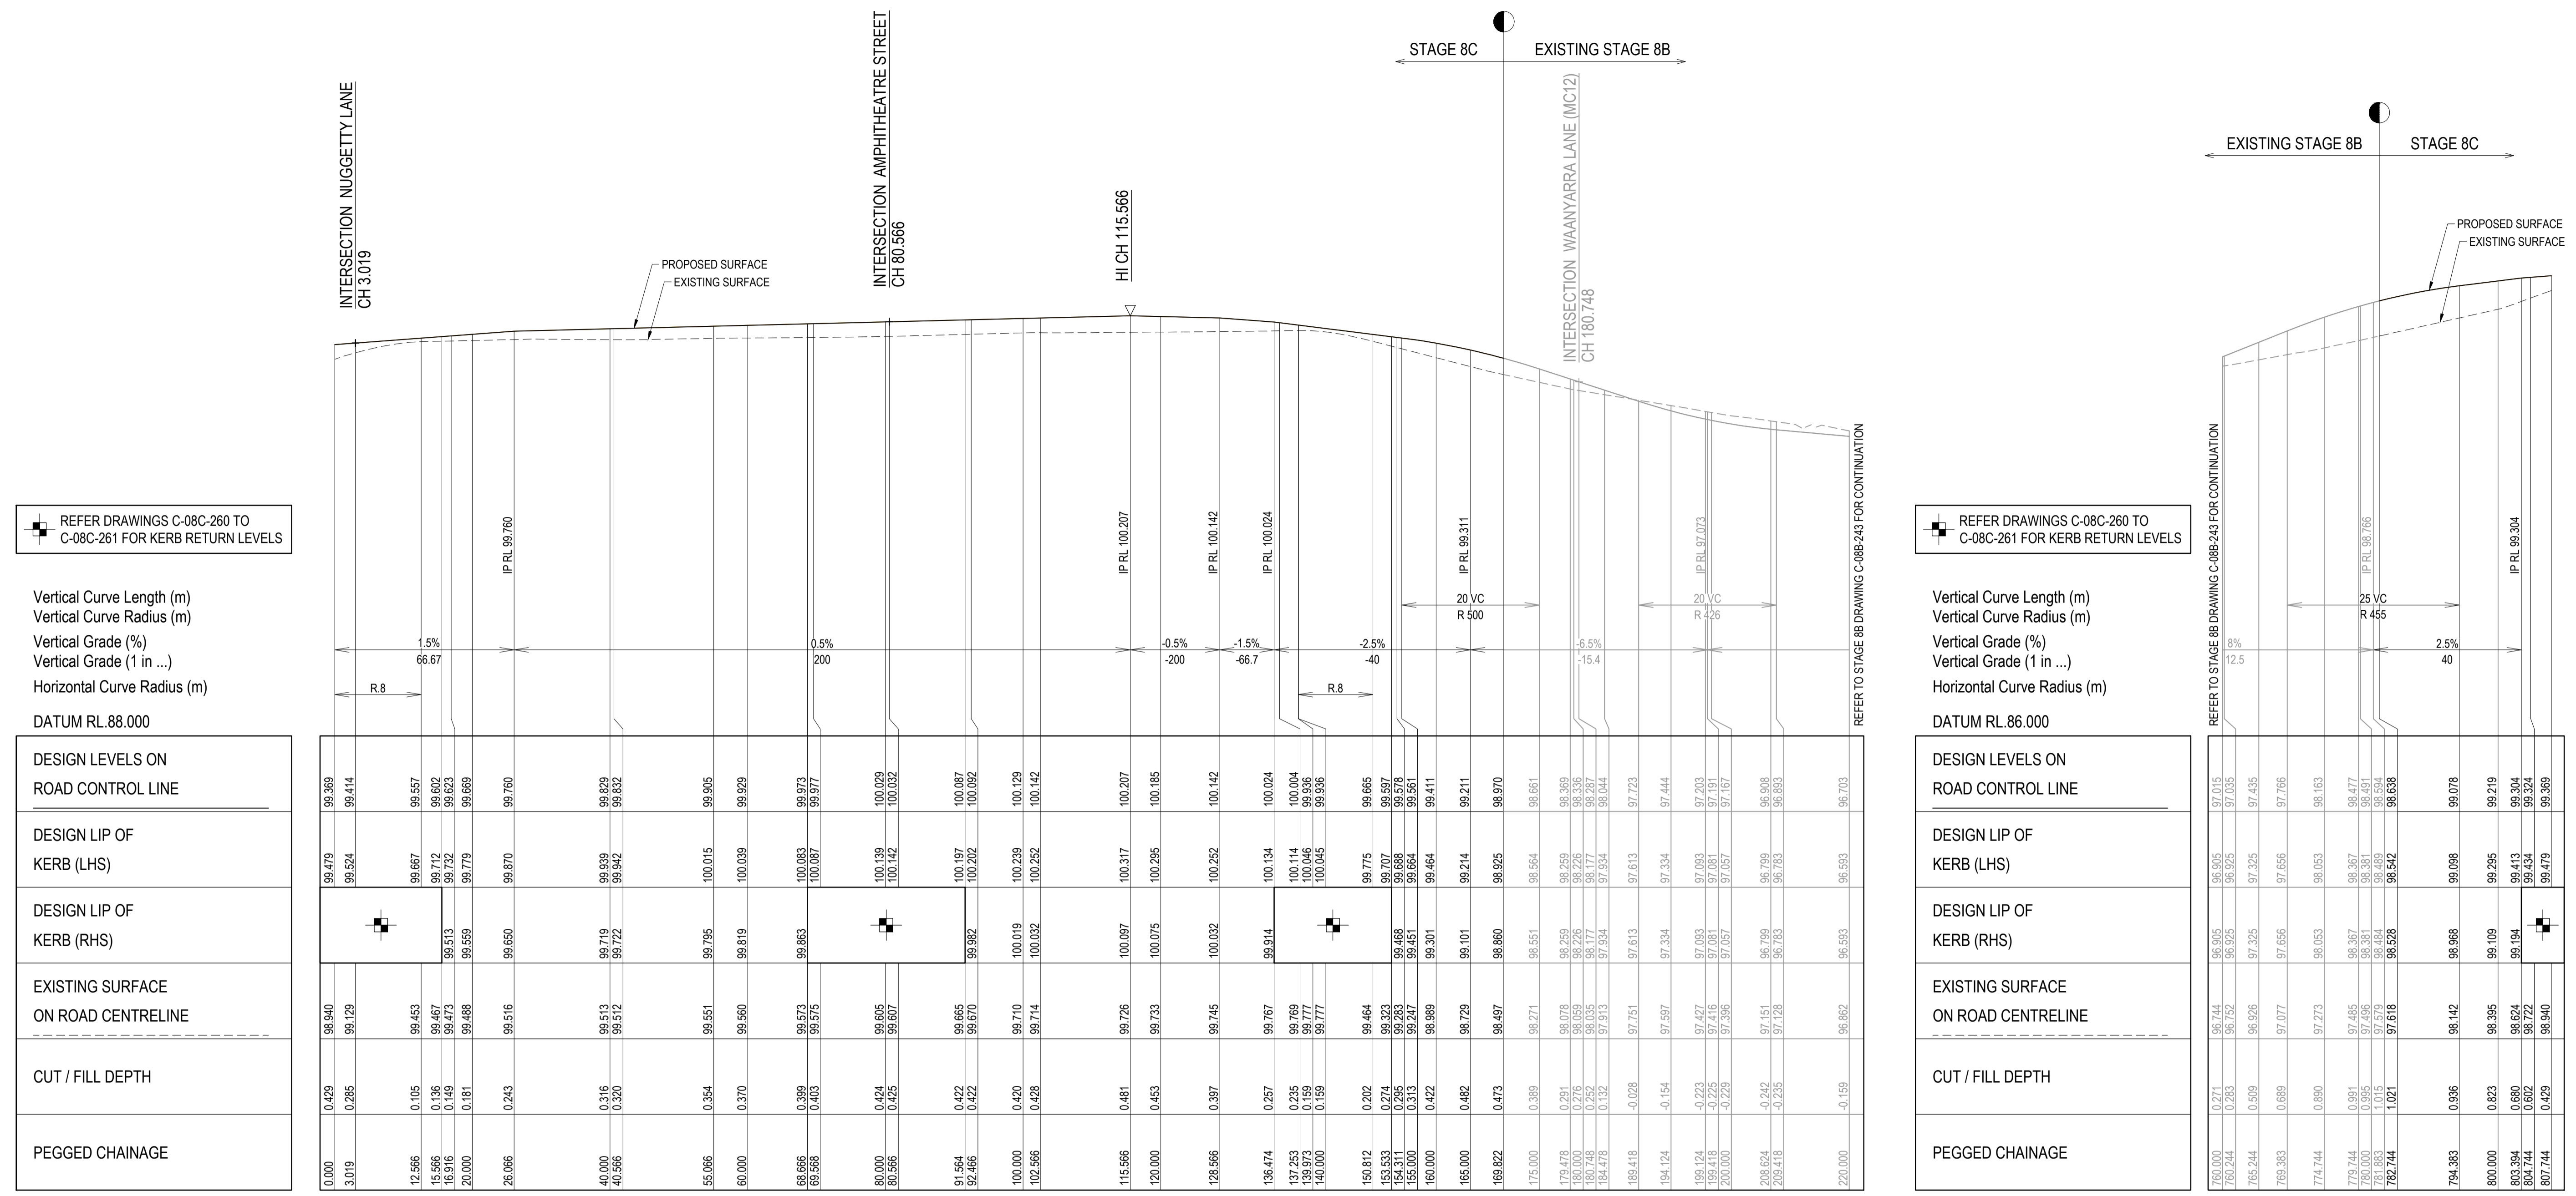

REFER DRAWINGS C-08C-260 TO C-08C-261 FOR KERB RETURN LEVELS

Vertical Curve Length (m)  
Vertical Curve Radius (m)  
Vertical Grade (%)  
Vertical Grade (1 in ...)  
Horizontal Curve Radius (m)  
DATUM RL.88.000

DESIGN LEVELS ON ROAD CONTROL LINE	DESIGN LIP OF KERB (LHS)	DESIGN LIP OF KERB (RHS)	EXISTING SURFACE ON ROAD CENTRELINE	CUT / FILL DEPTH	PEGGED CHAINAGE
99.369	99.479		99.940	0.479	0.000
99.414	99.524		99.129	0.285	3.019
99.557	99.667		99.453	0.105	12.566
99.602	99.712		99.467	0.136	15.566
99.643	99.753		99.473	0.149	18.518
99.669	99.779		99.488	0.181	20.000
99.760	99.870		99.516	0.243	26.066
99.829	99.939		99.513	0.316	40.000
99.832	99.942		99.512	0.320	40.566
99.905	100.015		99.551	0.354	55.066
99.929	100.039		99.560	0.370	60.000
99.973	100.083		99.573	0.399	68.666
99.977	100.087		99.575	0.403	69.566
100.029	100.139		99.605	0.424	80.000
100.032	100.142		99.607	0.425	80.566
100.087	100.197		99.655	0.422	91.564
100.092	100.202		99.670	0.422	92.466
100.129	100.239		99.710	0.420	100.000
100.142	100.252		99.714	0.428	102.566
100.207	100.317		99.726	0.481	115.566
100.185	100.295		99.733	0.453	120.000
100.142	100.252		99.745	0.397	128.566
100.024	100.134		99.767	0.257	138.474
100.004	100.114		99.789	0.235	137.253
99.996	100.106		99.777	0.199	138.973
99.938	100.048		99.777	0.199	140.000
99.665	99.775		99.464	0.202	150.812
99.597	99.707		99.353	0.214	153.533
99.561	99.671		99.342	0.242	155.000
99.451	99.561		99.247	0.313	155.000
99.301	99.401		99.089	0.422	160.000
99.211	99.311		99.011	0.482	165.000
99.970	99.970		99.860	0.473	169.822
99.661	99.661		99.551	0.389	175.000
99.369	99.369		99.259	0.291	179.478
99.336	99.336		99.226	0.276	180.000
99.287	99.287		99.177	0.252	180.748
99.044	99.044		99.934	0.132	184.478
97.723	97.613		97.751	0.028	188.418
97.444	97.334		97.597	0.154	194.124
97.203	97.093		97.427	0.223	199.124
97.191	97.081		97.416	0.225	199.418
97.167	97.057		97.396	0.229	200.000
96.908	96.799		97.151	0.242	208.624
96.853	96.783		97.128	0.235	209.418
96.703	96.593		96.862	0.159	220.000

REFER DRAWINGS C-08C-260 TO C-08C-261 FOR KERB RETURN LEVELS

Vertical Curve Length (m)  
Vertical Curve Radius (m)  
Vertical Grade (%)  
Vertical Grade (1 in ...)  
Horizontal Curve Radius (m)  
DATUM RL.86.000

DESIGN LEVELS ON ROAD CONTROL LINE	DESIGN LIP OF KERB (LHS)	DESIGN LIP OF KERB (RHS)	EXISTING SURFACE ON ROAD CENTRELINE	CUT / FILL DEPTH	PEGGED CHAINAGE
97.015	96.905		96.744	0.271	760.000
97.035	96.925		96.752	0.283	760.244
97.435	97.325		96.926	0.509	765.244
97.766	97.656		97.077	0.689	769.383
98.163	98.053		97.273	0.890	774.744
98.477	98.367		97.485	0.991	779.744
98.591	98.481		97.596	0.995	780.000
98.591	98.481		97.596	0.995	780.000
98.638	98.528		97.618	1.021	782.744
99.078	98.968		98.142	0.936	794.383
99.219	99.295		98.395	0.823	800.000
99.304	99.413		98.194	0.680	803.394
99.324	99.434		98.722	0.602	804.744
99.369	99.479		98.940	0.429	807.744

**CROWLANDS CIRCUIT (MC03) - LONGITUDINAL SECTION**  
SCALE: HORIZONTAL - 1:500  
VERTICAL - 1:100


**AS CONSTRUCTED RECORDS**  
THE OBJECTIVE OF THESE 'AS-CONSTRUCTED DRAWINGS' IS TO REFLECT ANY SIGNIFICANT CHANGES TO THE APPROVED CONSTRUCTION DRAWINGS AND PROVIDE COUNCIL WITH A RECORD OF DESIGN INTENT. ANY LEVELS AND COORDINATES SHOWN ON THESE PLANS ARE SUBJECT TO SURVEY AND WILL DIFFER. ARCADIS ACCEPT NO RESPONSIBILITY FOR LOSS OR DAMAGES RESULTING FROM THE INTERPRETATION OF THESE DRAWINGS. ALL DETAILS AND ASSETS MUST BE ASCERTAINED AND VERIFIED BY THE END USER.

<p>Scale</p>		<p>Planner</p>		<p>Client</p>		<p>Status</p> <p><b>AS CONSTRUCTED</b></p>		<p>Project</p> <p><b>EYNESBURY TOWNSHIP STAGE 8C</b></p>		<p>Arcadis Australia Pacific Pty Limited Level 32, 140 William Street Melbourne VIC 3000 ABN 76 104 485 289 Tel No: +61 3 8623 4000 www.arcadis.com</p>																															
<p>Issue</p> <table border="1"> <thead> <tr> <th>Issue</th> <th>Description</th> <th>By</th> <th>Ckd</th> <th>PM</th> <th>Date</th> </tr> </thead> <tbody> <tr><td>B</td><td>AS CONSTRUCTED</td><td>WB</td><td>ZS</td><td>SE</td><td>07.10.21</td></tr> <tr><td>A</td><td>ISSUED FOR CONSTRUCTION</td><td>WB</td><td>ZS</td><td>SE</td><td>04.12.20</td></tr> <tr><td>02</td><td>ISSUED FOR APPROVAL</td><td>WB</td><td>ZS</td><td>SE</td><td>10.07.20</td></tr> <tr><td>01</td><td>ISSUED TO CLIENT FOR REVIEW</td><td>WB</td><td>ZS</td><td>SE</td><td>07.11.19</td></tr> </tbody> </table>		Issue	Description	By	Ckd	PM	Date	B	AS CONSTRUCTED	WB	ZS	SE	07.10.21	A	ISSUED FOR CONSTRUCTION	WB	ZS	SE	04.12.20	02	ISSUED FOR APPROVAL	WB	ZS	SE	10.07.20	01	ISSUED TO CLIENT FOR REVIEW	WB	ZS	SE	07.11.19	<p>Verifier</p> <p>Z.STROGUSZ</p>		<p>Scales</p> <p>1:500 (H) 1:100 (V)</p>		<p>Original Issue Signatures</p> <p>Drawn: W.BUMAGAT Designed: J.ROCK Project Manager: S.EISEL</p>		<p>Title</p> <p><b>CROWLANDS CIRCUIT ROAD LONGITUDINAL SECTIONS</b></p>		<p>Drawing No. C-08C-241</p> <p>Project No. 10029435</p> <p>Issue B</p>	
Issue	Description	By	Ckd	PM	Date																																				
B	AS CONSTRUCTED	WB	ZS	SE	07.10.21																																				
A	ISSUED FOR CONSTRUCTION	WB	ZS	SE	04.12.20																																				
02	ISSUED FOR APPROVAL	WB	ZS	SE	10.07.20																																				
01	ISSUED TO CLIENT FOR REVIEW	WB	ZS	SE	07.11.19																																				
<p>Filename: C-08c-241-10029435-RoadLS MC03.dwg</p>		<p>Grid</p> <p>MGA</p>		<p>Copyright reserved</p>		<p>Grid</p> <p>MGA</p>		<p>Project No.</p> <p>10029435</p>		<p>Issue</p> <p>B</p>																															








**NOTE:**  
 1. FOR GENERAL NOTES, REFER TO DRAWING No. C-08C-002.  
 2. STRUCTURAL FILL IS REQUIRED WHERE FOOTPATH OR PAVEMENT IS CONSTRUCTED ABOVE EXISTING SURFACE.

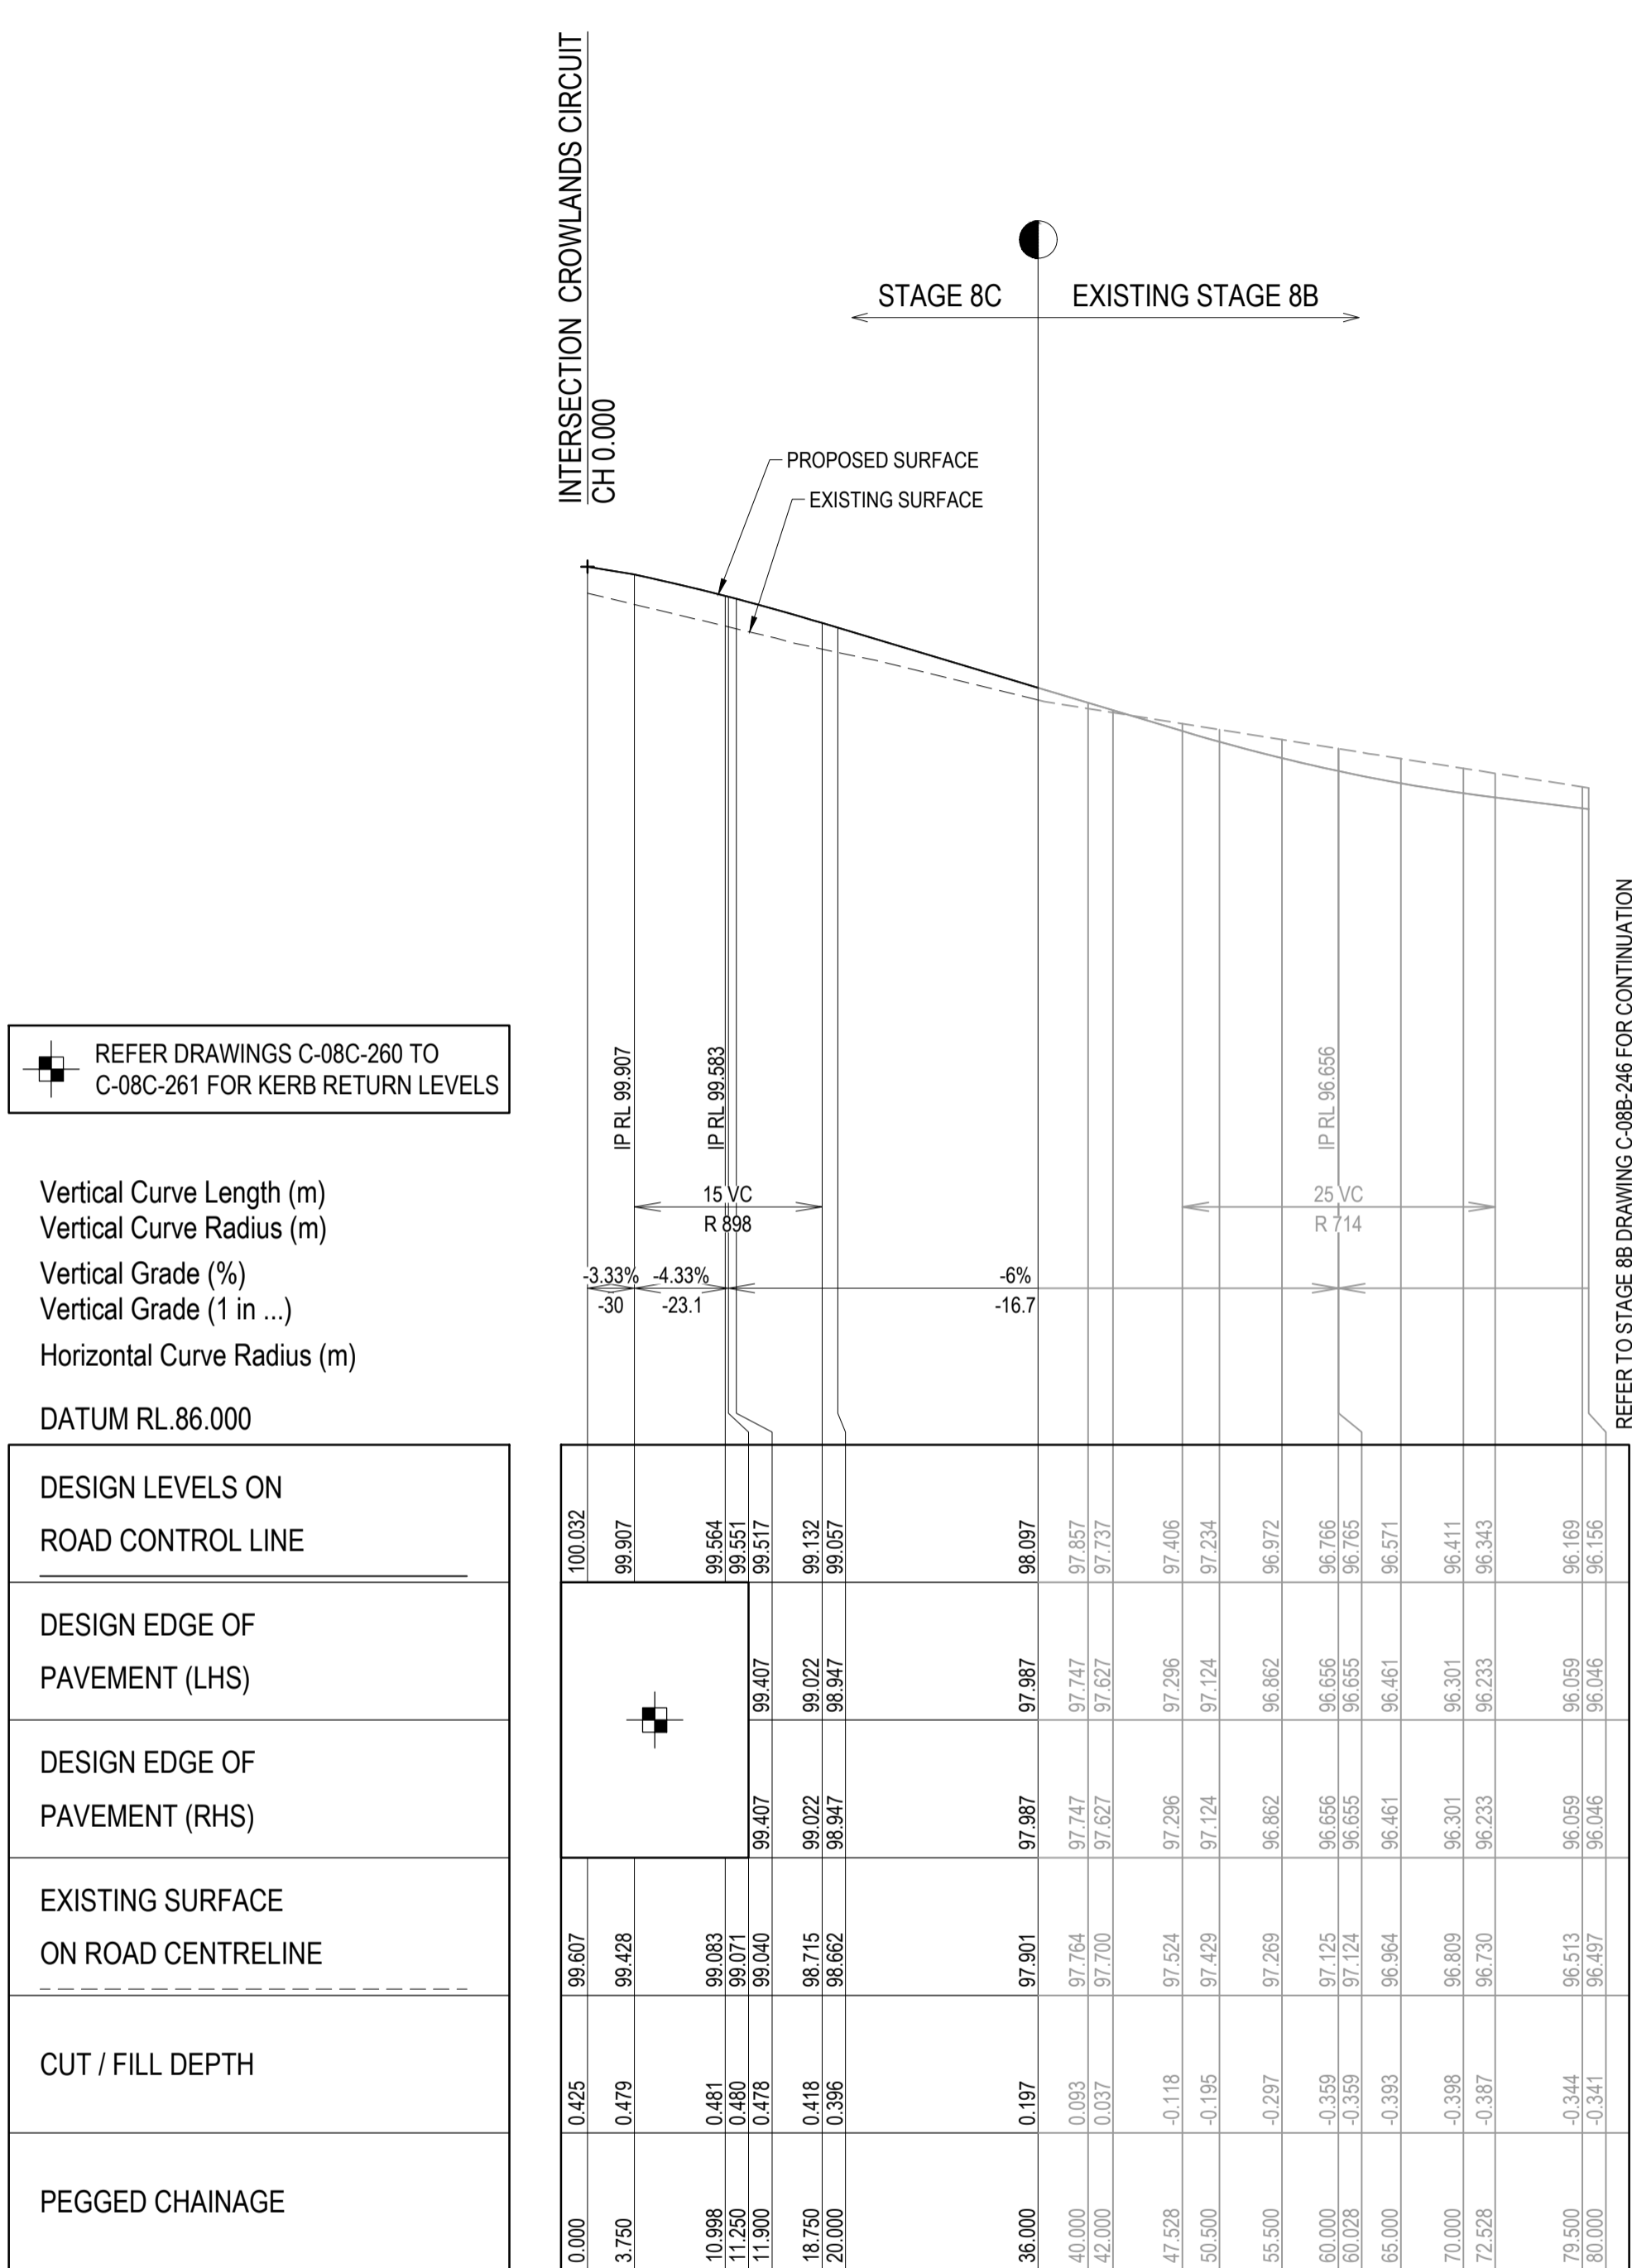

AMPHITHEATRE STREET (MC04) - LONGITUDINAL SECTION  
 SCALE: HORIZONTAL - 1:500  
 VERTICAL - 1:100

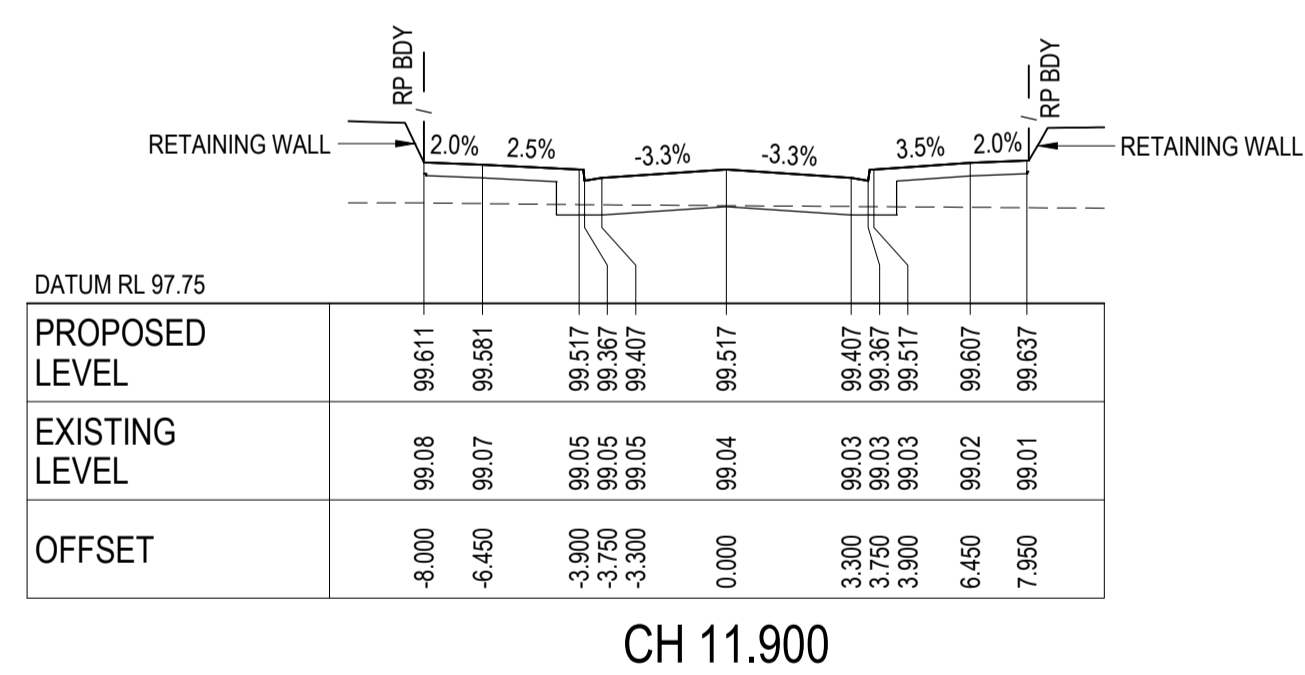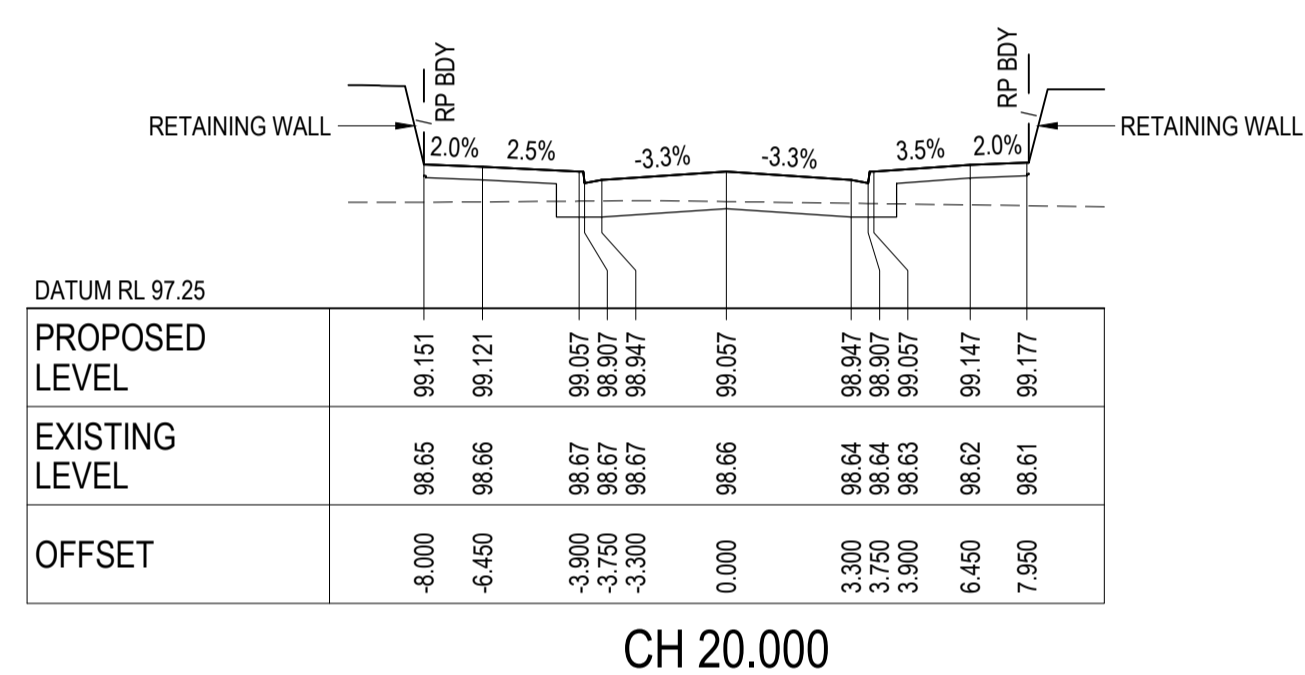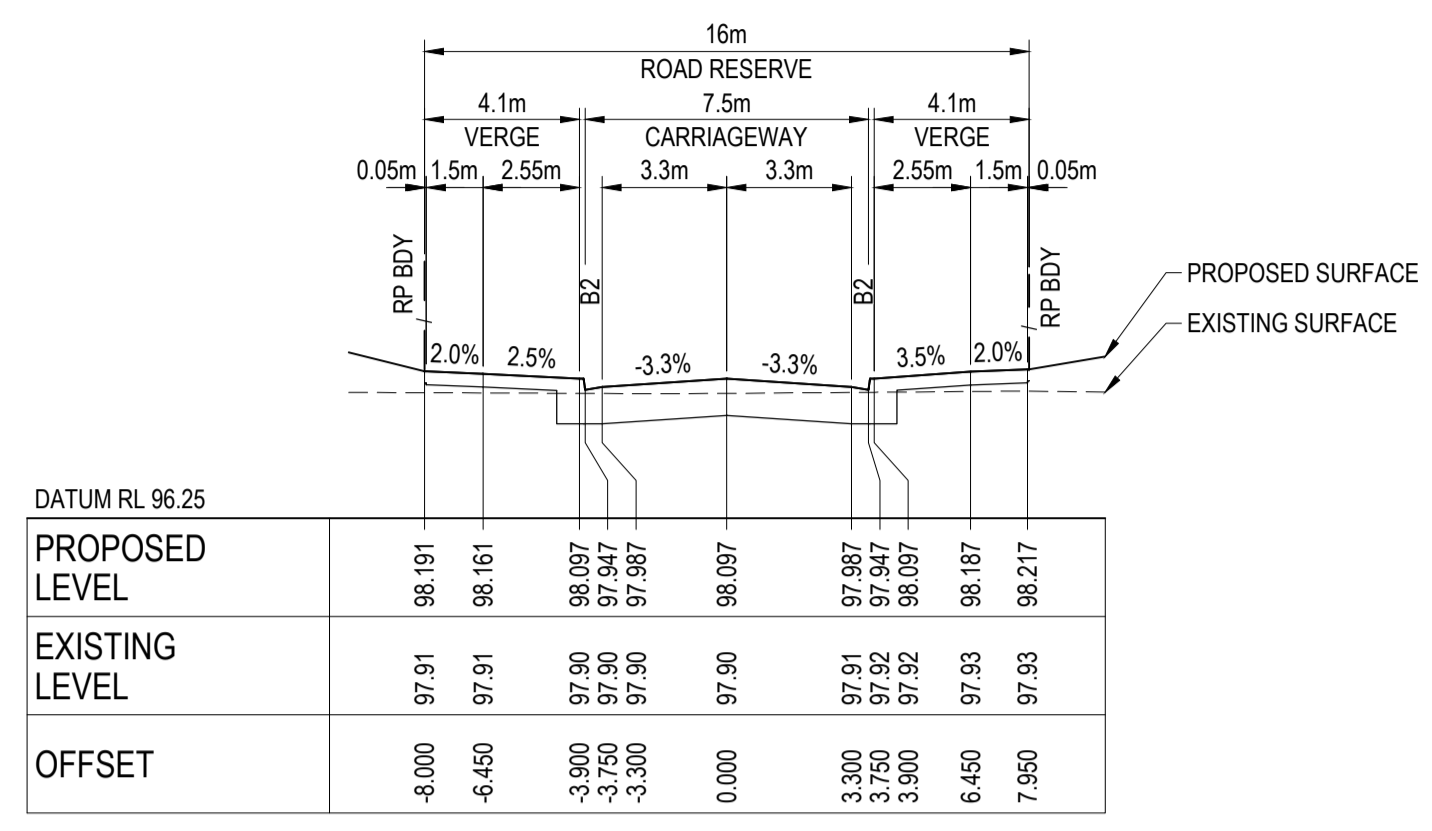


AMPHITHEATRE STREET (MC04) - CROSS SECTIONS  
 SCALE 1:200 HORI.  
 1:100 VERT.

**AS CONSTRUCTED RECORDS**

THE OBJECTIVE OF THESE 'AS-CONSTRUCTED DRAWINGS' IS TO REFLECT ANY SIGNIFICANT CHANGES TO THE APPROVED CONSTRUCTION DRAWINGS AND PROVIDE COUNCIL WITH A RECORD OF DESIGN INTENT. ANY LEVELS AND COORDINATES SHOWN ON THESE PLANS ARE SUBJECT TO SURVEY AND WILL DIFFER. ARCADIS ACCEPT NO RESPONSIBILITY FOR LOSS OR DAMAGES RESULTING FROM THE INTERPRETATION OF THESE DRAWINGS. ALL DETAILS AND ASSETS MUST BE ASCERTAINED AND VERIFIED BY THE END USER.

Issue	Description	By	Ckd	PM	Date
B	AS CONSTRUCTED	WB	ZS	SE	07.10.21
A	ISSUED FOR CONSTRUCTION	WB	ZS	SE	04.12.20
03	UPDATES TO ADDRESS COUNCIL COMMENTS	WB	ZS	SE	03.08.20
02	ISSUED FOR APPROVAL	WB	ZS	SE	10.07.20
01	ISSUED TO CLIENT FOR REVIEW	WB	ZS	SE	07.11.19

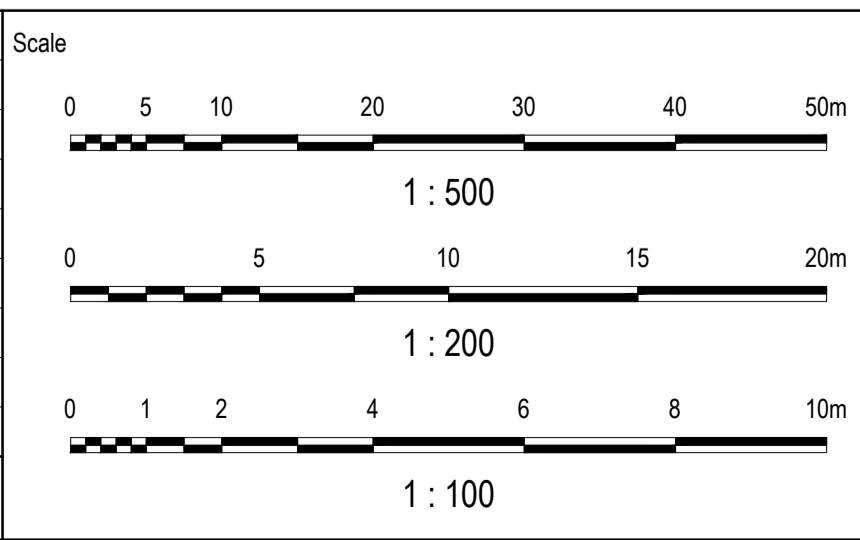

Planner

RD RobertsDay  
planning.design.place

Client

RESIMAX  
GROUP

Filename C-08c-243-10029435-RoadLS-XS MC04.dwg

Status

AS CONSTRUCTED

Verifier

Z.STROGUSZ

Scales

AS SHOWN

Original Issue Signatures

Drawn W.BUMAGAT

Designed J.ROCK

Original Size

A1

Height Datum

AHD

Project Manager S.EISEL

Grid

MGA

© Copyright reserved

Project

EYNESBURY TOWNSHIP  
STAGE 8C

Title

AMPHITHEATRE STREET ROAD  
LONGITUDINAL AND  
CROSS SECTIONS

Arcadis Australia Pacific Pty Limited  
Level 32, 140 William Street  
Melbourne VIC 3000  
ABN 76 104 485 289  
Tel No: +61 3 8623 4000  
www.arcadis.com

Drawing No. C-08C-243

Project No. 10029435

Issue B


**NOTE:**  
 1. FOR GENERAL NOTES, REFER TO DRAWING No. C-08C-002.  
 2. STRUCTURAL FILL IS REQUIRED WHERE FOOTPATH OR PAVEMENT IS CONSTRUCTED ABOVE EXISTING SURFACE.

INTERSECTION CROWLANDS CIRCUIT  
 CH 0.000


REFER DRAWINGS C-08C-260 TO C-08C-261 FOR KERB RETURN LEVELS

Vertical Curve Length (m)  
 Vertical Curve Radius (m)  
 Vertical Grade (%)  
 Vertical Grade (1 in ...)  
 Horizontal Curve Radius (m)


DATUM RL.92.000
DESIGN LEVELS ON ROAD CONTROL LINE
DESIGN EDGE OF PAVEMENT (LHS)
DESIGN EDGE OF PAVEMENT (RHS)
EXISTING SURFACE ON ROAD CENTRELINE
CUT / FILL DEPTH
PEGGED CHAINAGE

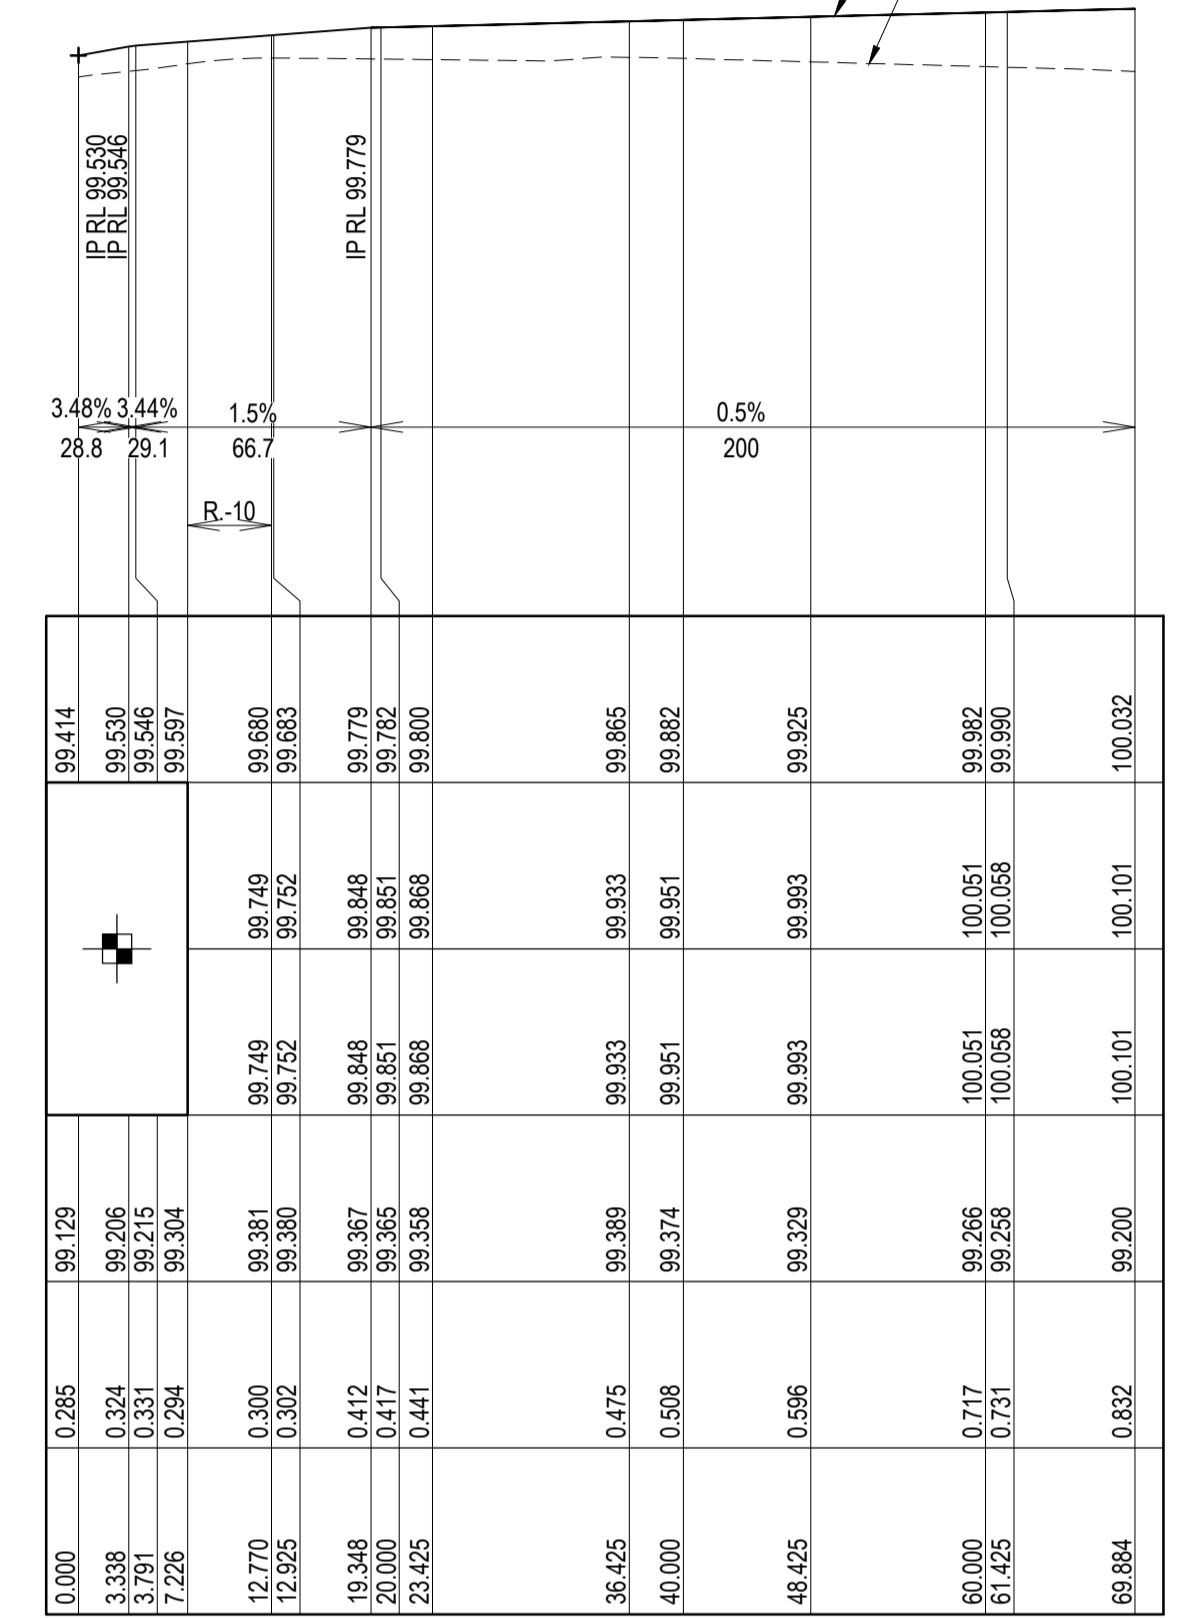

**NUGGETTY LANE (MC11) - LONGITUDINAL SECTION**  
 SCALE: HORIZONTAL - 1:500  
 VERTICAL - 1:100

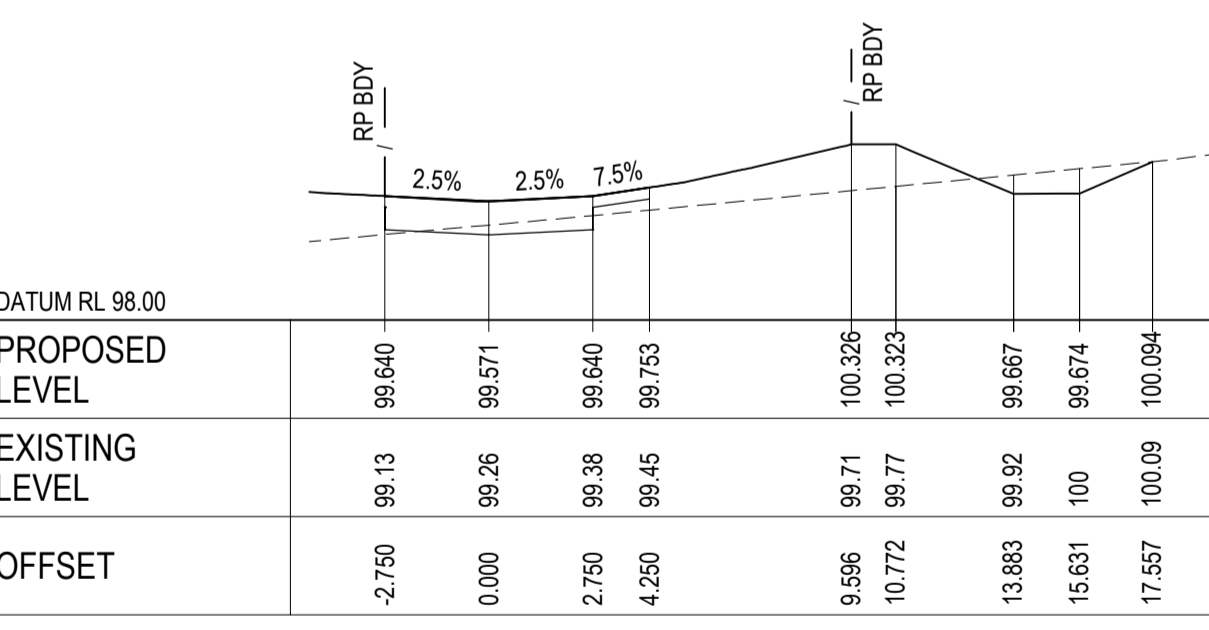


CH 5.496

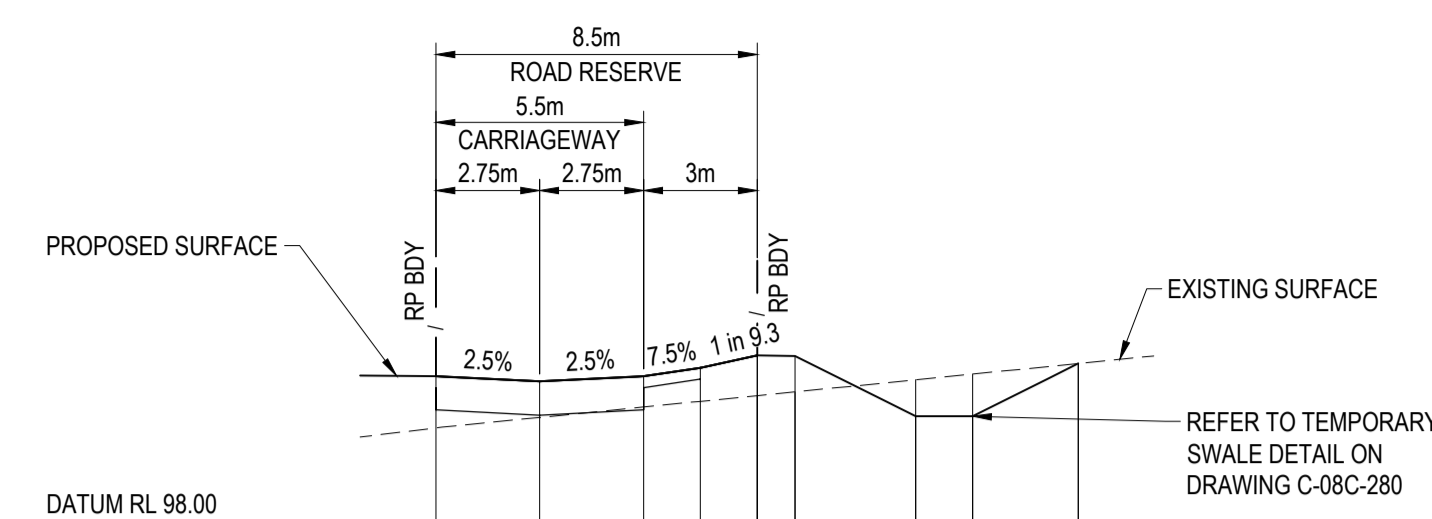


DATUM RL 98.00	PROPOSED LEVEL	EXISTING LEVEL	OFFSET
-2.750	99.933	99.25	-2.750
0.000	99.865	99.39	0.000
2.750	99.933	99.53	2.750
4.250	100.046	99.60	4.250
5.750	100.208	99.68	5.750
6.750	100.203	99.73	6.750
9.948	99.403	99.89	9.948
11.448	99.403	99.96	11.448
14.241	100.102	100.1	14.241


CH 36.425

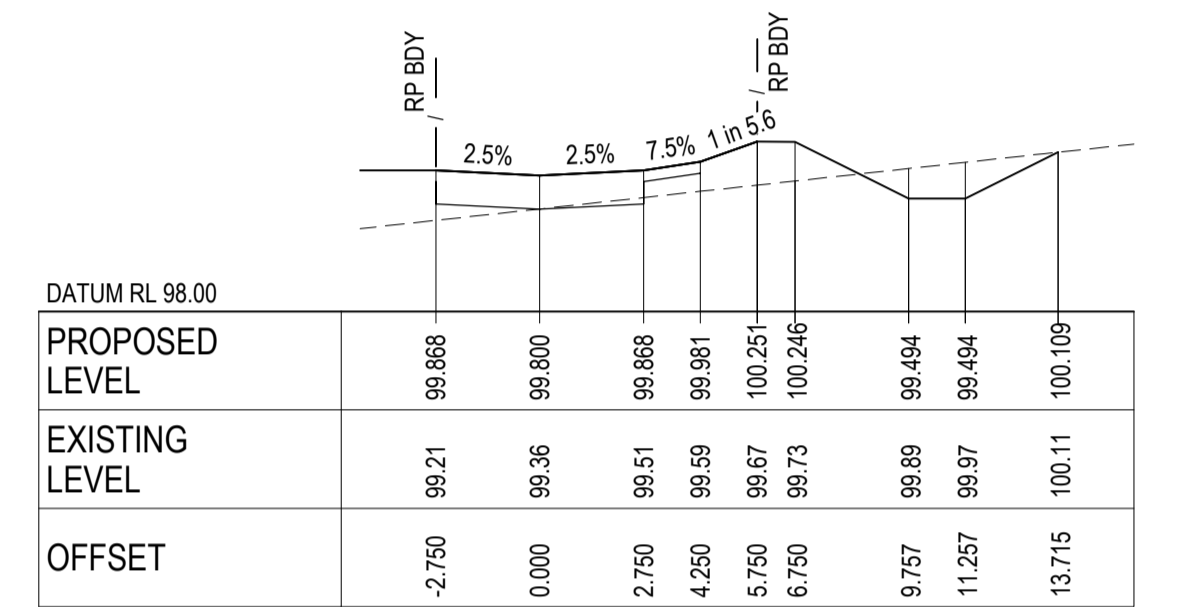


CH 23.425

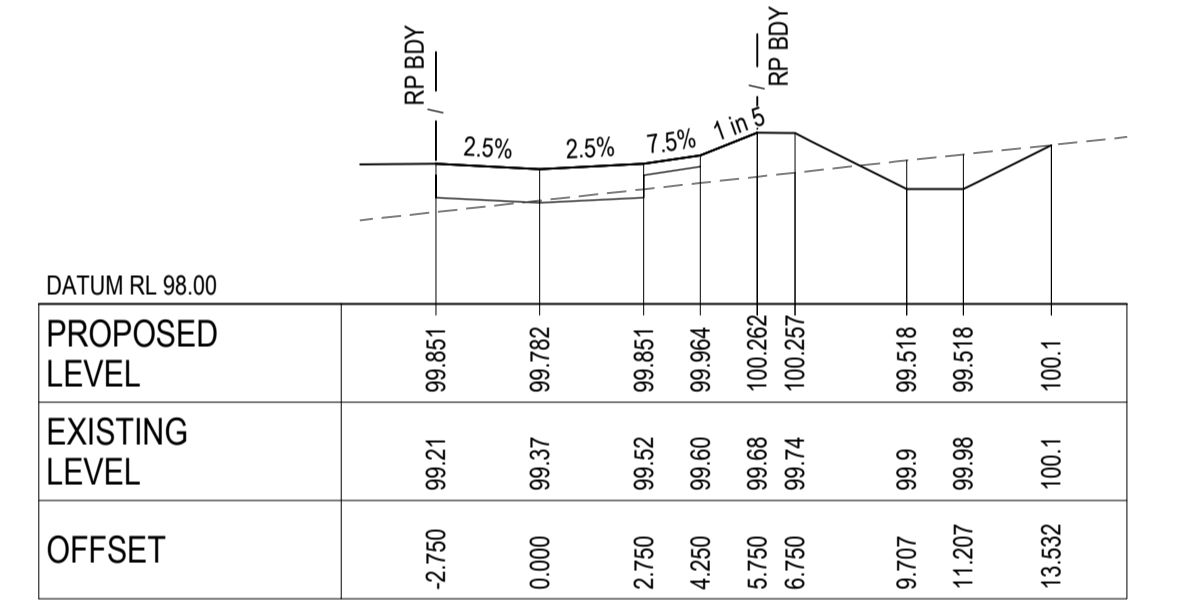


CH 20.000

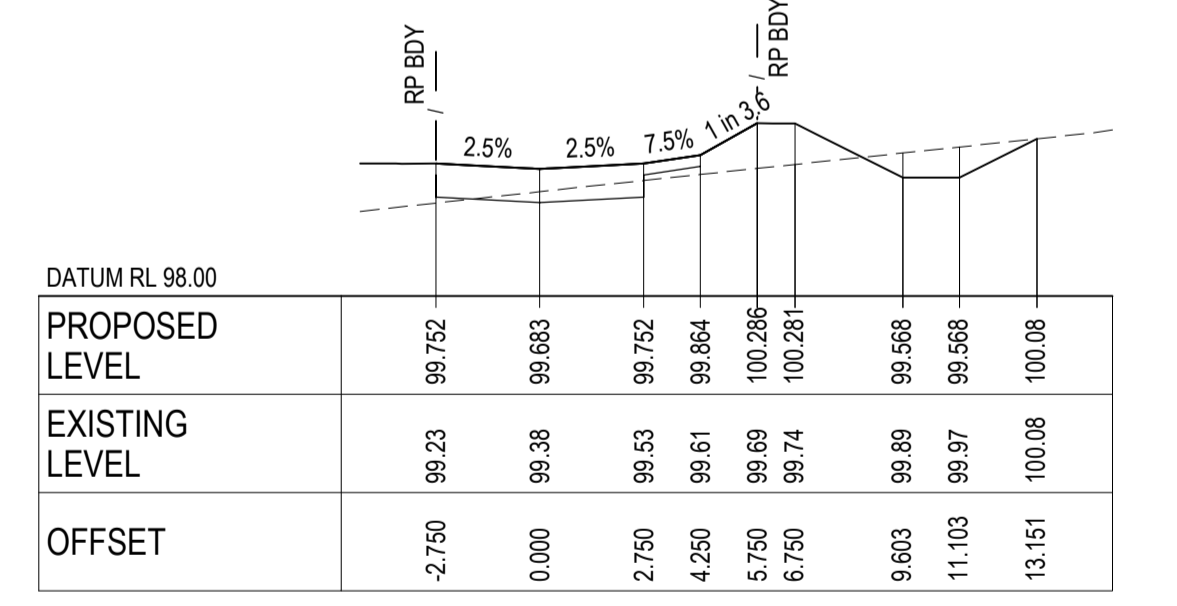


CH 12.925

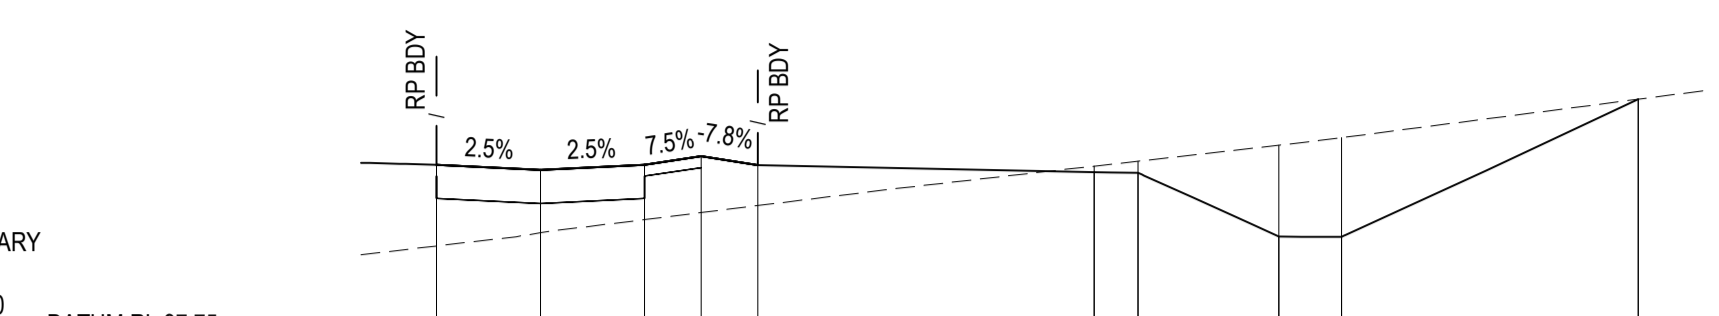


CH 69.884

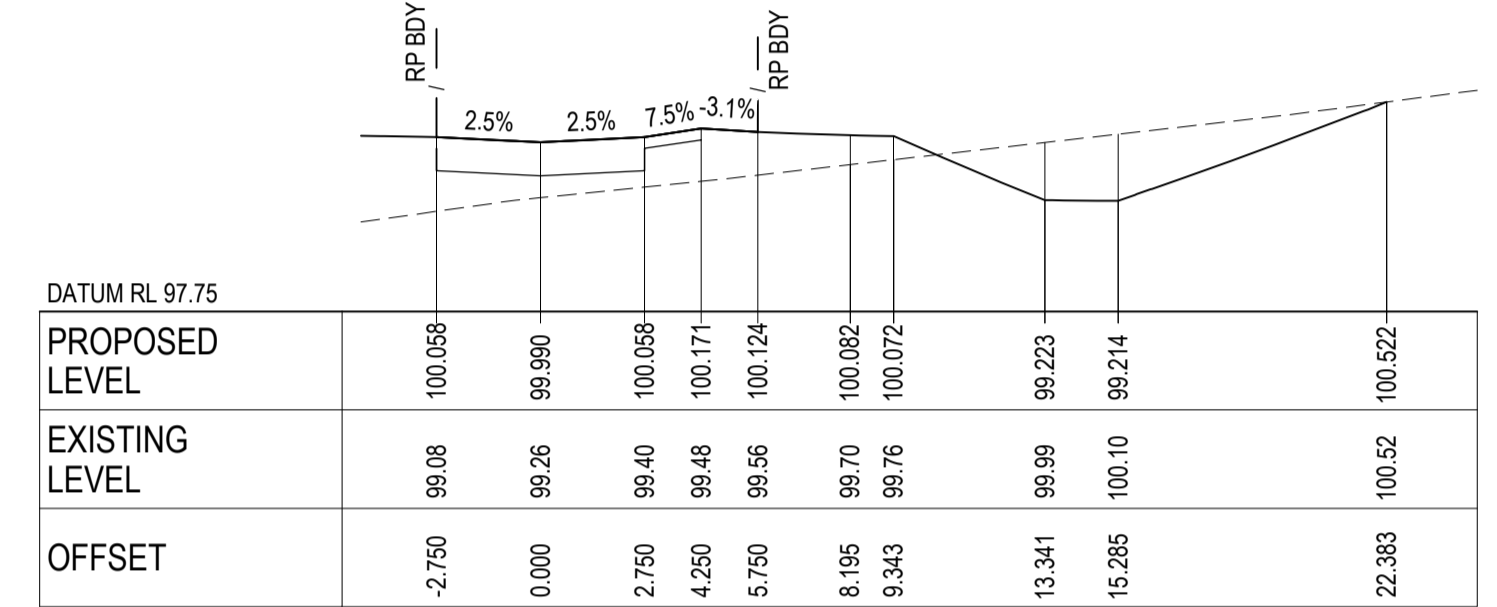

CH 61.425

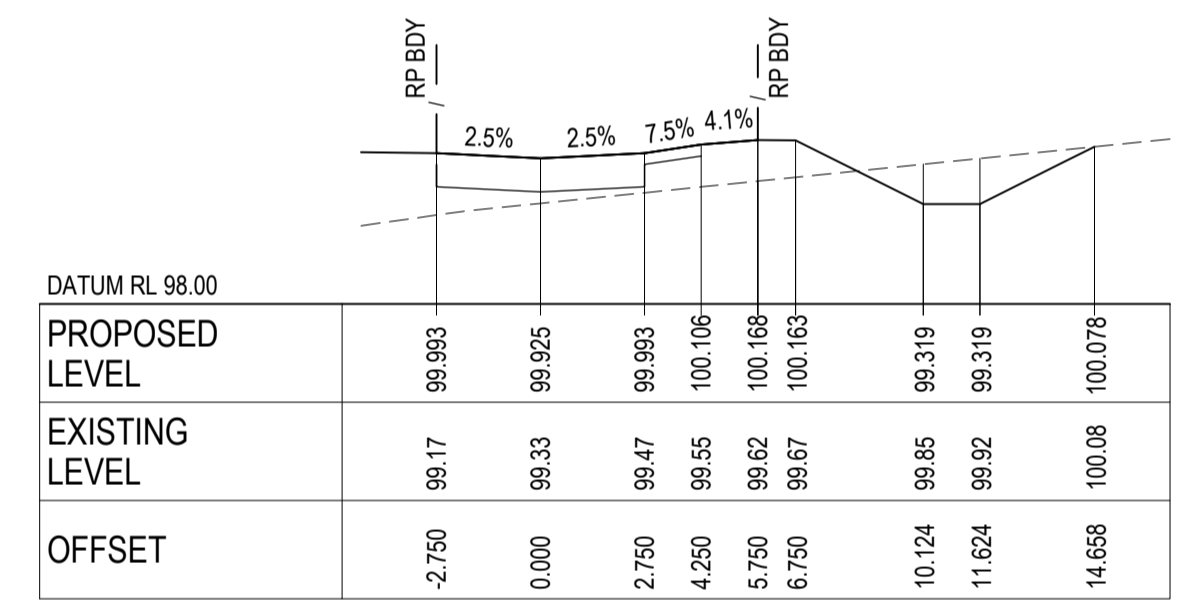

CH 48.425

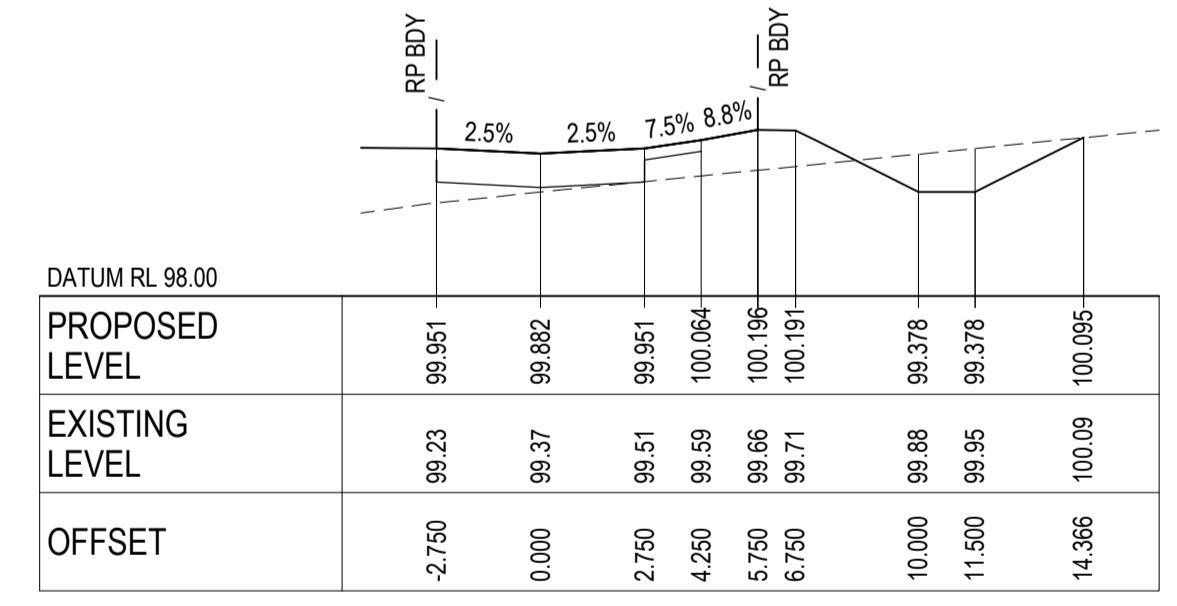


CH 40.000

**NUGGETTY LANE (MC11) - CROSS SECTIONS**

SCALE 1:200 HORI.  
 1:100 VERT.

**AS CONSTRUCTED RECORDS**  
 THE OBJECTIVE OF THESE 'AS-CONSTRUCTED DRAWINGS' IS TO REFLECT ANY SIGNIFICANT CHANGES TO THE APPROVED CONSTRUCTION DRAWINGS AND PROVIDE COUNCIL WITH A RECORD OF DESIGN INTENT. ANY LEVELS AND COORDINATES SHOWN ON THESE PLANS ARE SUBJECT TO SURVEY AND WILL DIFFER. ARCADIS ACCEPTS NO RESPONSIBILITY FOR LOSS OR DAMAGES RESULTING FROM THE INTERPRETATION OF THESE DRAWINGS. ALL DETAILS AND ASSETS MUST BE ASCERTAINED AND VERIFIED BY THE END USER.

Issue	Description	By	Ckd	PM	Date
B	AS CONSTRUCTED	WB	ZS	SE	07.10.21
A	ISSUED FOR CONSTRUCTION	WB	ZS	SE	04.12.20
03	UPDATES TO ADDRESS COUNCIL COMMENTS	WB	ZS	SE	03.08.20
02	ISSUED FOR APPROVAL	WB	ZS	SE	10.07.20
01	ISSUED TO CLIENT FOR REVIEW	WB	ZS	SE	07.11.19

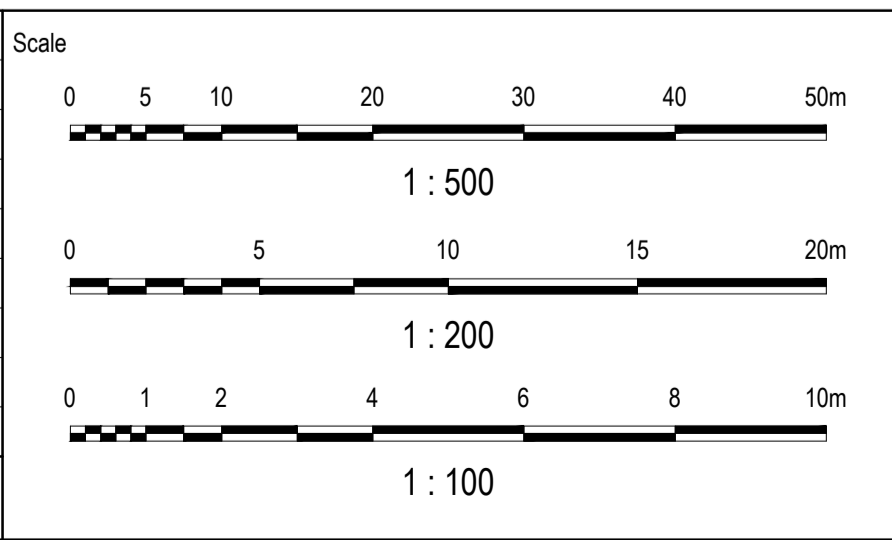

Planner  
**RD RobertsDay**  
*planning.design.place*


Client  
**RESIMAX GROUP**

Status: **AS CONSTRUCTED**  
 Verifier: **Z.STROGUSZ**  
 Scales: **AS SHOWN**  
 Original Size: **A1**  
 Height Datum: **AHD**  
 Grid: **MGA**

Project: **EYNESBURY TOWNSHIP STAGE 8C**  
 Title: **NUGGETTY LANE ROAD LONGITUDINAL AND CROSS SECTIONS**

**ARCADIS**  
 Arcadis Australia Pacific Pty Limited  
 Level 32, 140 William Street  
 Melbourne VIC 3000  
 ABN 76 104 485 289  
 Tel No: +61 3 8623 4000  
 www.arcadis.com


Drawing No. **C-08C-244** Project No. **10029435** Issue **B**

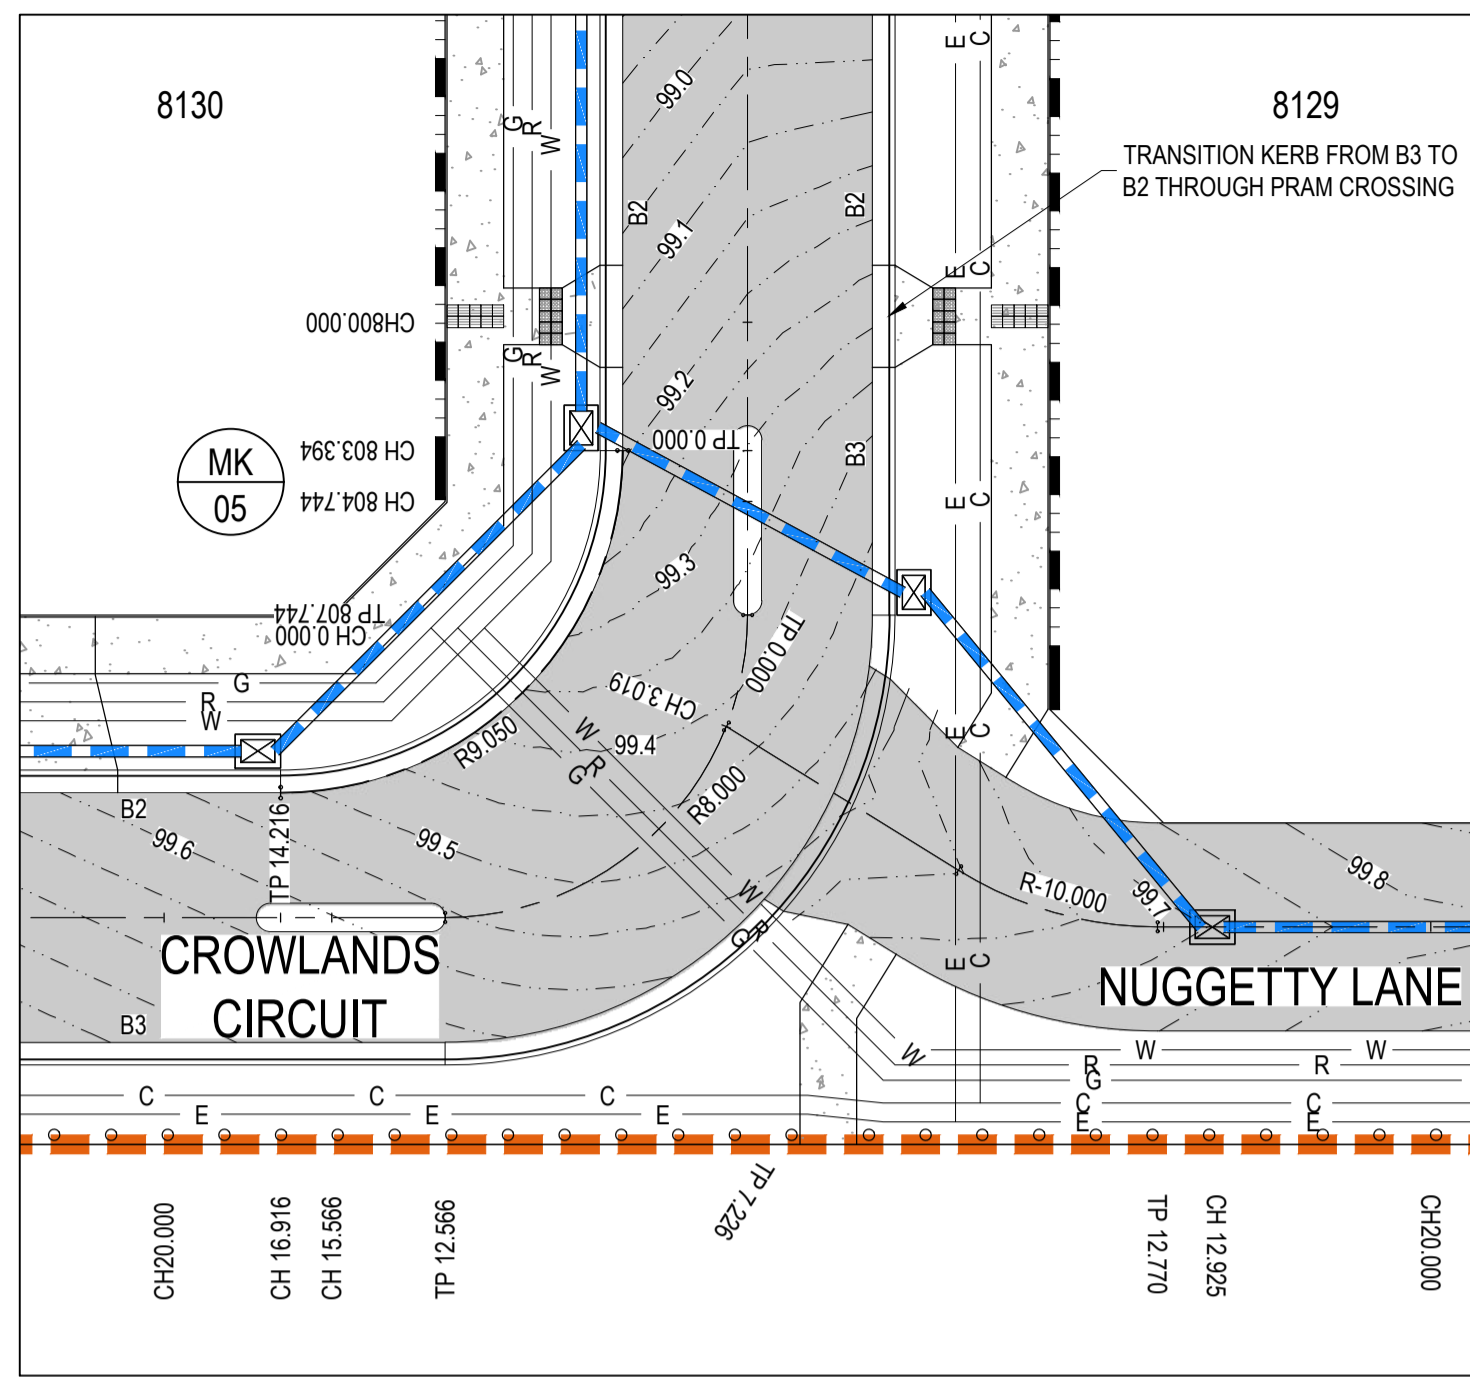

CROWLANDS CIRCUIT - NUGGETTY LANE INTERSECTION DETAIL  
SCALE 1:200

Vertical Curve Length (m)  
Vertical Curve Radius (m)  
Vertical Grade (%)  
Vertical Grade (1 in ...)  
Horizontal Curve Radius (m)  
DATUM RL.95.000

DESIGN LEVELS ON KERB LIP LINE
EXISTING SURFACE ON KERB LIP LINE
PEGGED CHAINAGE

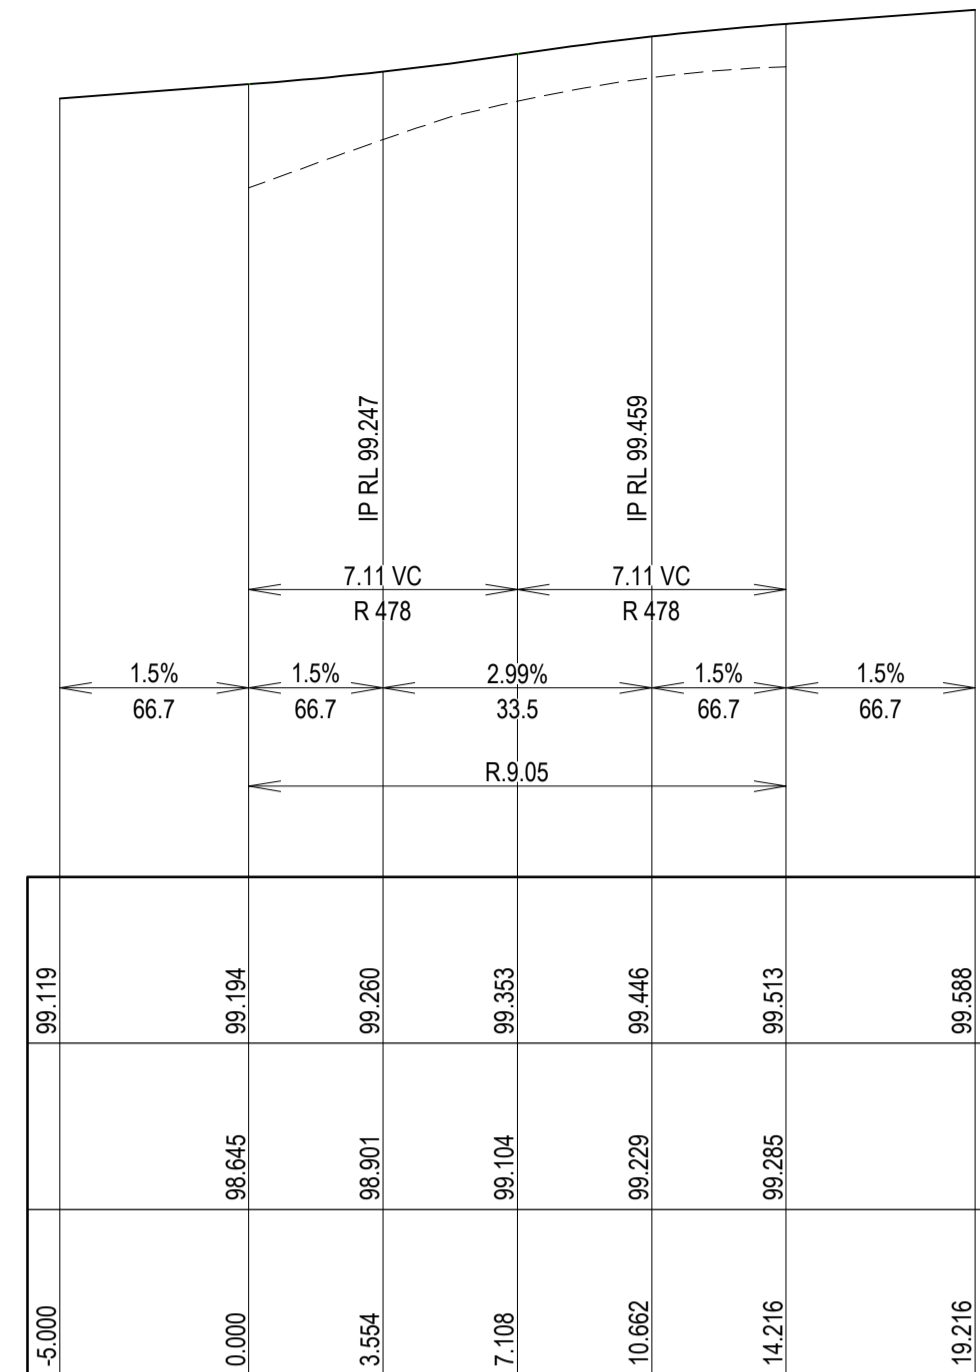


MK05 - LONGITUDINAL SECTION  
SCALE: HORIZONTAL - 1:200  
VERTICAL - 1:40

PT	CHAINAGE	EASTING	NORTHING	HEIGHT	BEARING	RADIUS	A.LENGTH	DEFL.ANGLE
IP 1	0.000	283690.341	5814245.827	99.194	209°57'20.00"			
IP 2	7.108	283685.822	5814237.986	99.353		R = 9.050	14.216	90°00'00.00"
IP 3	14.216	283677.981	5814242.505	99.513	299°57'20.00"			

**AS CONSTRUCTED RECORDS**  
THE OBJECTIVE OF THESE 'AS-CONSTRUCTED DRAWINGS' IS TO REFLECT ANY SIGNIFICANT CHANGES TO THE APPROVED CONSTRUCTION DRAWINGS AND PROVIDE COUNCIL WITH A RECORD OF DESIGN INTENT. ANY LEVELS AND COORDINATES SHOWN ON THESE PLANS ARE SUBJECT TO SURVEY AND WILL DIFFER. ARCADIS ACCEPTS NO RESPONSIBILITY FOR LOSS OR DAMAGES RESULTING FROM THE INTERPRETATION OF THESE DRAWINGS. ALL DETAILS AND ASSETS MUST BE ASCERTAINED AND VERIFIED BY THE END USER.

	STAGE BOUNDARY
	PROPOSED SURFACE CONTOURS
	PROPOSED KERB & CHANNEL
	PROPOSED STORMWATER DRAINAGE
	PROPOSED SEWERAGE RETICULATION
	PROPOSED ROAD PAVEMENT
	PROPOSED CONCRETE FOOTPATH/DRIVEWAY
	PROPOSED WATER RETICULATION
	PROPOSED RECYCLED WATER RETICULATION
	PROPOSED ELECTRICITY UNDER GROUND
	PROPOSED COMMUNICATIONS
	PROPOSED GAS RETICULATION
	BOLLARD
	EXISTING STORMWATER DRAINAGE
	EXISTING SEWER RETICULATION
	EXISTING WATER RETICULATION
	EXISTING RECYCLED WATER RETICULATION
	EXISTING ELECTRICITY UNDER GROUND
	EXISTING COMMUNICATIONS
	EXISTING GAS RETICULATION


**NOTES:**  
1. REFER TO SHEET C-08C-002 FOR GENERAL NOTES.

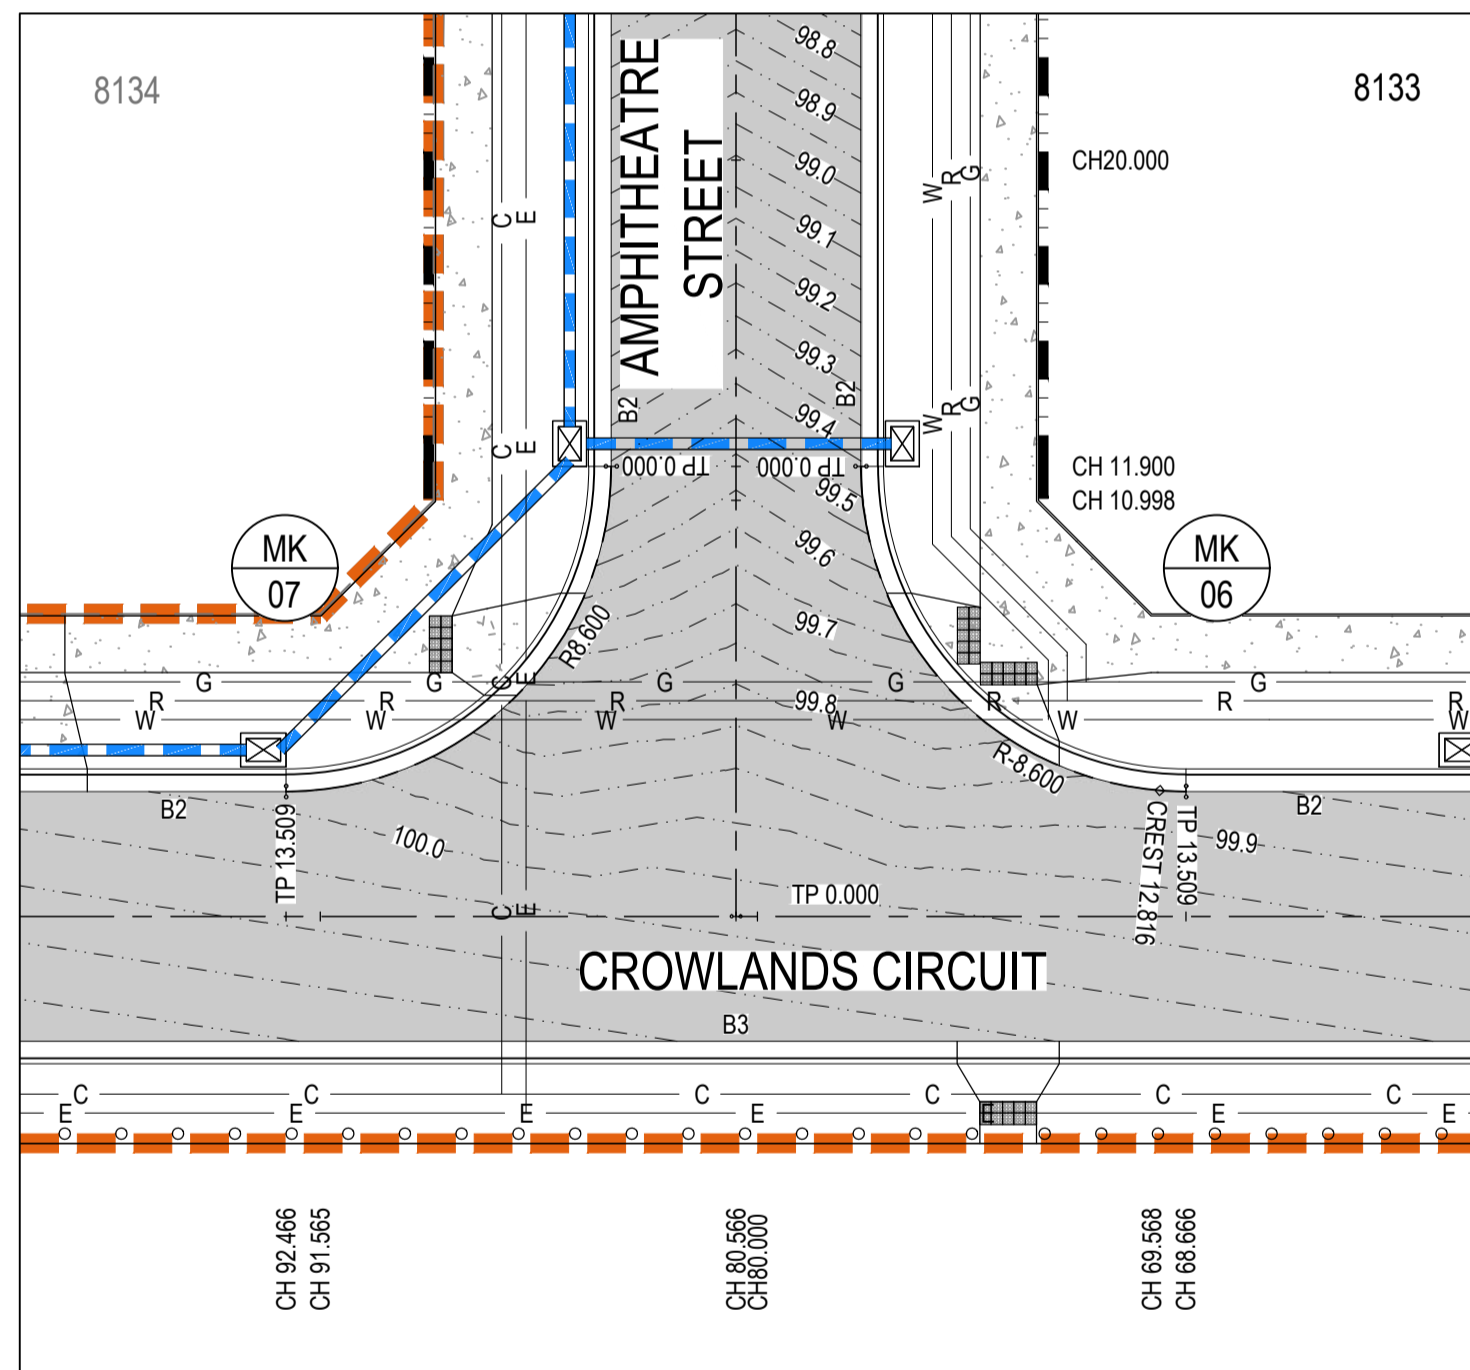

CROWLANDS CIRCUIT - AMPHITHEATRE STREET INTERSECTION DETAIL  
SCALE 1:200

Vertical Curve Length (m)  
Vertical Curve Radius (m)  
Vertical Grade (%)  
Vertical Grade (1 in ...)  
Horizontal Curve Radius (m)  
DATUM RL.96.000

DESIGN LEVELS ON KERB LIP LINE
EXISTING SURFACE ON KERB LIP LINE
PEGGED CHAINAGE

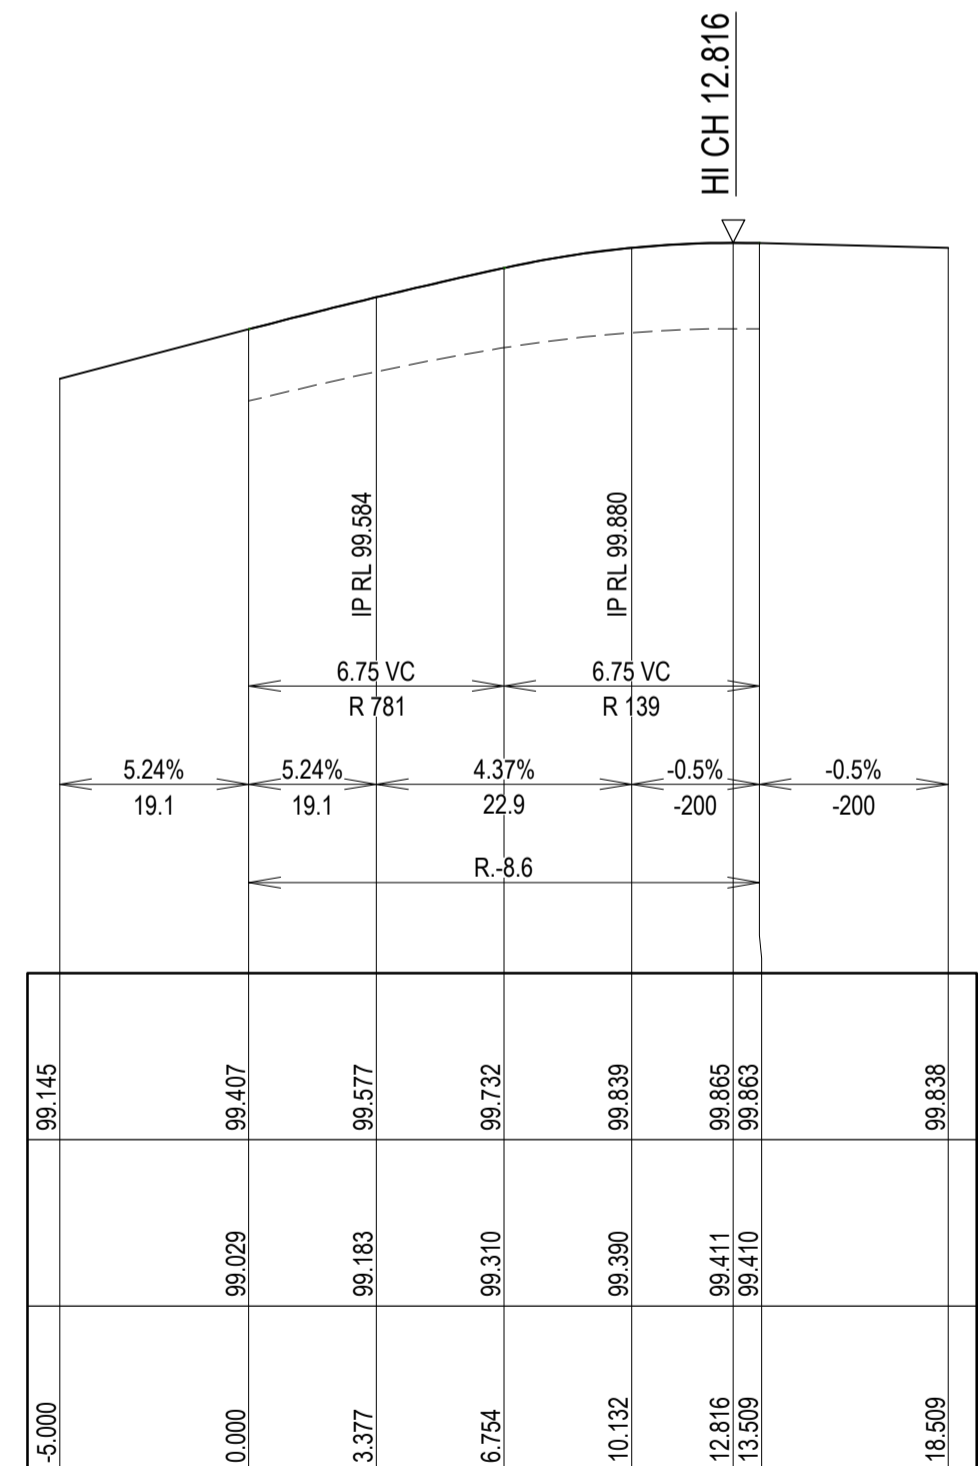


MK06 - LONGITUDINAL SECTION  
SCALE: HORIZONTAL - 1:200  
VERTICAL - 1:40

PT	CHAINAGE	EASTING	NORTHING	HEIGHT	BEARING	RADIUS	A.LENGTH	DEFL.ANGLE
IP 1	0.000	283629.987	5814280.090	99.407	209°57'20.00"			
IP 2	6.754	283625.693	5814272.639	99.732		R = -8.600	13.509	90°00'00.00"
IP 3	13.509	283633.144	5814268.345	99.863	119°57'20.00"			

Vertical Curve Length (m)  
Vertical Curve Radius (m)  
Vertical Grade (%)  
Vertical Grade (1 in ...)  
Horizontal Curve Radius (m)  
DATUM RL.96.000


DESIGN LEVELS ON KERB LIP LINE
EXISTING SURFACE ON KERB LIP LINE
PEGGED CHAINAGE

PT	CHAINAGE	EASTING	NORTHING	HEIGHT	BEARING	RADIUS	A.LENGTH	DEFL.ANGLE
IP 1	0.000	283624.269	5814283.386	99.407	209°57'20.00"			
IP 2	6.754	283619.974	5814275.935	99.775		R = 8.600	13.509	90°00'00.00"
IP 3	13.509	283612.523	5814280.229	99.982	299°57'20.00"			

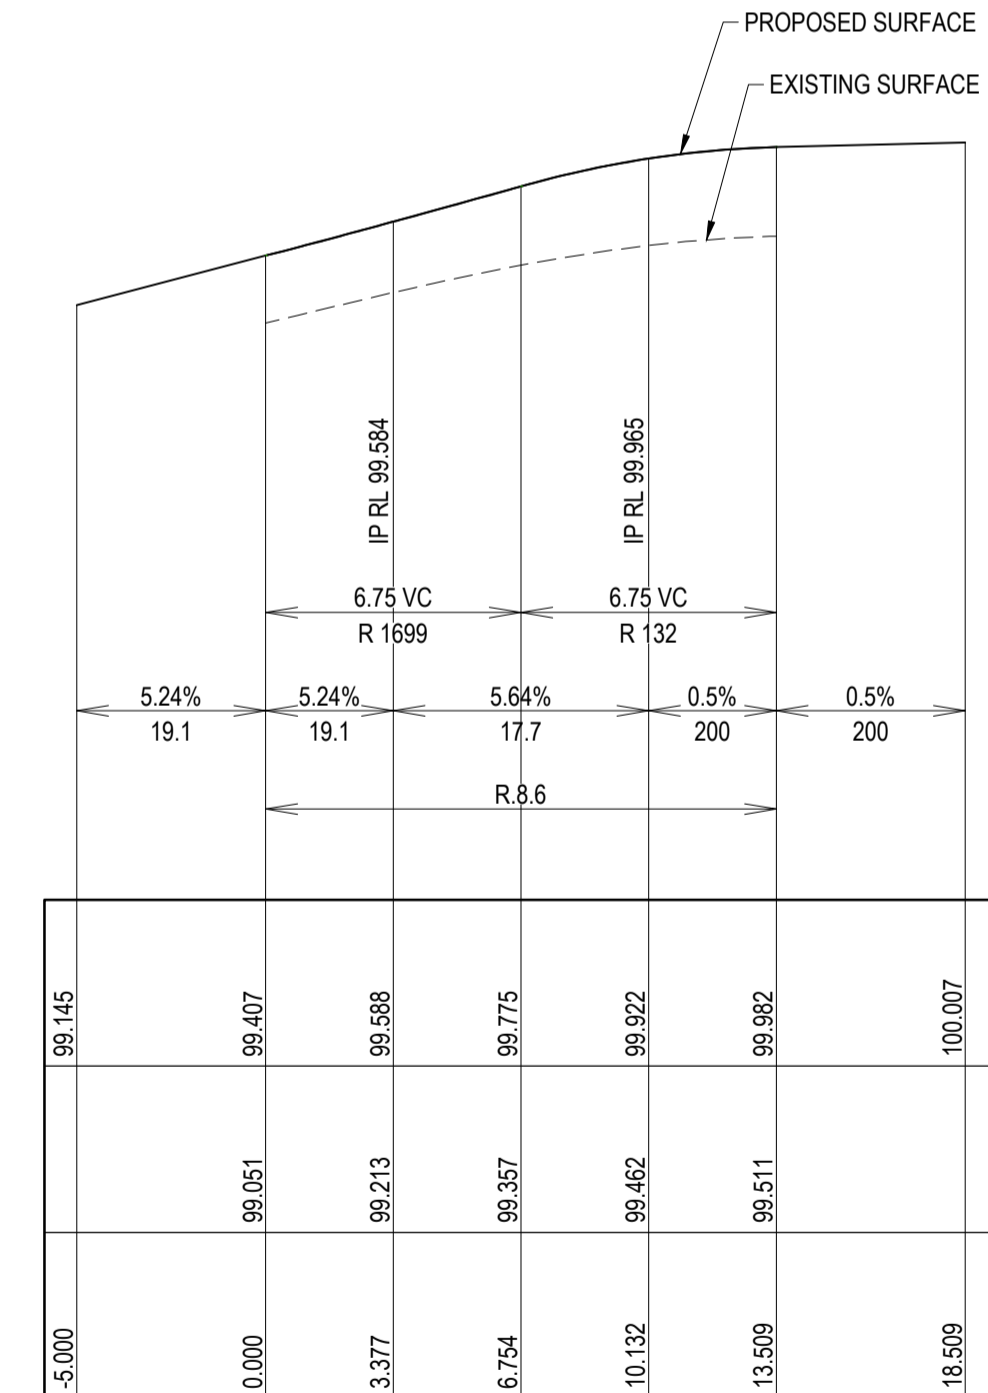

MK07 - LONGITUDINAL SECTION  
SCALE: HORIZONTAL - 1:200  
VERTICAL - 1:40

Issue	Description	By	Ckd	PM	Date
B	AS CONSTRUCTED	WB	ZS	SE	07.10.21
A	ISSUED FOR CONSTRUCTION	WB	ZS	SE	04.12.20
04	UPDATES TO ADDRESS COUNCIL COMMENTS	HP	ZS	SE	19.08.20
03	UPDATES TO ADDRESS COUNCIL COMMENTS	WB	ZS	SE	03.08.20
02	ISSUED FOR APPROVAL	WB	ZS	SE	10.07.20
01	ISSUED TO CLIENT FOR REVIEW	WB	ZS	SE	07.11.19

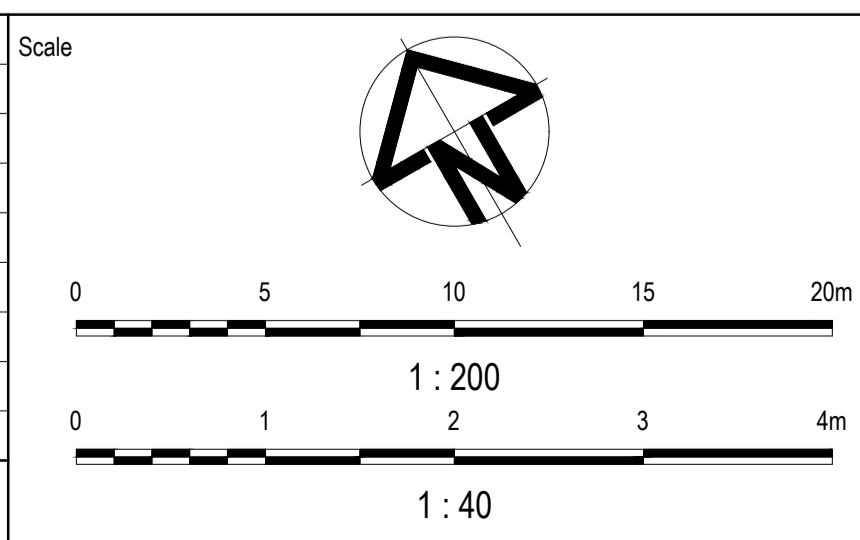


Planner  
**RD** RobertsDay  
planning.design.place

Client  
**RESIMAX**  
GROUP

Status: **AS CONSTRUCTED**  
Verifier: Z.STROGUSZ  
Scales: 1:200, 1:40  
Original Issue Signatures: Drawn W.BUMAGAT, Designed J.ROCK  
Height Datum: AHD, Project Manager S.EISEL  
Grid: MGA

Project: EYNEBURY TOWNSHIP  
STAGE 8C  
Title: INTERSECTION DETAILS  
SHEET 1 OF 2


**ARCADIS**  
Arcadis Australia Pacific Pty Limited  
Level 32, 140 William Street  
Melbourne VIC 3000  
ABN 76 104 485 289  
Tel No: +61 3 8623 4000  
www.arcadis.com  
Drawing No: C-08C-260, Project No: 10029435, Issue: B

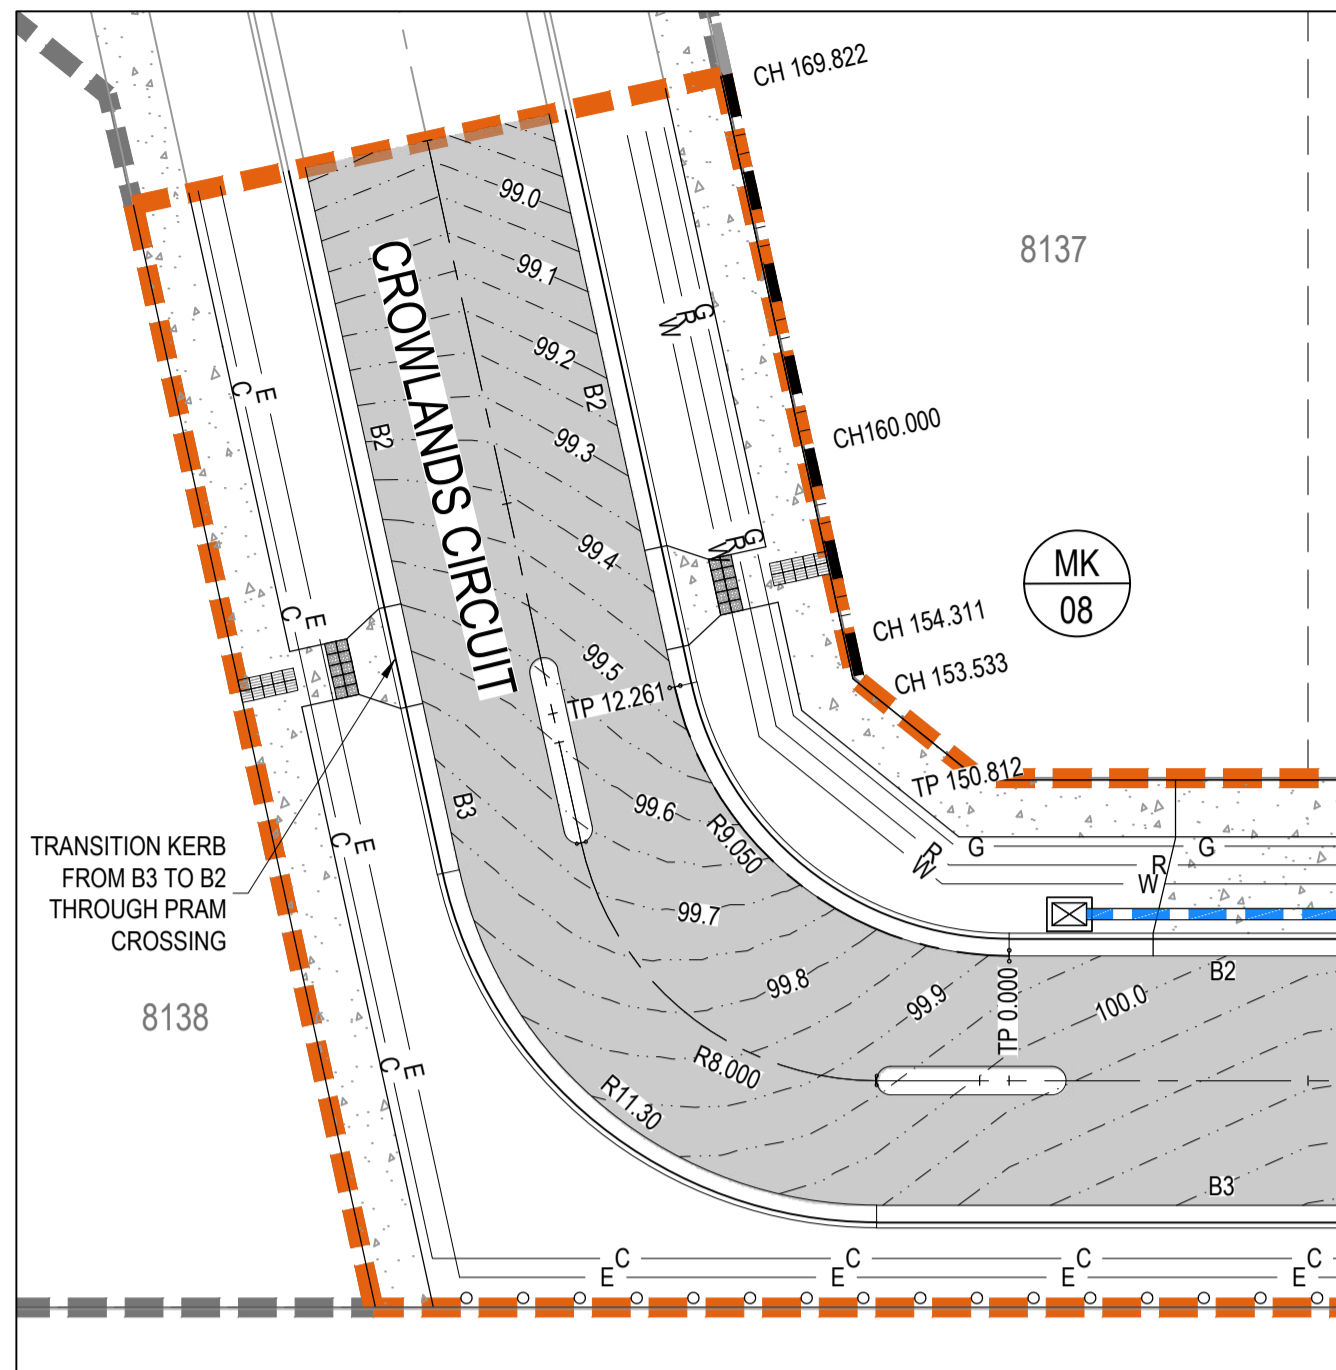

**CROWLANDS CIRCUIT BEND DETAIL**  
SCALE 1:200

Vertical Curve Length (m)  
Vertical Curve Radius (m)  
Vertical Grade (%)  
Vertical Grade (1 in ...)  
Horizontal Curve Radius (m)  
DATUM RL.96.000

DESIGN LEVELS ON KERB LIP LINE
EXISTING SURFACE ON KERB LIP LINE
PEGGED CHAINAGE

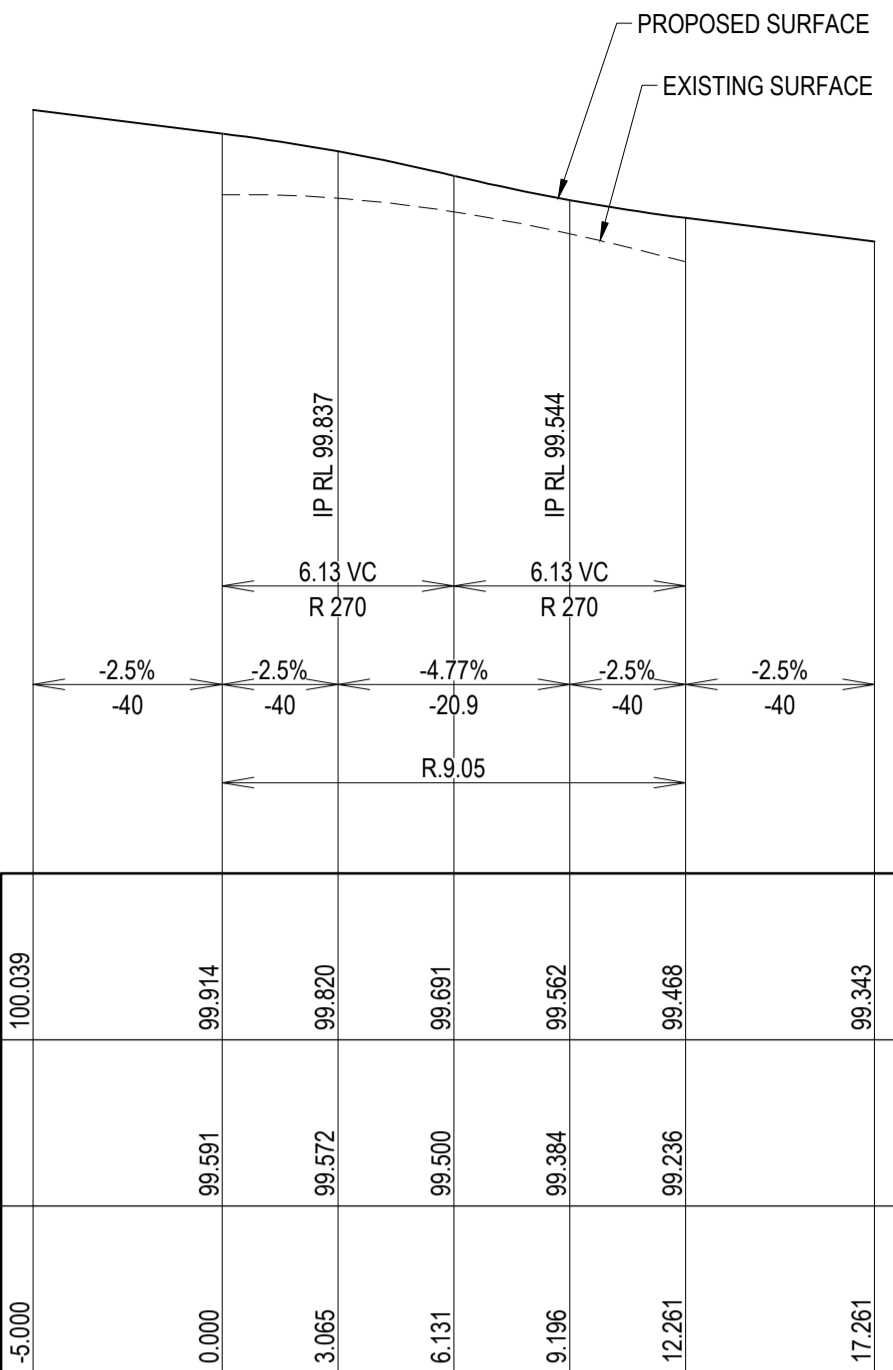


**MK08 - LONGITUDINAL SECTION**  
SCALE: HORIZONTAL - 1:200  
VERTICAL - 1:40

CONTROL LINE SETOUT TABLE - MK08								
PT	CHAINAGE	EASTING	NORTHING	HEIGHT	BEARING	RADIUS	A.LENGTH	DEFL.ANGLE
IP 1	0.000	283574.394	5814302.203	99.914	299°57'20.00"			
IP 2	6.131	283568.087	5814305.838	99.691		R = 9.050	12.261	77°37'30.42"
IP 3	12.261	283570.286	5814312.778	99.468	17°34'50.42"			

**LEGEND**

- STAGE BOUNDARY
- 5.0 PROPOSED SURFACE CONTOURS
- PROPOSED KERB & CHANNEL
- PROPOSED STORMWATER DRAINAGE
- S PROPOSED SEWERAGE RETICULATION
- PROPOSED ROAD PAVEMENT
- PROPOSED CONCRETE FOOTPATH/DRIVEWAY
- W PROPOSED WATER RETICULATION
- R PROPOSED RECYCLED WATER RETICULATION
- E PROPOSED ELECTRICITY UNDER GROUND
- C PROPOSED COMMUNICATIONS
- G PROPOSED GAS RETICULATION
- BOLLARD
- SWD EXISTING STORMWATER DRAINAGE
- S EXISTING SEWER RETICULATION
- W EXISTING WATER RETICULATION
- R EXISTING RECYCLED WATER RETICULATION
- e EXISTING ELECTRICITY UNDER GROUND
- T EXISTING COMMUNICATIONS
- g EXISTING GAS RETICULATION


**NOTES:**  
1. REFER TO SHEET C-08C-002 FOR GENERAL NOTES.

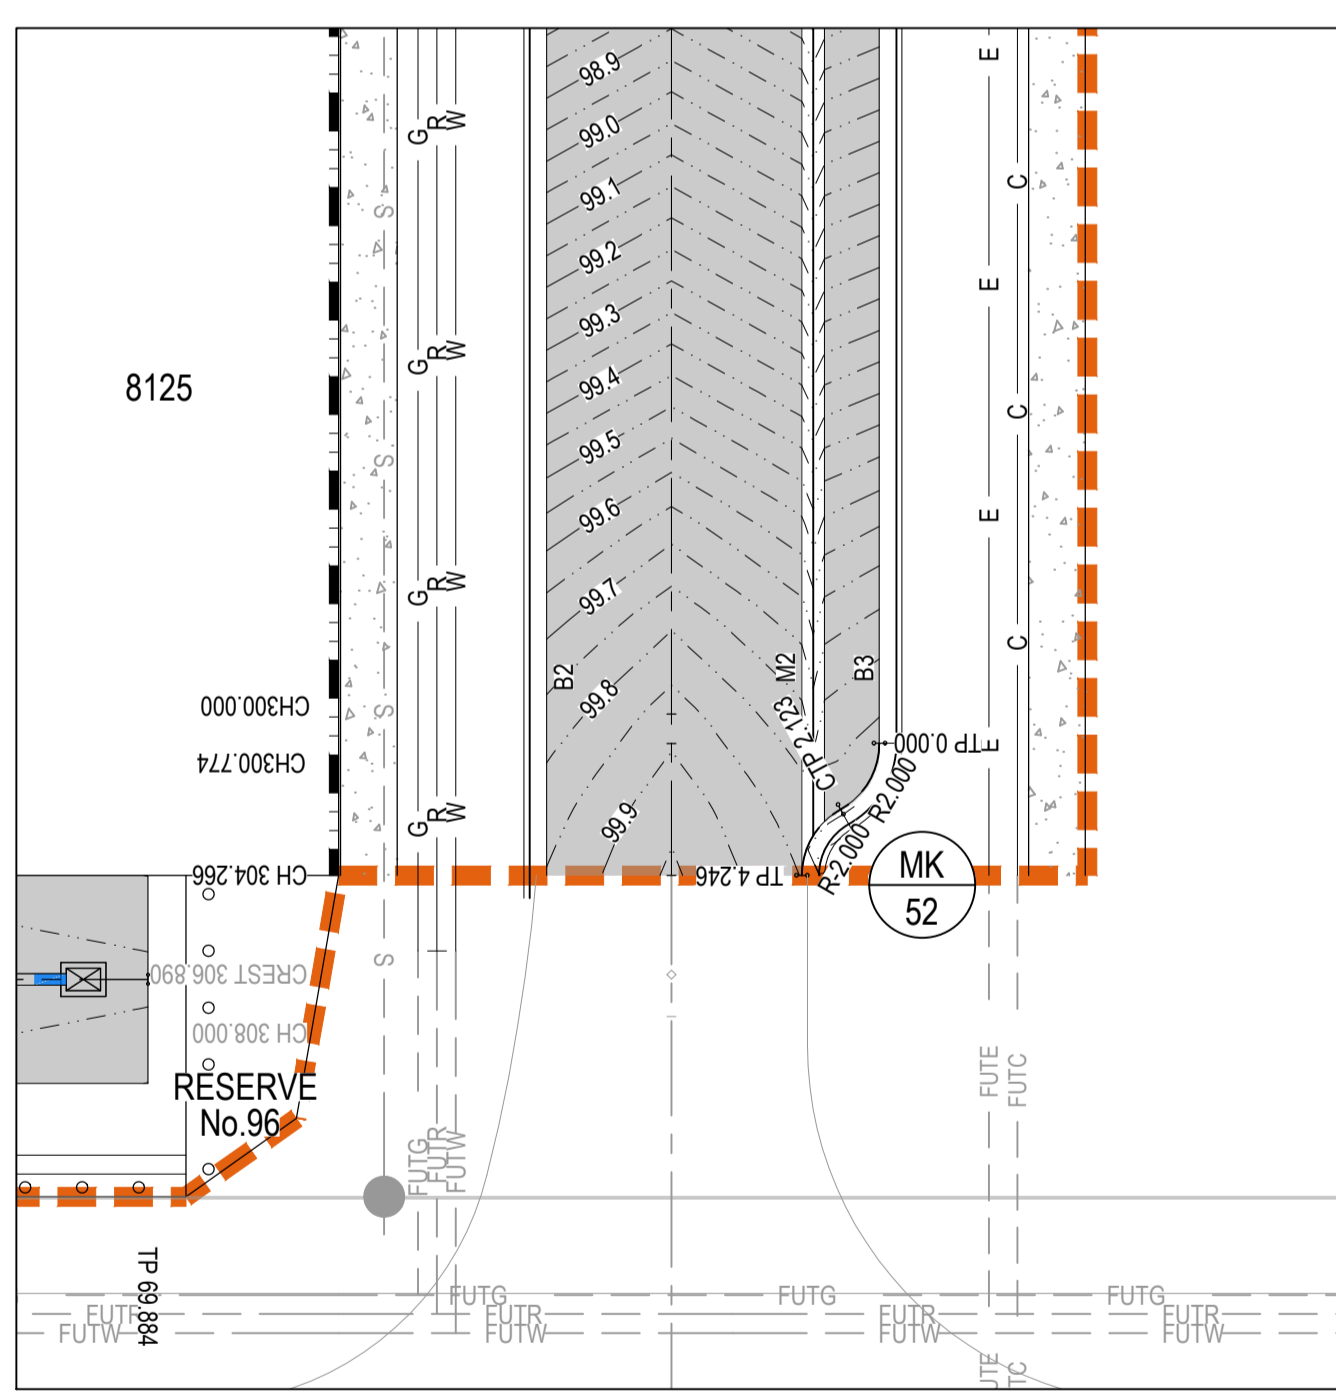

**CROWLANDS CIRCUIT BEND DETAIL**  
SCALE 1:200

Vertical Curve Length (m)  
Vertical Curve Radius (m)  
Vertical Grade (%)  
Vertical Grade (1 in ...)  
Horizontal Curve Radius (m)  
DATUM RL.95.000

DESIGN LEVELS ON KERB LIP LINE
EXISTING SURFACE ON KERB LIP LINE
PEGGED CHAINAGE

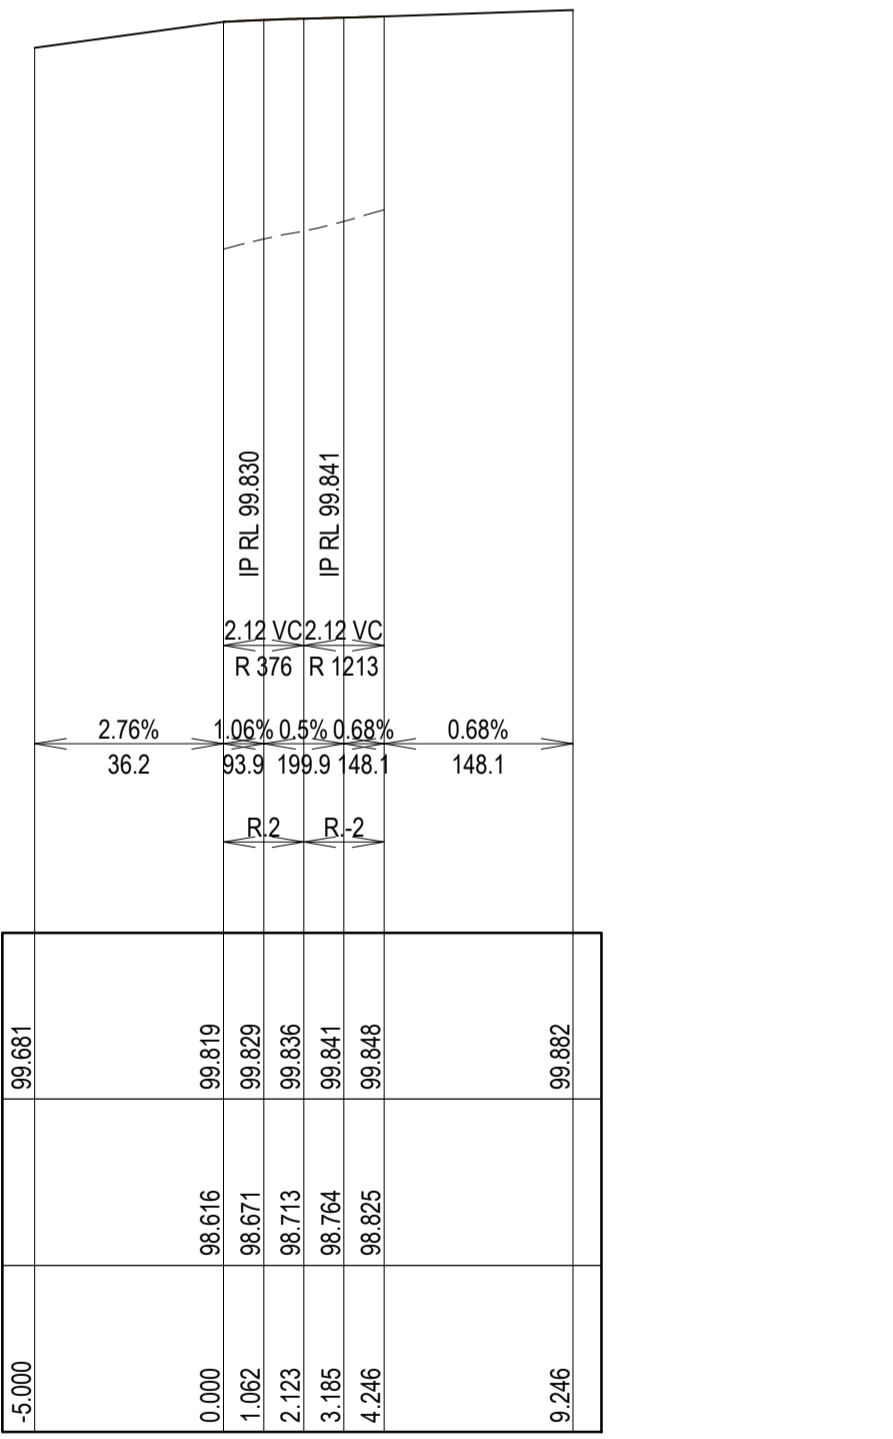


**MK52 - LONGITUDINAL SECTION**  
SCALE: HORIZONTAL - 1:200  
VERTICAL - 1:40

**AS CONSTRUCTED RECORDS**  
THE OBJECTIVE OF THESE 'AS-CONSTRUCTED DRAWINGS' IS TO REFLECT ANY SIGNIFICANT CHANGES TO THE APPROVED CONSTRUCTION DRAWINGS AND PROVIDE COUNCIL WITH A RECORD OF DESIGN INTENT. ANY LEVELS AND COORDINATES SHOWN ON THESE PLANS ARE SUBJECT TO SURVEY AND WILL DIFFER. ARCADIS ACCEPTS NO RESPONSIBILITY FOR LOSS OR DAMAGES RESULTING FROM THE INTERPRETATION OF THESE DRAWINGS. ALL DETAILS AND ASSETS MUST BE ASCERTAINED AND VERIFIED BY THE END USER.

CONTROL LINE SETOUT TABLE - MK52								
PT	CHAINAGE	EASTING	NORTHING	HEIGHT	BEARING	RADIUS	A.LENGTH	DEFL.ANGLE
IP 1	0.000	283765.663	5814195.079	99.819	209°57'20.00"			
IP 2	1.062	283765.077	5814194.062	99.829		R = 2.000	2.123	60°49'24.98"
CC	2.123	283763.903	5814194.078	99.836	270°46'44.97"			
IP 3	3.185	283762.729	5814194.094	99.841		R = -2.000	2.123	60°49'24.98"
IP 4	4.246	283762.143	5814193.077	99.848	209°57'20.00"			

Issue	Description	By	Ckd	PM	Date
C	AS CONSTRUCTED	WB	ZS	SE	07.10.21
B	UPDATES TO LOT 8138	WB	ZS	SE	12.08.21
A	ISSUED FOR CONSTRUCTION	WB	ZS	SE	04.12.20
04	UPDATES TO ADDRESS COUNCIL COMMENTS	HP	ZS	SE	19.08.20
03	UPDATES TO ADDRESS COUNCIL COMMENTS	WB	ZS	SE	03.08.20
02	ISSUED FOR APPROVAL	WB	ZS	SE	10.07.20
01	ISSUED TO CLIENT FOR REVIEW	WB	ZS	SE	07.11.19

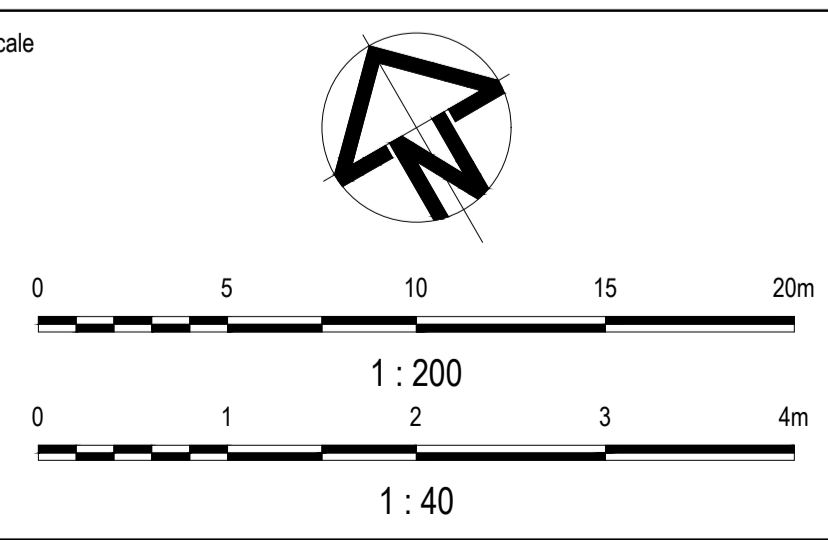

Planner

**RD RobertsDay**  
planning-design-place

Client

**RESIMAX GROUP**

Filename C-08c-261-10029435-Intersection.dwg

Status: **AS CONSTRUCTED**

Verifier: **Z.STROGUSZ**

Scales: 1:200, 1:40

Original Issue Signatures: Drawn W.BUMAGAT, Designed J.ROCK

Original Size: **A1**

Height Datum: AHD

Grid: MGA

Project Manager: S.EISEL

Copyright reserved




Project: **EYNESBURY TOWNSHIP STAGE 8C**

Title: **INTERSECTION DETAILS SHEET 2 OF 2**

**ARCADIS**

Arcadis Australia Pacific Pty Limited  
Level 32, 140 William Street  
Melbourne VIC 3000  
ABN 76 104 485 289  
Tel No: +61 3 8623 4000  
www.arcadis.com

Drawing No: **C-08C-261** | Project No: **10029435** | Issue: **C**

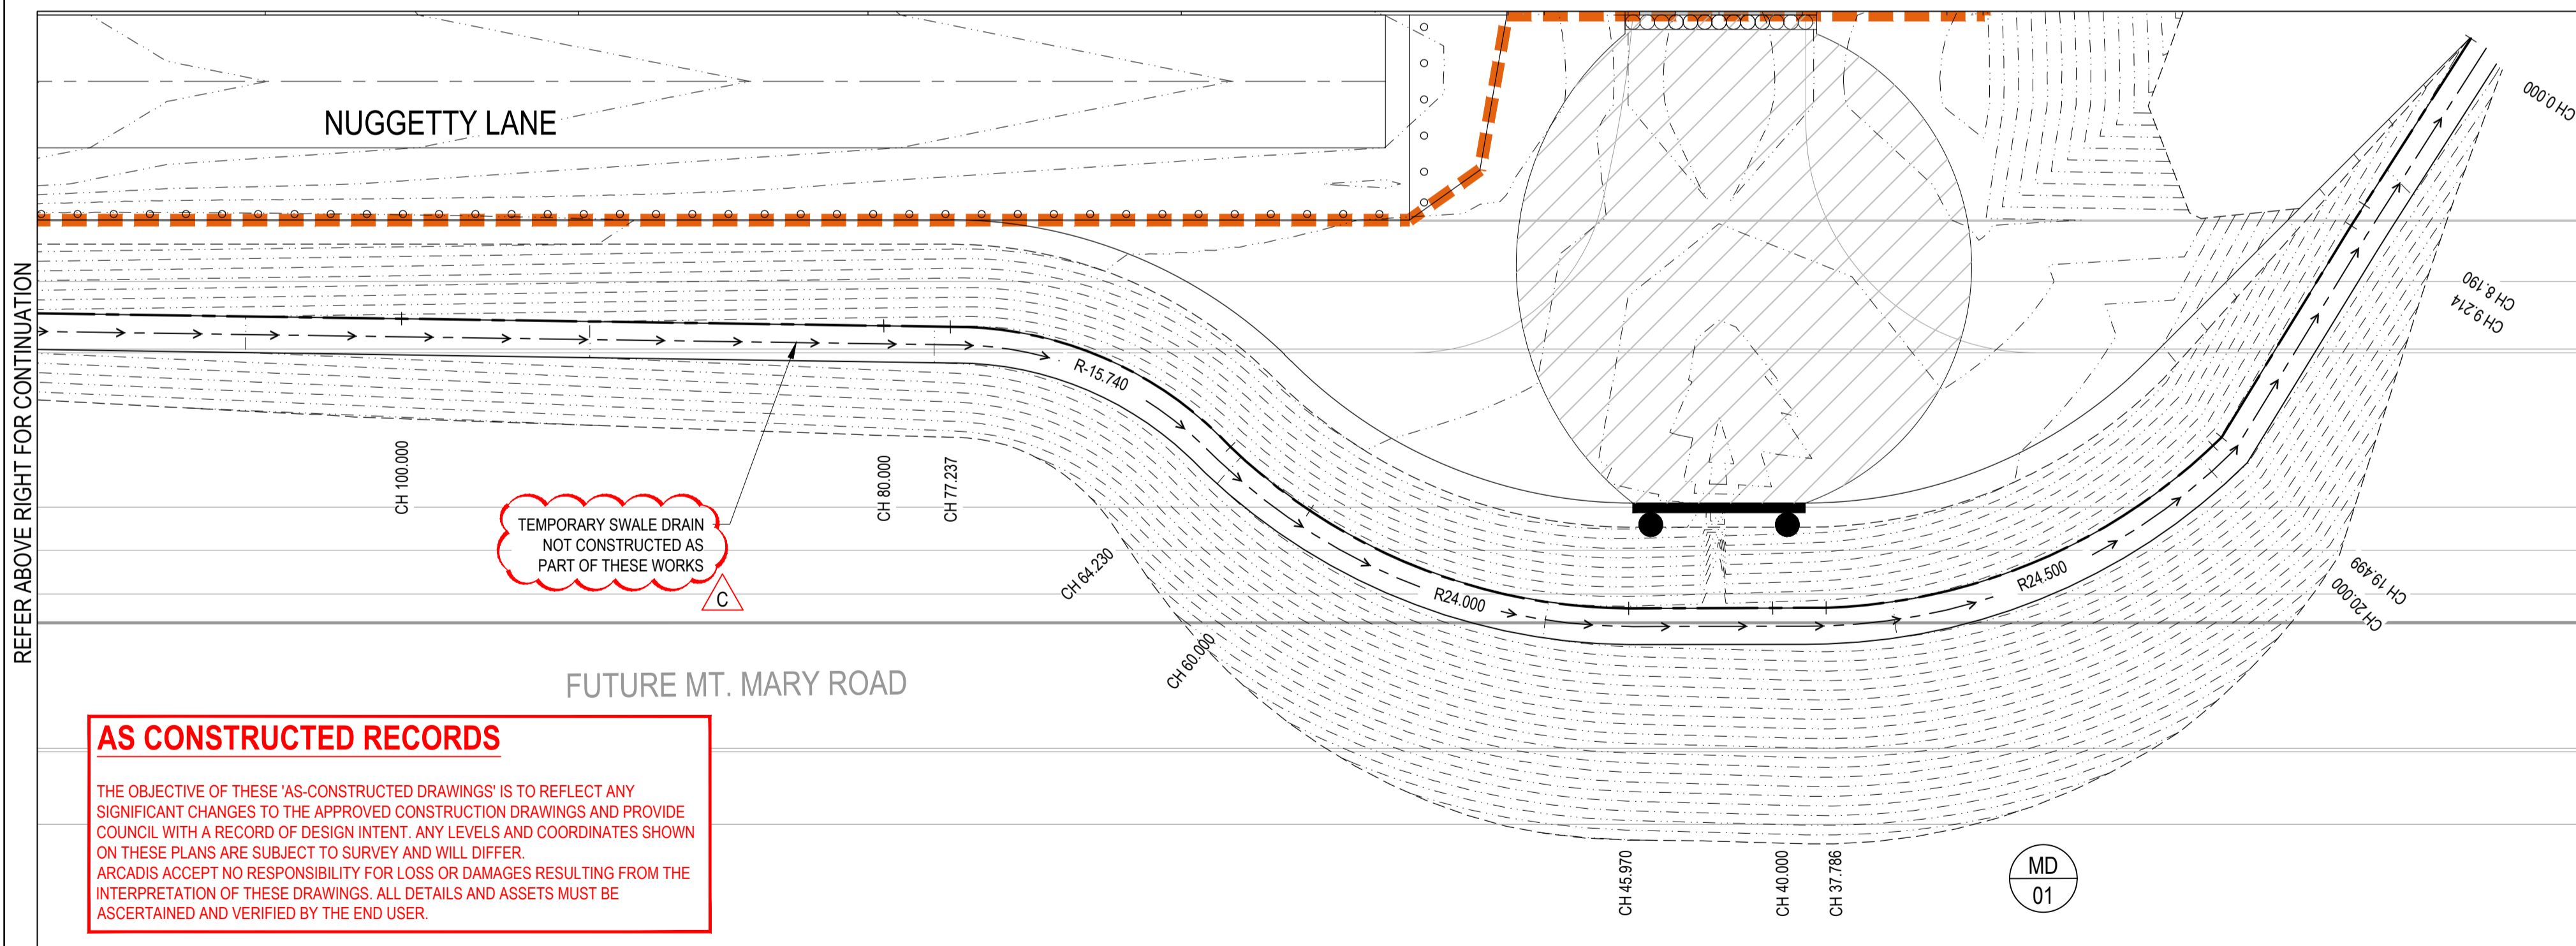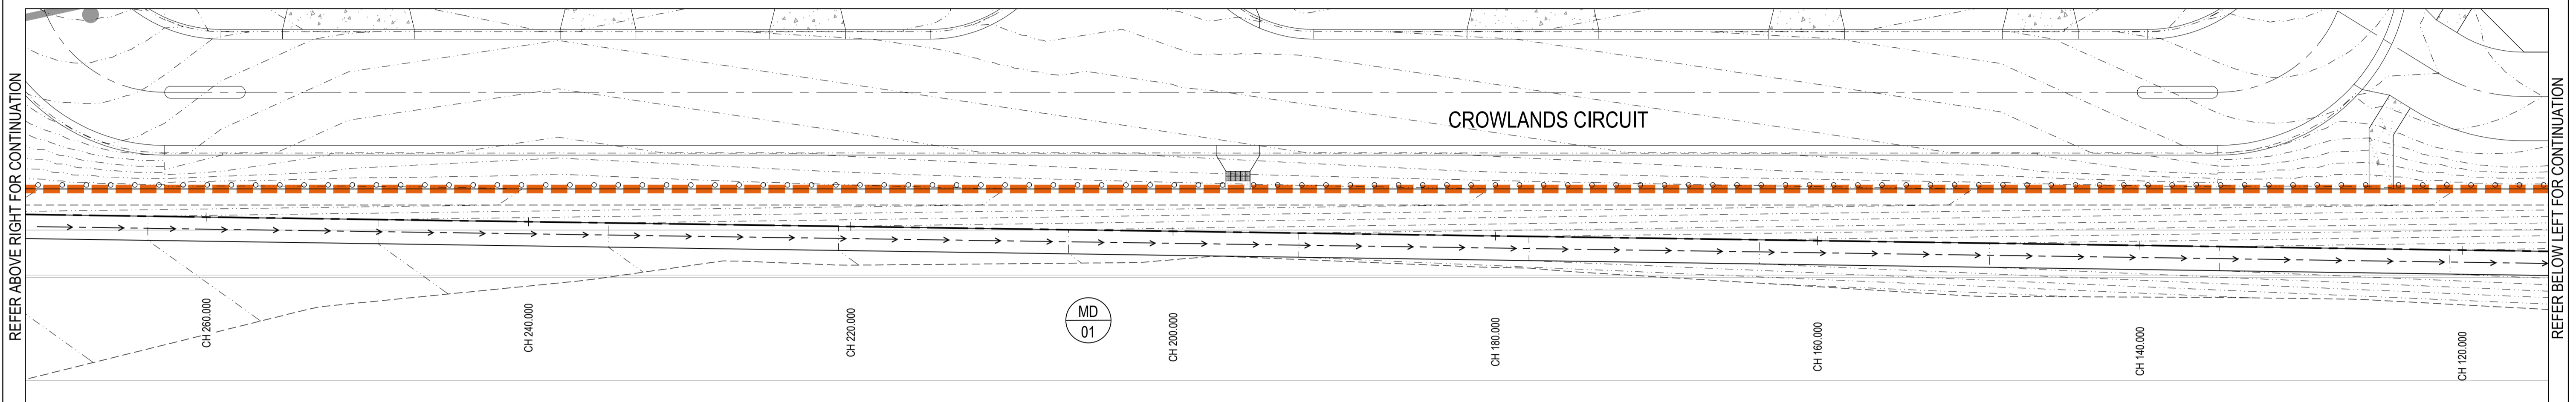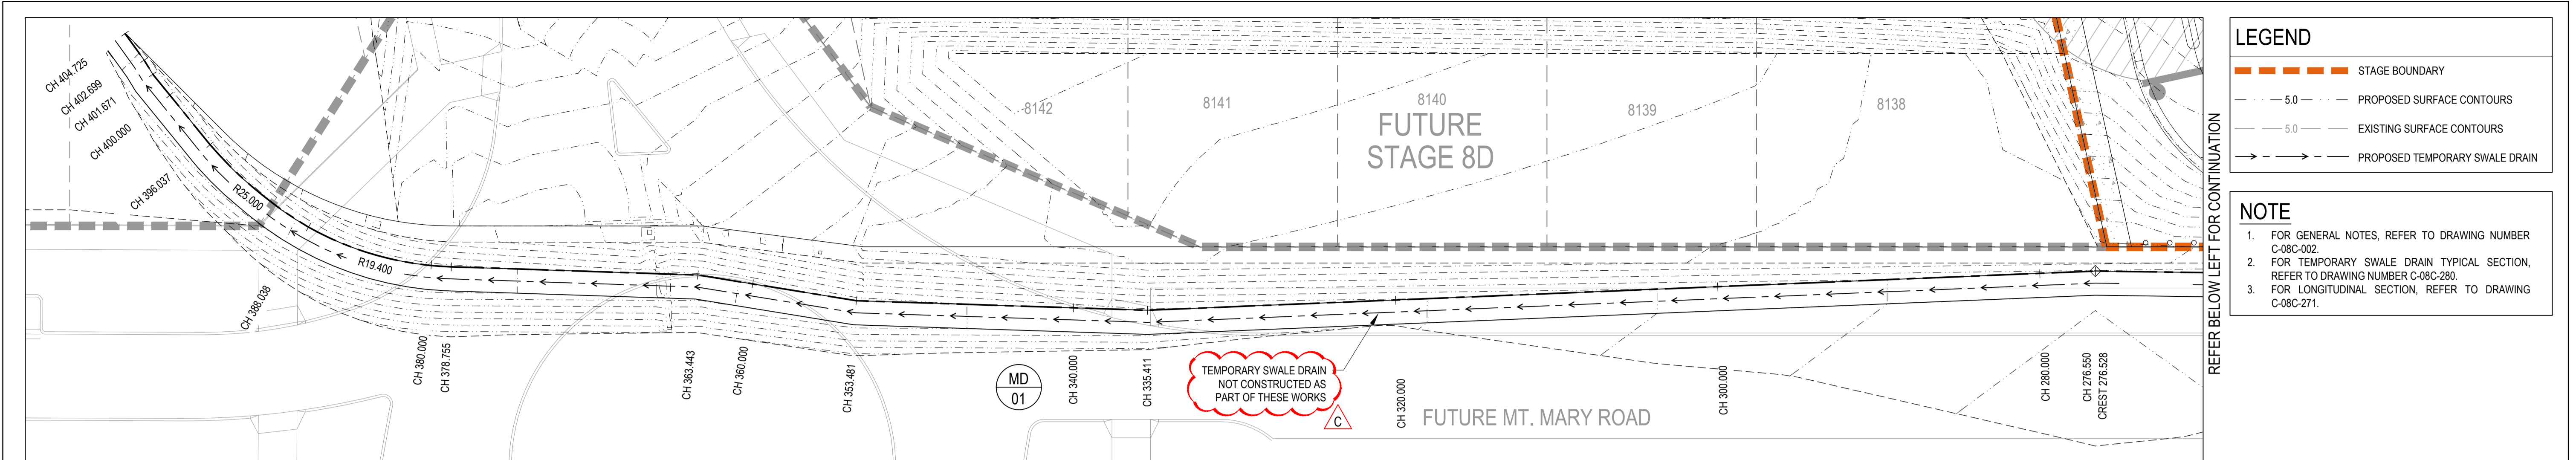


**CONTROL LINE SETOUT - MD01**

PT	CHAINAGE	EASTING	NORTHING	LEVEL	BEARING	RAD/SPIRAL	A LENGTH	DEFL. ANGLE
IP 1	0.000	283785.687	5814178.384	98.753	242°36'21.21"			
IP 2	8.190	283778.416	5814174.616	98.812				
IP 3	9.214	283777.508	5814174.141	98.819				
IP 4	19.499	283768.475	5814169.225	98.891				
IP 5	28.643	283759.197	5814166.781	98.955		R = 24.500	18.288	42°46'45.89°
IP 6	37.786	283750.728	5814171.289	99.019				
IP 7	45.970	283743.626	5814175.355	99.076				
IP 8	55.100	283735.344	5814180.196	99.140		R = 24.000	18.260	43°25'31.90°
IP 9	64.230	283732.657	5814189.406	99.204				
IP 10	70.734	283731.085	5814196.126	99.250		R = -15.750	13.008	47°20'58.61°
IP 11	77.237	283725.077	5814199.522	99.295				
IP 12	276.550	283553.869	5814301.567	100.690				
IP 13	335.411	283501.700	5814328.826	100.278				
IP 14	353.481	283486.348	5814338.356	100.152				
IP 15	363.443	283478.625	5814344.648	100.082				
IP 16	378.755	283465.620	5814352.730	99.975				
IP 17	383.396	283461.594	5814355.219	99.942		R = 19.400	9.284	27°28'10.97°
IP 18	388.038	283459.171	5814359.285	99.910				
IP 19	392.038	283457.197	5814362.803	99.882		R = 25.000	7.999	18°23'05.95°
IP 20	396.037	283456.434	5814366.764	99.854				
IP 21	401.671	283455.540	5814372.327	99.814				
IP 22	402.699	283455.512	5814373.354	99.807				
IP 23	404.725	283455.307	5814375.370	99.798	354°11'44.35°			

**AS CONSTRUCTED RECORDS**

THE OBJECTIVE OF THESE 'AS-CONSTRUCTED DRAWINGS' IS TO REFLECT ANY SIGNIFICANT CHANGES TO THE APPROVED CONSTRUCTION DRAWINGS AND PROVIDE COUNCIL WITH A RECORD OF DESIGN INTENT. ANY LEVELS AND COORDINATES SHOWN ON THESE PLANS ARE SUBJECT TO SURVEY AND WILL DIFFER. ARCADIS ACCEPTS NO RESPONSIBILITY FOR LOSS OR DAMAGES RESULTING FROM THE INTERPRETATION OF THESE DRAWINGS. ALL DETAILS AND ASSETS MUST BE ASCERTAINED AND VERIFIED BY THE END USER.

Issue	Description	By	Ckd	PM	Date
C	AS CONSTRUCTED	WB	ZS	SE	07.10.21
B	UPDATES TO LOT 8138	WB	ZS	SE	12.08.21
A	ISSUED FOR CONSTRUCTION	WB	ZS	SE	04.12.20
03	UPDATES TO ADDRESS COUNCIL COMMENTS	WB	ZS	SE	03.08.20
02	ISSUED FOR APPROVAL	WB	ZS	SE	10.07.20
01	ISSUED TO CLIENT FOR REVIEW	WB	ZS	SE	07.11.19

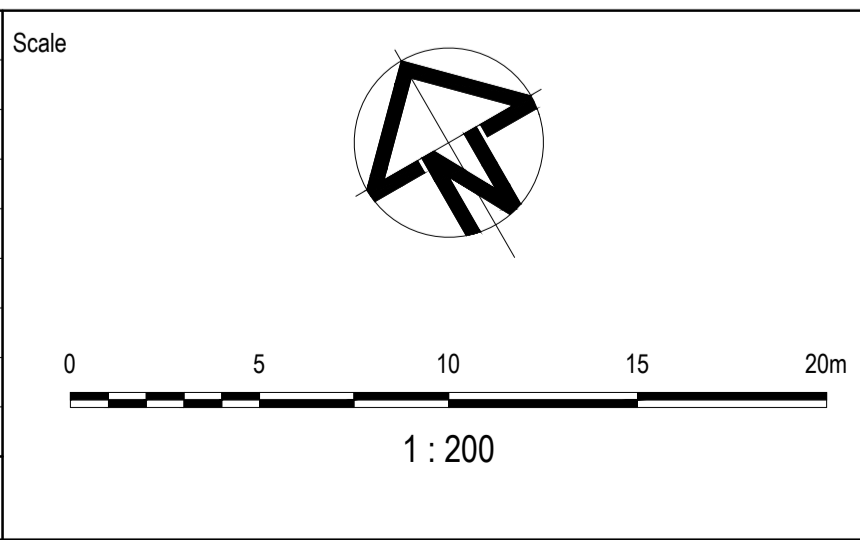

Planner

**RD** RobertsDay  
planning.design.place

Client

**RESIMAX**  
GROUP

Filename C-08c-270-10029435-SwaleDetails.dwg

Status: **AS CONSTRUCTED**

Verifier: Z.STROGUSZ

Scales: 1:200

Original Size: **A1**

Height Datum: AHD

Grid: MGA

Original Issue Signatures

Drawn: W.BUMAGAT

Designed: J.ROCK

Project Manager: S.EISEL

© Copyright reserved

Project: **EYNESBURY TOWNSHIP STAGE 8C**

Title: **SWALE DETAILS SHEET 1 OF 2**

**ARCADIS**

Arcadis Australia Pacific Pty Limited  
Level 32, 140 William Street  
Melbourne VIC 3000  
ABN 76 104 485 289  
Tel No: +61 3 8623 4000  
www.arcadis.com

Drawing No: **C-08C-270** Project No: **10029435** Issue: **C**


**NOTE**

1. FOR GENERAL NOTES, REFER TO DRAWING NUMBER C-08C-002.
2. FOR TEMPORARY SWALE DRAIN TYPICAL SECTION, REFER TO DRAWING NUMBER C-08C-280.
3. FOR SWALE DRAIN SETOUT, REFER TO DRAWING C-08C-270.

Vertical Curve Length (m)  
 Vertical Curve Radius (m)  
 Vertical Grade (%)  
 Vertical Grade (1 in ...)  
 Horizontal Curve Radius (m)


DATUM RL.91.000

DESIGN LEVELS ON CONTROL LINE
EXISTING SURFACE ON ROAD CENTRELINE
CUT / FILL DEPTH
PEGGED CHAINAGE

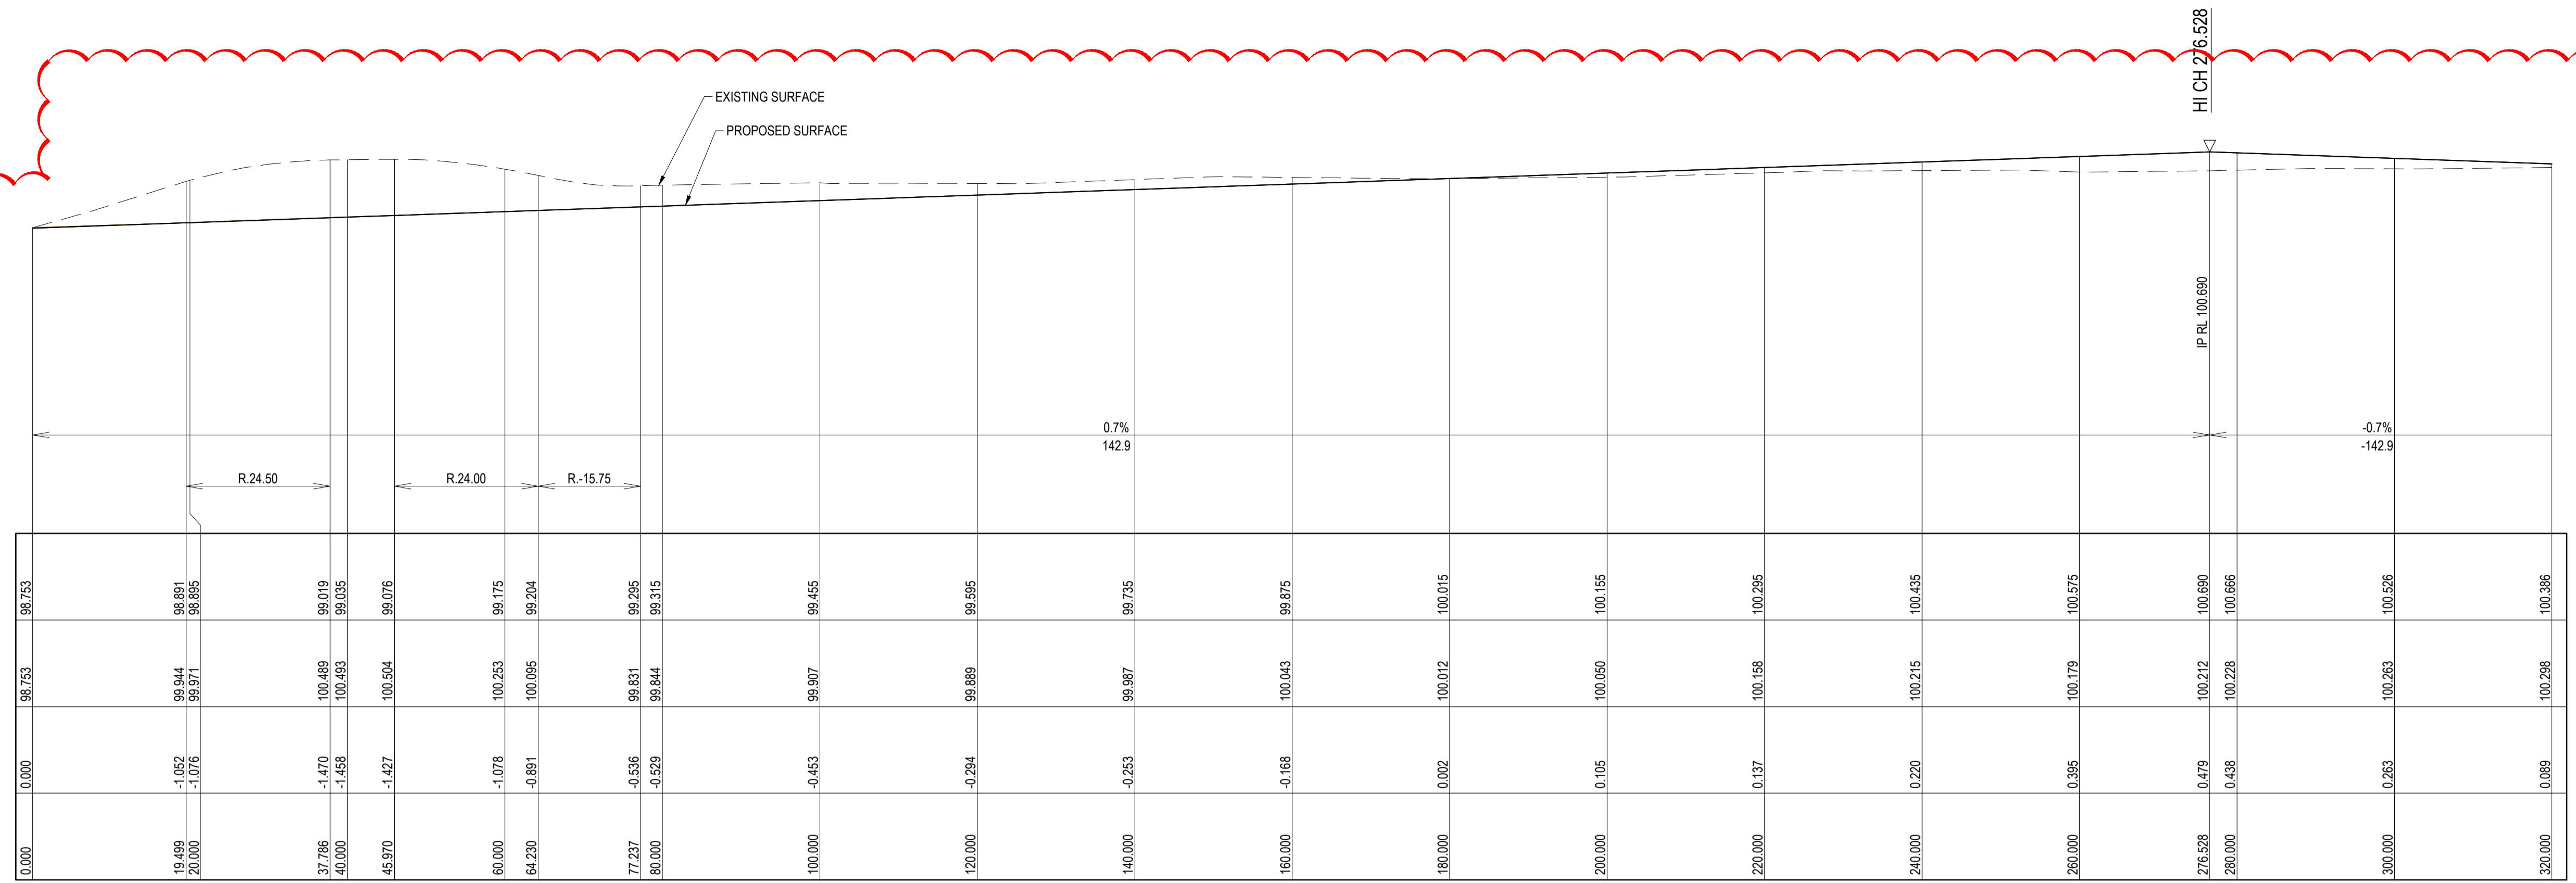

MD01 - LONGITUDINAL SECTION


SCALE: HORIZONTAL - 1:500  
 VERTICAL - 1:100

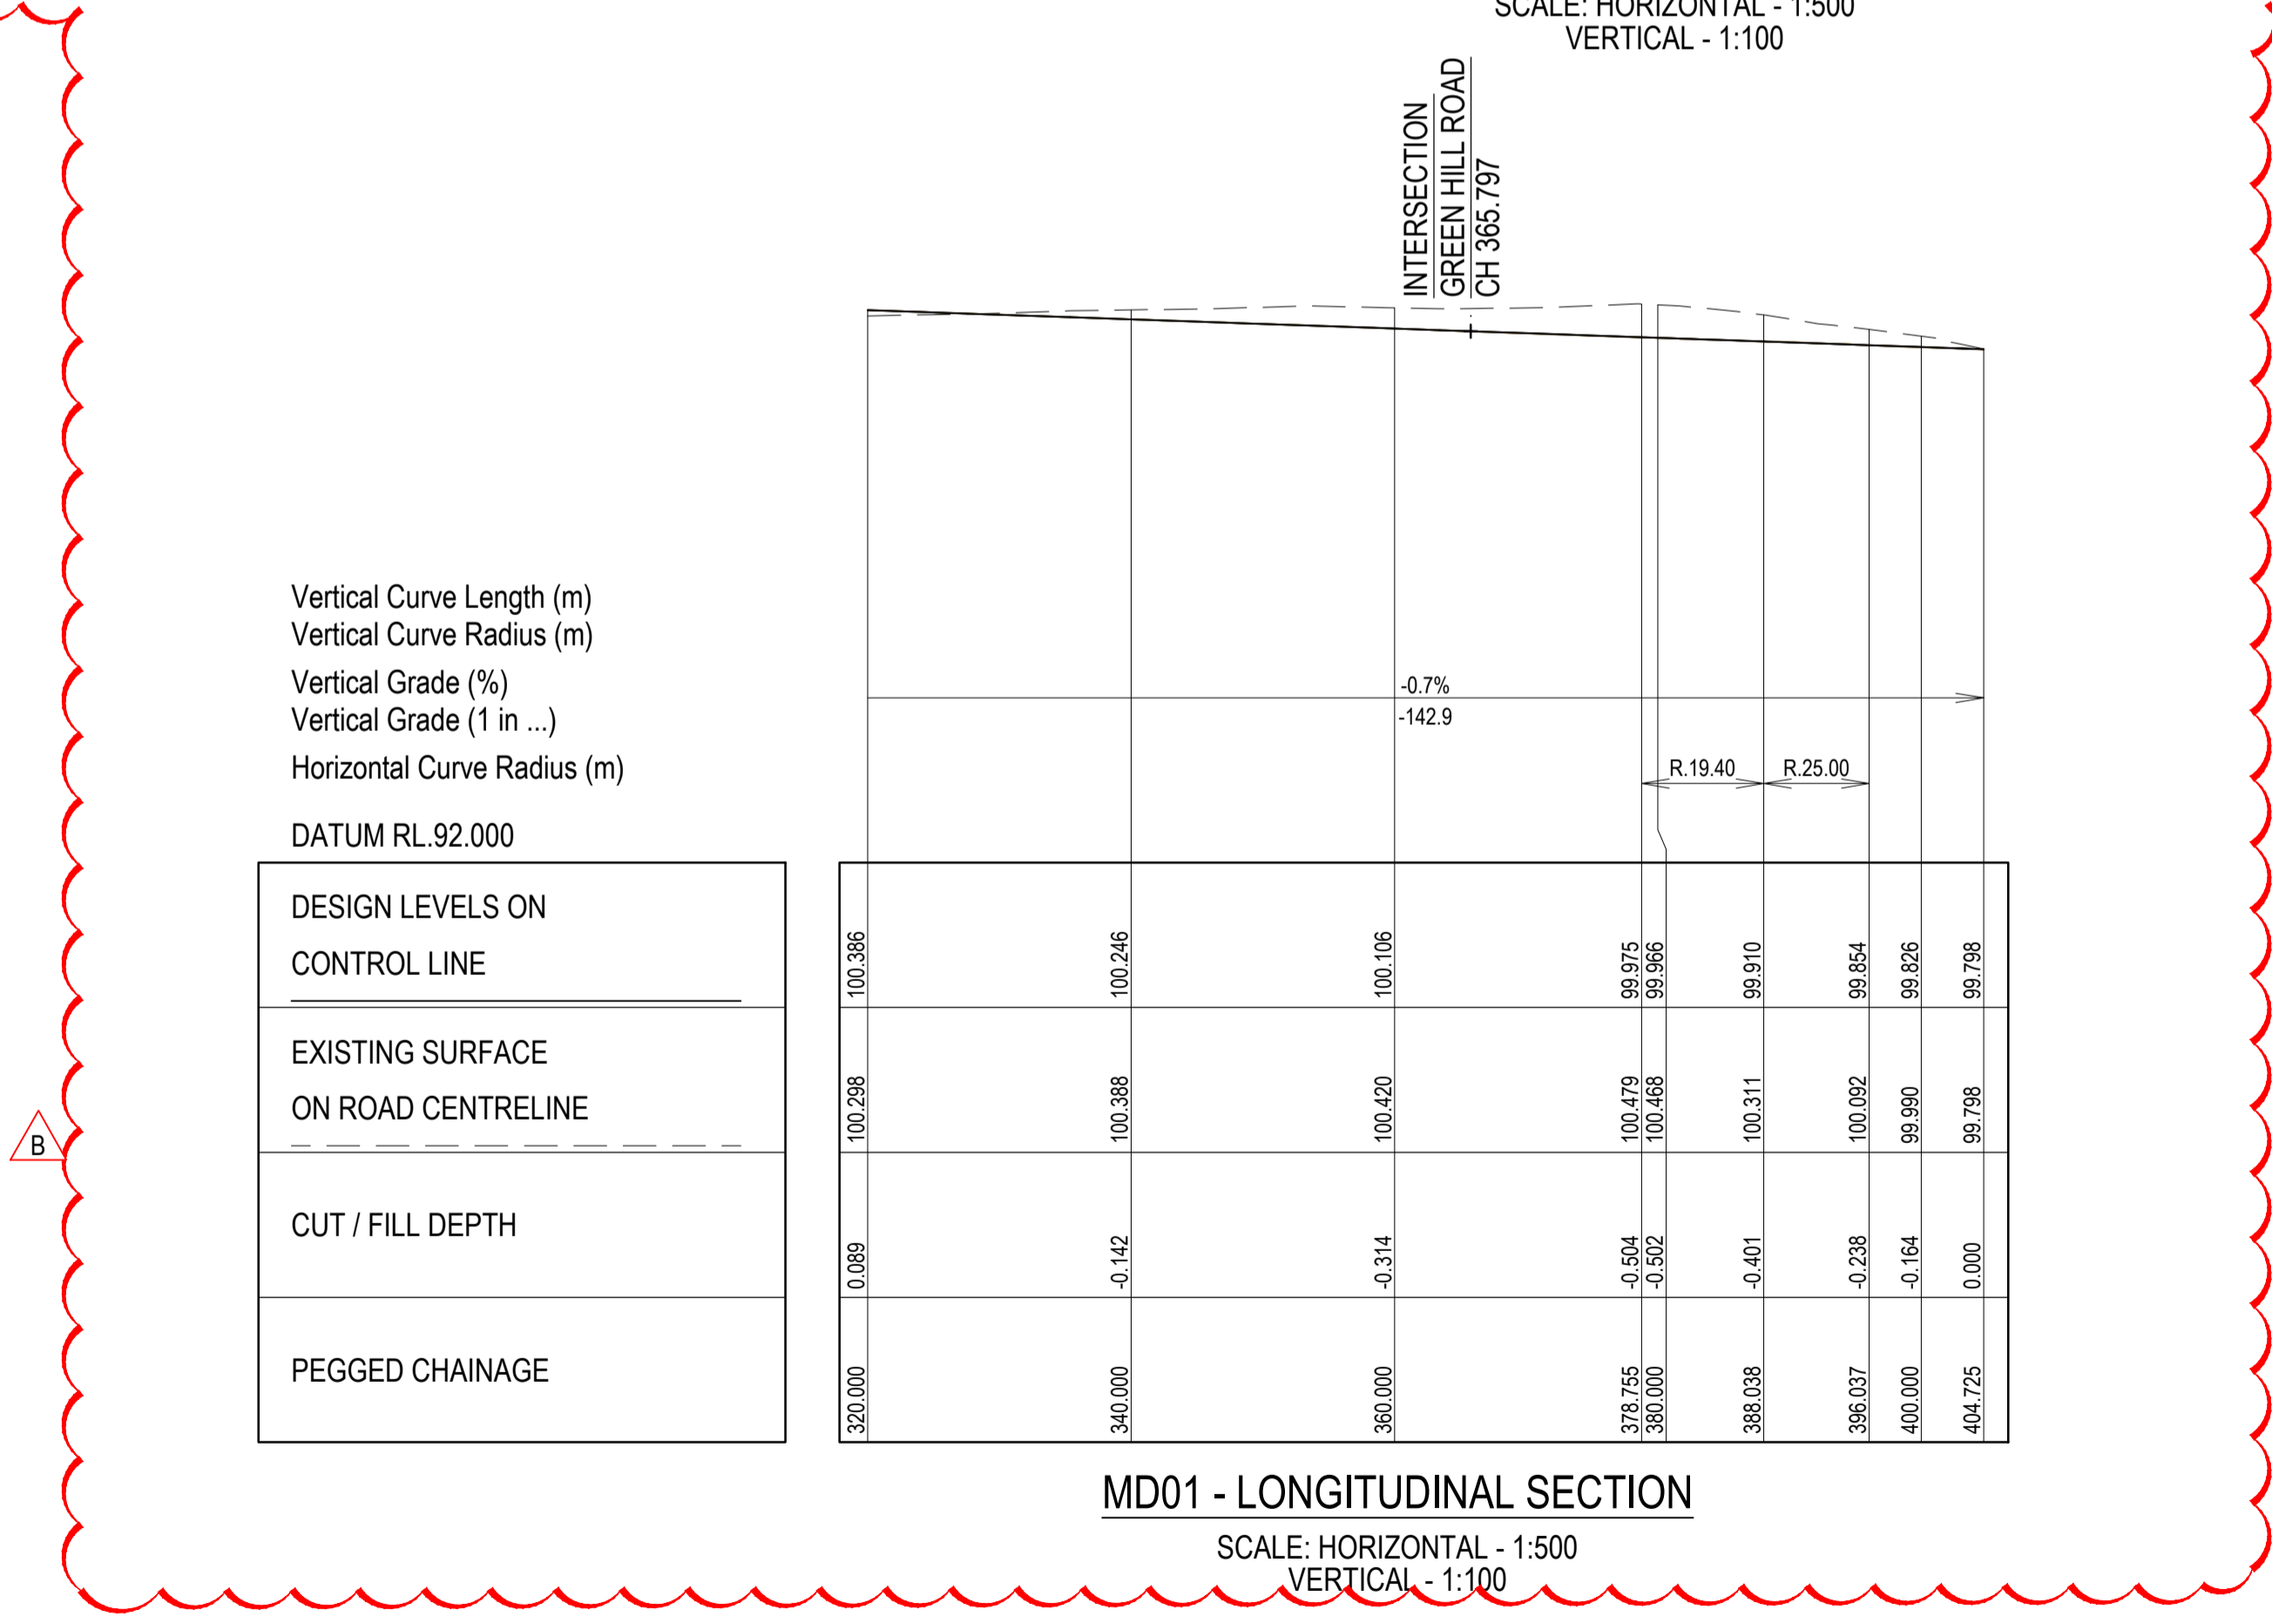

MD01 - LONGITUDINAL SECTION

SCALE: HORIZONTAL - 1:500  
 VERTICAL - 1:100

Issue	Description	By	Ckd	PM	Date
B	TEMPORARY SWALE DRAIN NOT CONSTRUCTED AS PART OF THESE WORK	WB	ZS	SE	07.10.21
A	ISSUED FOR CONSTRUCTION	WB	ZS	SE	04.12.20
03	UPDATES TO ADDRESS COUNCIL COMMENTS	HP	ZS	SE	19.08.20
02	ISSUED FOR APPROVAL	WB	ZS	SE	10.07.20
01	ISSUED TO CLIENT FOR REVIEW	WB	ZS	SE	07.11.19

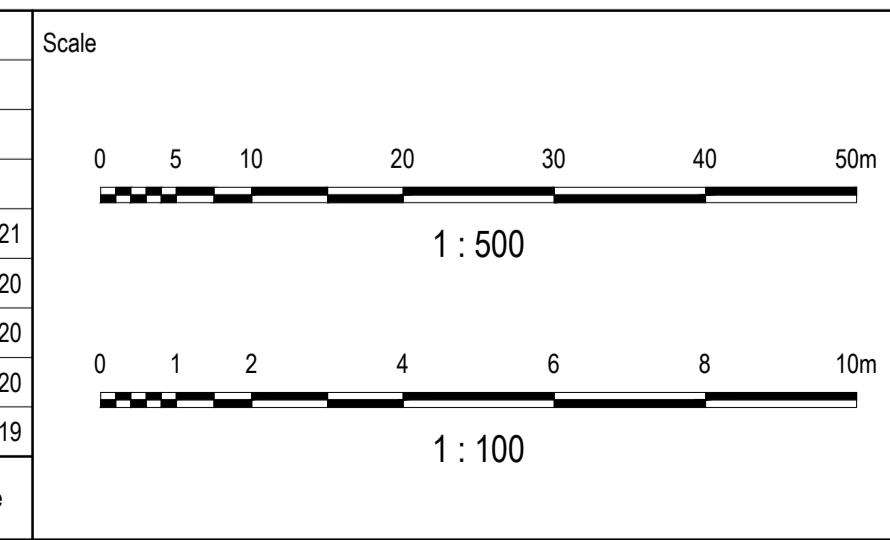

Planner

Client

Filename C-08c-271-10029435-SwaleDetails.dwg

Status: AS CONSTRUCTED

Verifier: Z.STROGUSZ

Scales: 1:500 (H), 1:100 (V)

Original Size: A1

Height Datum: AHD

Grid: MGA

Original Issue Signatures: Drawn W.BUMAGAT, Designed J.ROCK, Project Manager S.EISEL

Copyright reserved

Project: EYNESBURY TOWNSHIP STAGE 8C

Title: SWALE DETAILS SHEET 2 OF 2

Drawing No. C-08C-271


Project No. 10029435

Issue B


Arcadis Australia Pacific Pty Limited  
 Level 32, 140 William Street  
 Melbourne VIC 3000  
 ABN 76 104 485 289  
 Tel No: +61 3 8623 4000  
 www.arcadis.com

**NOTES:**


- DOWEL BAR DIAMETER, LENGTH AND SPACING SHALL BE AS SPECIFIED IN THE SCHEDULE OF DETAILS.
- DOWELS SHALL BE:
  - SECURELY POSITIONED PARALLEL TO PAVEMENT CENTERLINE AND FINISHED SURFACE
  - PART COATED AS SHOWN WITH APPROVED BOND BREAKING MATERIAL
- TIE BARS SHALL BE SECURELY POSITIONED PARALLEL TO PAVEMENT CENTERLINE AND FINISHED SURFACE.
- STEEL FABRIC SHALL BE LOCATED IN THE TOP THIRD OF THE BASE AND SHALL HAVE A MINIMUM COVER OF 50mm. REFER TO SPECIFICATIONS FOR DETAILS OF STEEL FABRIC.
- SUBBASE AND BASE TRANSVERSE JOINTS SHALL BE OFFSET BY A MINIMUM OF 500mm.
- TIED CONSTRUCTION JOINTS SHALL BE LOCATED IN THE MIDDLE THIRD OF THE SLAB LENGTH AND AT LEAST 1.5m FROM TRANSVERSE CONTRACTION JOINTS.
- DOWEL CAP MAY BE OMITTED FOR SHORT SLAB (<5m) CONTRACTION JOINTS.
- SFCR IS STEEL FIBRE REINFORCE CONCRETE.
- TIE BAR SHALL NOT BE PLACE WITHIN 500mm OF A TRANSVERSE CONTRACTION JOINT.
- REINFORCEMENT FOR JOINTED AND CONTINUOUSLY REINFORCED PAVEMENTS IS NOT SHOWN REFER TO SCHEDULE OF DETAILS.
- SUBBASE AND BASE LONGITUDINAL JOINTS SHALL BE OFFSET BY NOT LESS THAN 250mm BUT NOT MORE THAN 300mm.
- SAME DIMENSIONS FOR STEEL FIBRE REINFORCED CONCRETE.
- KERN AND CHANNEL TIED JOINT: IF KERB AND CHANNEL AND BASE ARE CAST SIMULTANEOUSLY, THE BARS ARE NOT REQUIRED BETWEEN THEM. THE PAVEMENT REINFORCEMENT SHALL BE EXTENDED INTO THE KERB AND CHANNEL AND THE BACK OF KERB IS THE EDGE OF PAVEMENT.
- BACKING ROD SHALL BE MADE OF POLYETHYLENE FOAM OR APPROVED EQUIVALENT. ALTERNATIVE MATERIAL AND SHAPE MAY BE APPROVED.
- AN APPROVED NEOPRENE COMPRESSION SEAL CONFORMING TO ASTM D2628 MAY BE USED INSTEAD OF A FIELD MOULDED SEALANT AND BACKING ROD.
- AN APPROVED SEALANT SHALL BE INSTALLED ALONG THE TOP AND DOWN THE VERTICAL EDGES OF THE EXPANSION JOINT.
- REINFORCEMENT SHALL BE LOCATED IN THE TOP THIRD OF THE BASE AND SHALL HAVE A MINIMUM COVER OF 50mm.
- RECTANGULAR MESH SHALL BE ALIGNED WITH THE CLOSER SPACED WIRES PARALLEL TO THE PAVEMENT CENTERLINE.
- REFER TO SHEET C-08C-002 FOR GENERAL NOTES.

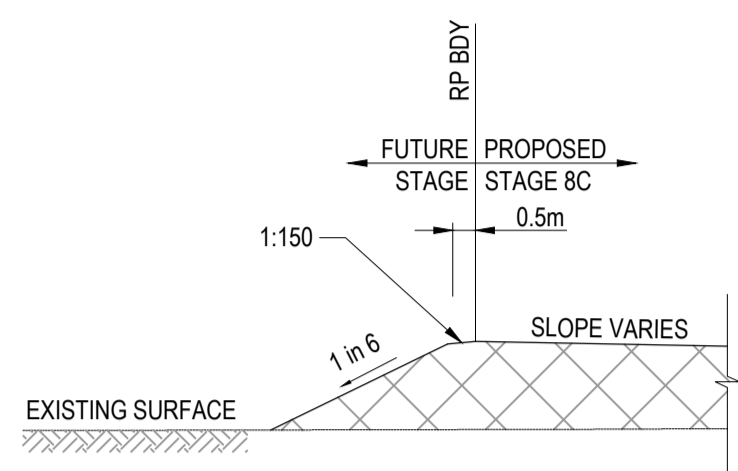


**TYPICAL SECTION**  
NOT TO SCALE

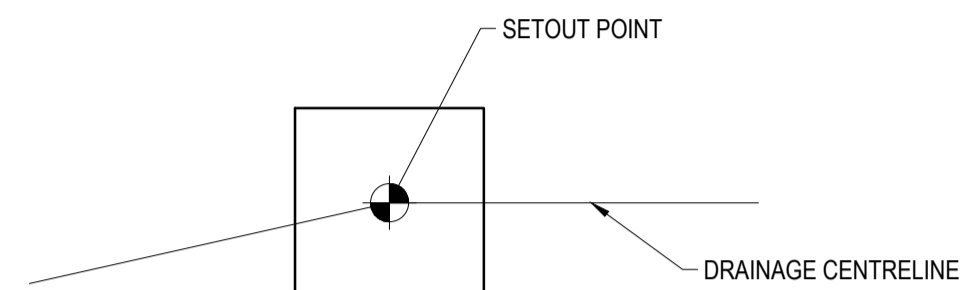


**PIT SETOUT POINT DETAIL**  
NOT TO SCALE

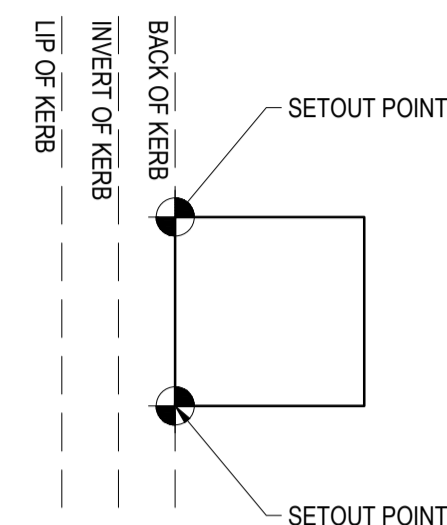


**PIT SETOUT POINT DETAIL WITHIN FUTURE STAGE**  
NOT TO SCALE

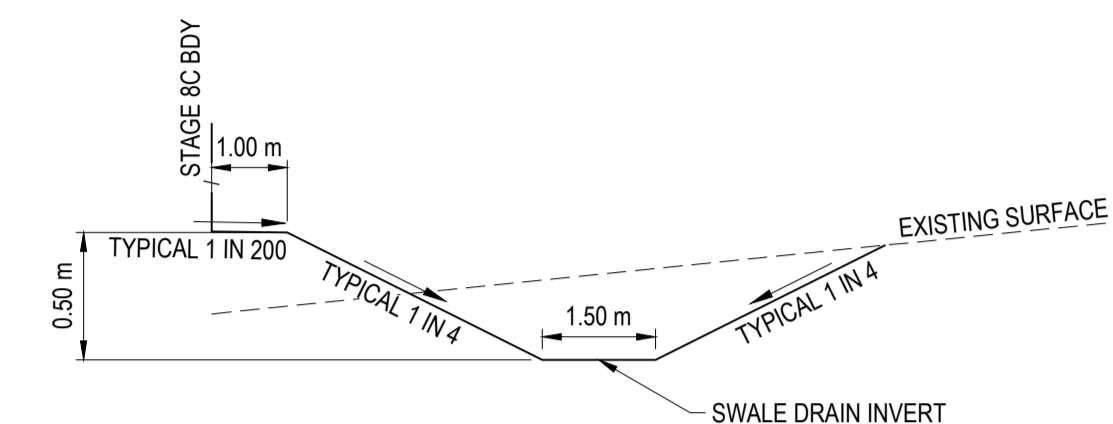


**TYPICAL TEMPORARY SWALE DETAIL**  
NOT TO SCALE

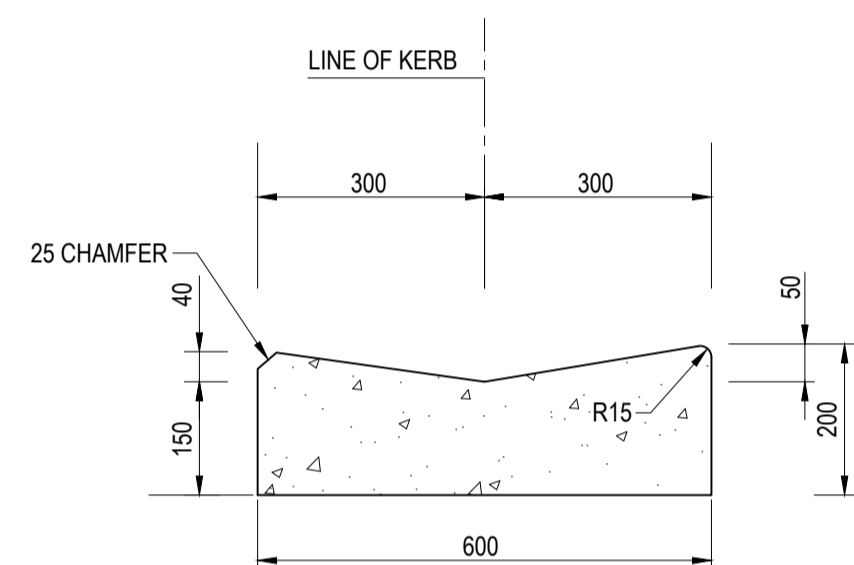


**M2 (600mm) KERB DETAIL**  
1:10

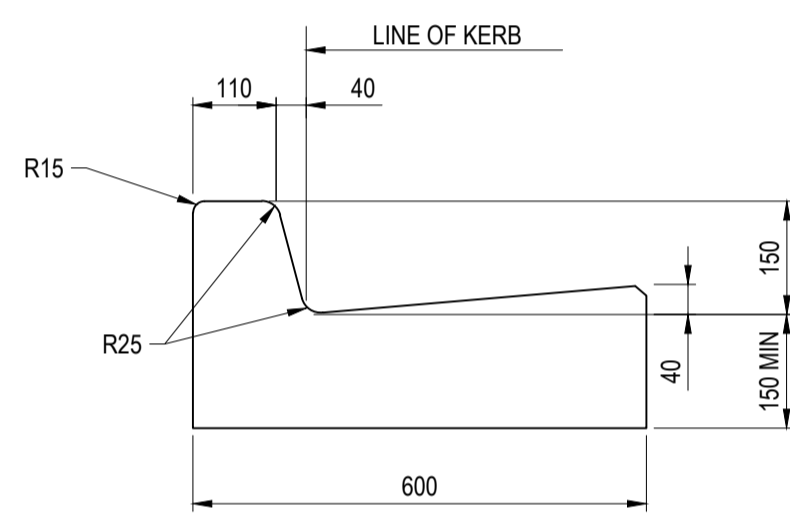

**B2 (600mm) KERB DETAIL**  
1:10

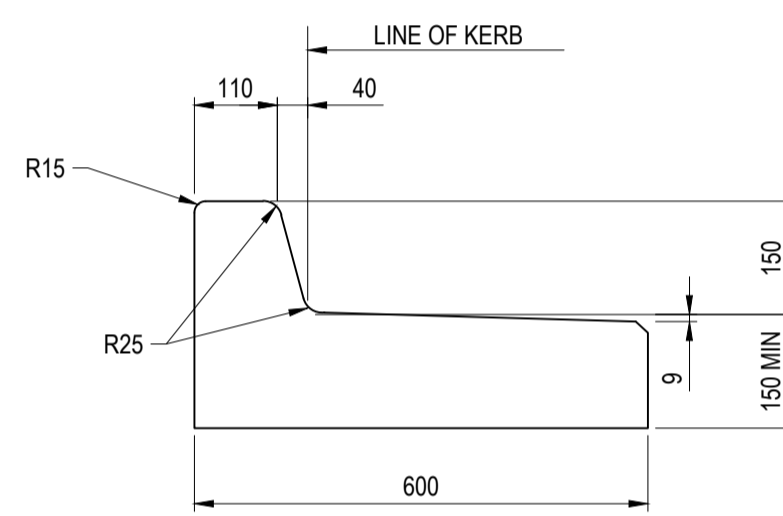


**B3 (600mm) KERB DETAIL**  
1:10

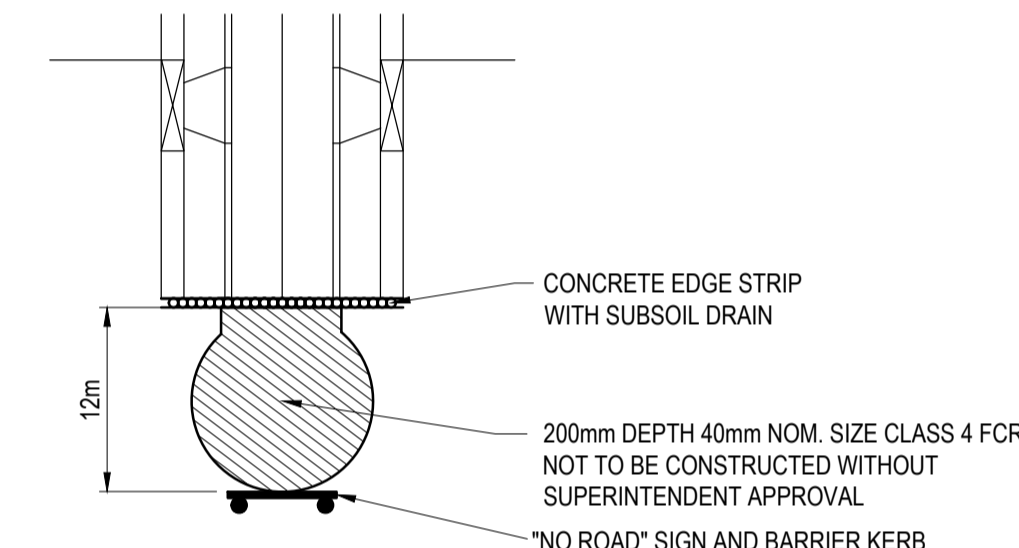


**TYPICAL TEMPORARY TURN AREA DETAIL**  
NOT TO SCALE

**AS CONSTRUCTED RECORDS**


THE OBJECTIVE OF THESE 'AS-CONSTRUCTED DRAWINGS' IS TO REFLECT ANY SIGNIFICANT CHANGES TO THE APPROVED CONSTRUCTION DRAWINGS AND PROVIDE COUNCIL WITH A RECORD OF DESIGN INTENT. ANY LEVELS AND COORDINATES SHOWN ON THESE PLANS ARE SUBJECT TO SURVEY AND WILL DIFFER. ARCADIS ACCEPT NO RESPONSIBILITY FOR LOSS OR DAMAGES RESULTING FROM THE INTERPRETATION OF THESE DRAWINGS. ALL DETAILS AND ASSETS MUST BE ASCERTAINED AND VERIFIED BY THE END USER.

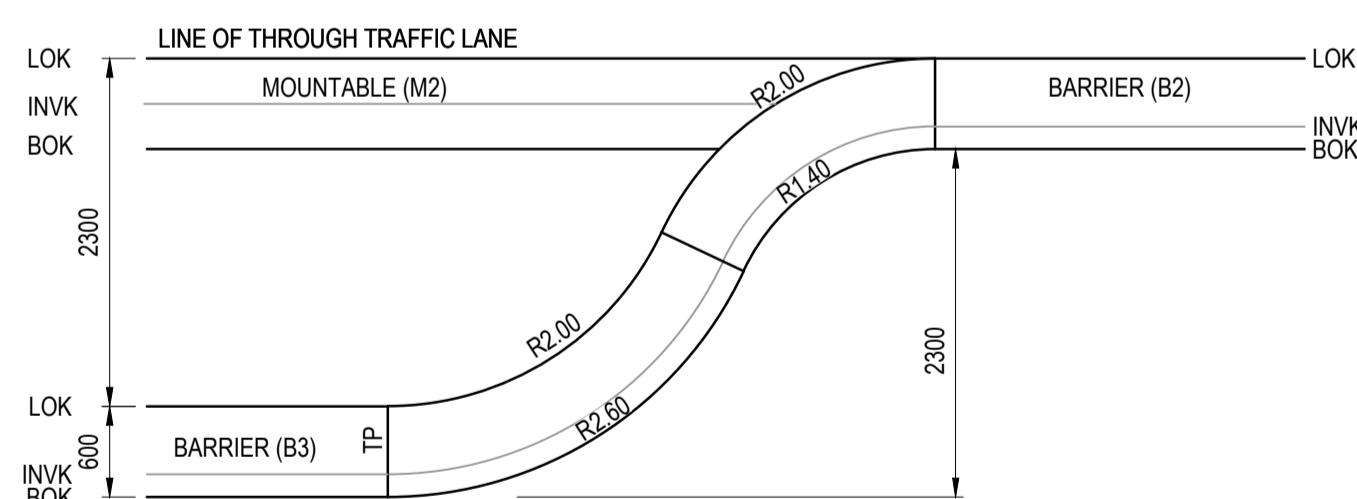

**TYPICAL PARALLEL PARKING BAY DETAIL FOR BARRIER (B2 & B3) KERB AND CHANNEL**  
NOT TO SCALE

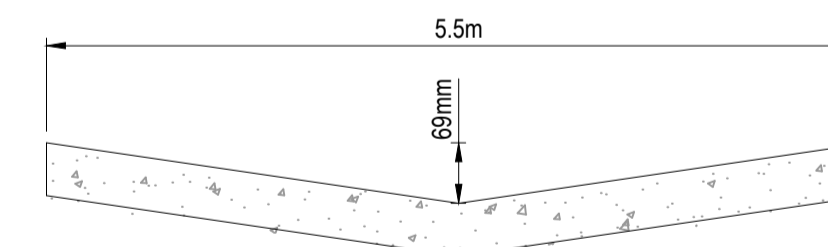

**TYPICAL SECTION - NUGGETTY LANE**  
NOT TO SCALE

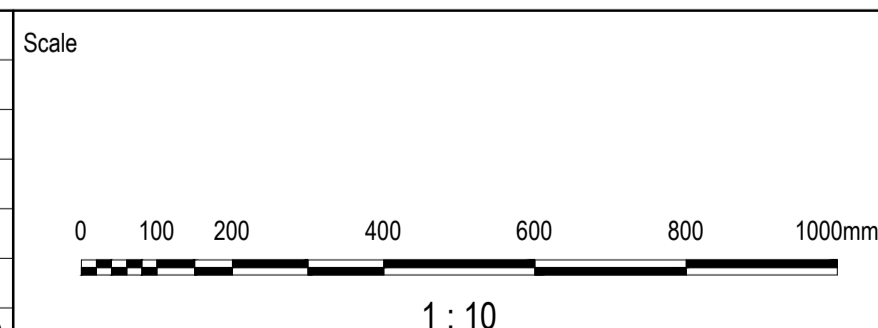

Issue	Description	By	Ckd	PM	Date
B	AS CONSTRUCTED	WB	ZS	SE	07.10.21
A	ISSUED FOR CONSTRUCTION	WB	ZS	SE	04.12.20
02	ISSUED FOR APPROVAL	WB	ZS	SE	10.07.20
01	ISSUED TO CLIENT FOR REVIEW	WB	ZS	SE	07.11.19

Planner

RD RobertsDay  
planning.design.place

Client

RESIMAX  
GROUP

Filename C-08c-280-10029435-TypicalDetails.dwg

Status	AS CONSTRUCTED	
Verifier	Z.STROGUSZ	
Scales	1:10	Original Issue Signatures
		Drawn W.BUMAGAT
Original Size	A1	Designed J.ROCK
Height Datum	AHD	Project Manager S.EISEL
Grid	MGA	© Copyright reserved

Project	EYNESBURY TOWNSHIP STAGE 8C	
Title	TYPICAL DETAILS SHEET 1 OF 2	

Arcadis Australia Pacific Pty Limited  
Level 32, 140 William Street  
Melbourne VIC 3000  
ABN 76 104 485 289  
Tel No: +61 3 8623 4000  
www.arcadis.com

Drawing No.	Project No.	Issue
C-08C-280	10029435	B

PAVEMENT COMPOSITION TYPE 1 AMPHITHEATRE STREET		
LAYER	THICKNESS (mm)	MATERIAL
WEARING COURSE	20	SIZE 7mm TYPE L ASPHALT (CLASS 320 BINDER)
BASE COURSE	30	SIZE 10mm TYPE N ASPHALT (CLASS 320 BINDER)
INTERLAYER	-	SIZE 10mm SAMI WITH S18RF BINDER
BONDING LAYER	-	BITUMINOUS PRIME
BASE	140	SIZE 20mm CLASS 2 CRUSHED ROCK COMPACTED TO A MINIMUM CHARACTERISTIC DENSITY RATIO OF 100% (MODIFIED) MAXIMUM DRY DENSITY AS1289.5.2.1
SUBBASE	100	SIZE 20mm CLASS 3 CRUSHED ROCK COMPACTED TO A MINIMUM CHARACTERISTIC DENSITY RATIO OF 98% (MODIFIED) MAXIMUM DRY DENSITY AS1289.5.2.1
CAPPING LAYER	150	TYPE A MATERIAL (CAPPING LAYER) MEETING THE FOLLOWING MATERIAL PROPERTIES: CBR ≥ 8%, SWELL ≤ 1.5%, PERMEABILITY K ≤ 5 x 10 <sup>-9</sup> m/s. COMPACTED TO A MINIMUM DENSITY RATIO OF 98% (STANDARD) MAXIMUM DRY DENSITY AS1289.5.1.1
CONSTRUCTION LAYER	150	TYPE A MATERIAL MEETING THE FOLLOWING MATERIAL PROPERTIES: CBR ≥ 8%, SWELL ≤ 1.5% AND PERMEABILITY ≤ 5 x 10 <sup>-9</sup> m/s. COMPACTED TO A MINIMUM DENSITY RATIO OF 98% (STANDARD) MAXIMUM DRY DENSITY AS1289.5.1.1
TOTAL	590	
SUBGRADE	-	MATERIAL AS FOUND (CLAY) TOP 200mm COMPACTED TO A MINIMUM DENSITY RATIO OF 98% (STANDARD) MAXIMUM DRY DENSITY AS1289.5.1.1

PAVEMENT COMPOSITION TYPE 2 CROWLANDS CIRCUIT		
LAYER	THICKNESS (mm)	MATERIAL
WEARING COURSE	30	SIZE 10mm TYPE L ASPHALT (CLASS 320 BINDER)
BASE COURSE	30	SIZE 10mm TYPE N ASPHALT (CLASS 320 BINDER)
INTERLAYER	-	SIZE 10mm SAMI WITH S18RF BINDER
BONDING LAYER	-	BITUMINOUS PRIME
BASE	130	SIZE 20mm CLASS 2 CRUSHED ROCK COMPACTED TO A MINIMUM CHARACTERISTIC DENSITY RATIO OF 100% (MODIFIED) MAXIMUM DRY DENSITY AS1289.5.2.1
SUBBASE	100	SIZE 20mm CLASS 3 CRUSHED ROCK COMPACTED TO A MINIMUM CHARACTERISTIC DENSITY RATIO OF 98% (MODIFIED) MAXIMUM DRY DENSITY AS1289.5.2.1
CAPPING LAYER	150	TYPE A MATERIAL (CAPPING LAYER) MEETING THE FOLLOWING MATERIAL PROPERTIES: CBR ≥ 8%, SWELL ≤ 1.5%, PERMEABILITY K ≤ 5 x 10 <sup>-9</sup> m/s. COMPACTED TO A MINIMUM DENSITY RATIO OF 98% (STANDARD) MAXIMUM DRY DENSITY AS1289.5.1.1
CONSTRUCTION LAYER	150	TYPE A MATERIAL MEETING THE FOLLOWING MATERIAL PROPERTIES: CBR ≥ 8%, SWELL ≤ 1.5% AND PERMEABILITY ≤ 5 x 10 <sup>-9</sup> m/s. COMPACTED TO A MINIMUM DENSITY RATIO OF 98% (STANDARD) MAXIMUM DRY DENSITY AS1289.5.1.1
TOTAL	590	
SUBGRADE	-	MATERIAL AS FOUND (CLAY) TOP 200mm COMPACTED TO A MINIMUM DENSITY RATIO OF 98% (STANDARD) MAXIMUM DRY DENSITY AS1289.5.1.1

PAVEMENT COMPOSITION TYPE 3 LOGAN STREET		
LAYER	THICKNESS (mm)	MATERIAL
WEARING COURSE	40	SIZE 10mm TYPE N ASPHALT (CLASS 320 BINDER)
BASE COURSE	40	SIZE 10mm TYPE HP ASPHALT (CLASS A10E BINDER)
INTERLAYER	-	SIZE 10mm SAMI WITH S18RF BINDER
BONDING LAYER	-	BITUMINOUS PRIME
BASE	110	SIZE 20mm CLASS 2 CRUSHED ROCK COMPACTED TO A MINIMUM DENSITY RATIO OF 100% (MODIFIED) AS1289.5.2.1
UPPER SUBBASE	100	SIZE 20mm CLASS 3 CRUSHED ROCK COMPACTED TO A MINIMUM DENSITY RATIO OF 98% (MODIFIED) AS1289.5.2.1
LOWER SUBBASE	110	SIZE 20mm CLASS 4 CRUSHED ROCK COMPACTED TO A MINIMUM DENSITY RATIO OF 98% (MODIFIED) AS1289.5.2.1
CAPPING LAYER	150	TYPE A MATERIAL (CAPPING LAYER) MEETING THE FOLLOWING MATERIAL PROPERTIES: CBR ≥ 8%, SWELL ≤ 1.5%, PERMEABILITY K ≤ 5 x 10 <sup>-9</sup> m/s. COMPACTED TO A MINIMUM DENSITY RATIO OF 98% (STANDARD) MAXIMUM DRY DENSITY AS1289.5.1.1
CONSTRUCTION LAYER	150	TYPE A MATERIAL MEETING THE FOLLOWING MATERIAL PROPERTIES: CBR ≥ 8%, SWELL ≤ 1.5% AND PERMEABILITY ≤ 5 x 10 <sup>-9</sup> m/s. COMPACTED TO A MINIMUM DENSITY RATIO OF 98% (STANDARD) MAXIMUM DRY DENSITY AS1289.5.1.1
TOTAL	700	
SUBGRADE	-	MATERIAL AS FOUND (SILTY CLAY) COMPACTED TO A MINIMUM DENSITY RATIO OF 98% (STANDARD) AS1289.5.1.1


PAVEMENT COMPOSITION TYPE 4 NUGGETTY LANE		
LAYER	THICKNESS (mm)	MATERIAL
WEARING COURSE	-	EXPOSED AGGREGATE FINISH
BASE COURSE	195	CONCRETE 32MPa WITH TWO SHEETS OF S182 MESH REINFORCEMENT WITH 50mm TOP COVER AS PER STANDARD DRAWING MCC 504
SUBBASE	100	SIZE 20mm CLASS 3 CRUSHED ROCK COMPACTED TO NOT LESS THAN 98% (STANDARD) MAXIMUM DRY DENSITY AS1289.5.1.1
CAPPING LAYER	150	SELECT FILL OR STABILISED CLAY MEETING THE FOLLOWING MATERIAL PROPERTIES: CBR ≥ 8%, SWELL ≤ 1.5%, PERMEABILITY K ≤ 5 x 10 <sup>-9</sup> m/s (5X10 <sup>-7</sup> cm/s) COMPACTED TO A MINIMUM DENSITY RATIO OF 97% (STANDARD) MAXIMUM DRY DENSITY AS1289.5.1.1
TOTAL	445	
SUBGRADE	-	MATERIAL AS FOUND (CLAY) TOP 200mm COMPACTED TO A MINIMUM DENSITY RATIO OF 98% (STANDARD) MAXIMUM DRY DENSITY AS1289.5.1.1

**LEGEND**


- STAGE BOUNDARY
- PROPOSED KERB & CHANNEL
- PROPOSED ROAD PAVEMENT TYPE 1
- PROPOSED ROAD PAVEMENT TYPE 2
- PROPOSED ROAD PAVEMENT TYPE 3
- PROPOSED ROAD PAVEMENT TYPE 4
- PROPOSED CONCRETE FOOTPATH/DRIVEWAY
- LONGITUDINAL TIED JOINT (LJ)
- ISOLATION JOINT (IJ)
- TRANSVERSE JOINT (TJ)
- EXPANSION JOINT (EJ)

**NOTES:**

- ALL PAVEMENT DESIGNS HAVE BEEN PROVIDED BY TONKIN AND TAYLOR. ARCADIS ARE NOT RESPONSIBLE FOR THE DESIGN OF THE PAVEMENTS WITHIN THIS STAGE OF WORKS. THE PAVEMENT COMPOSITIONS HAVE BEEN EXTRACTED FROM THE PAVEMENT REPORT FOR THIS STAGE OF WORKS. THE CONTRACTOR SHOULD REVIEW THIS DOCUMENT IN CONJUNCTION WITH THE GEOTECHNICAL AND PAVEMENT REPORTS PROVIDED BY TONKIN AND TAYLOR.

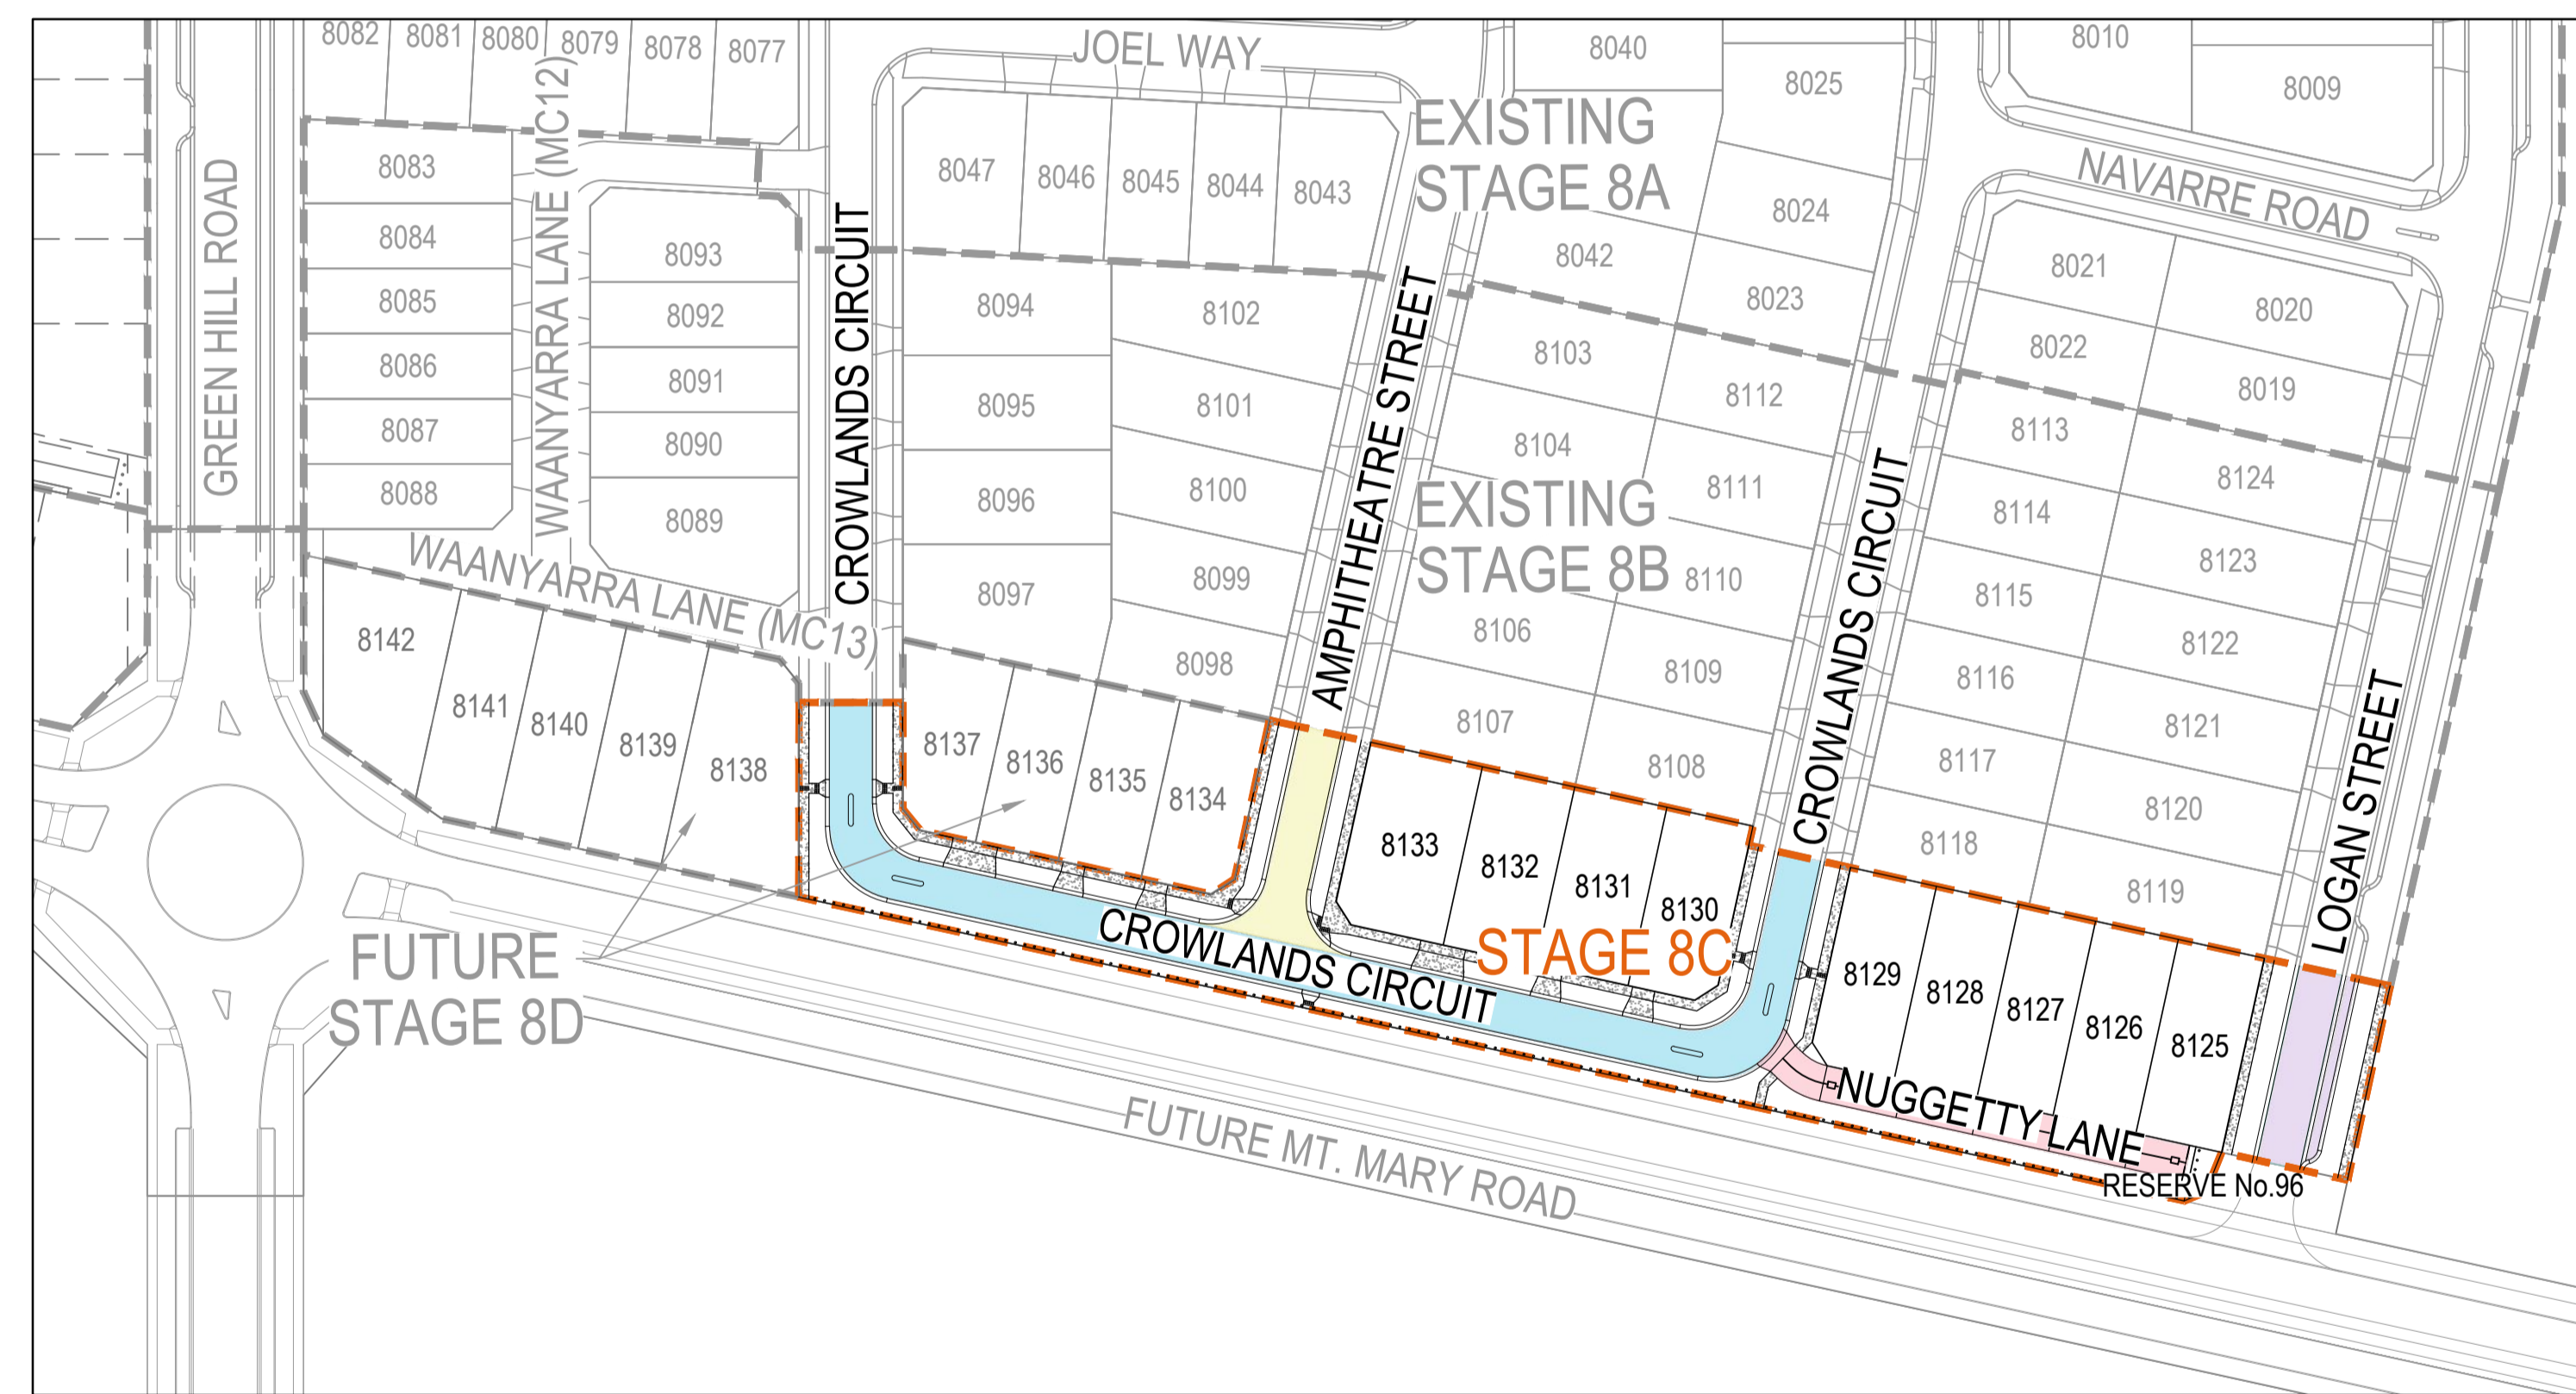

PLAN  
SCALE 1 : 1000

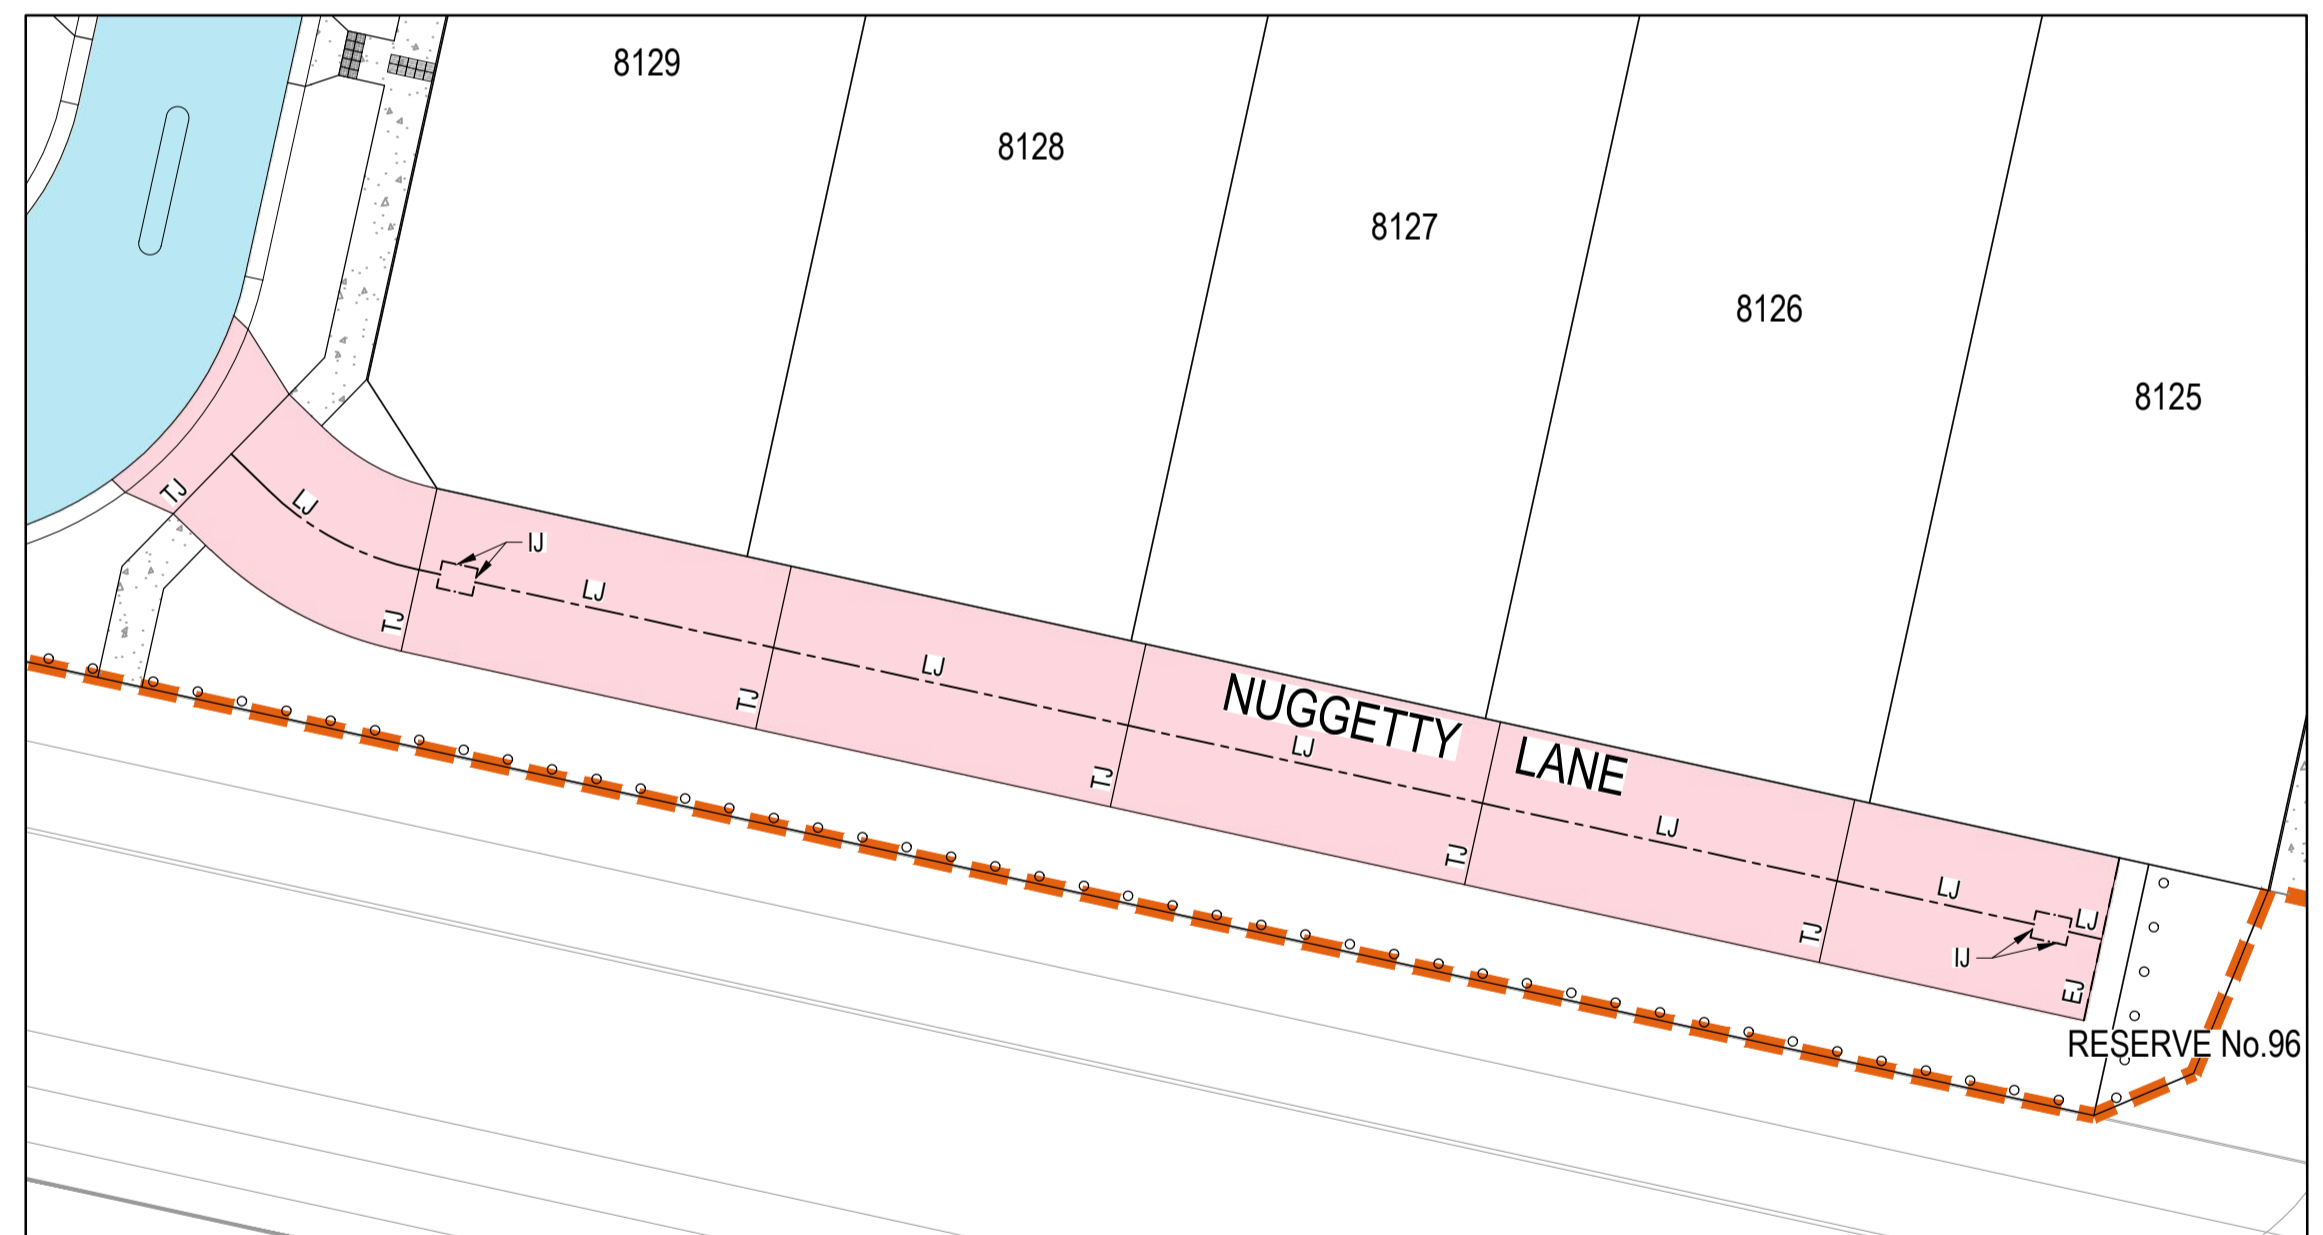


PLAN - NUGGETTY LANE  
SCALE 1 : 250

**AS CONSTRUCTED RECORDS**

THE OBJECTIVE OF THESE 'AS-CONSTRUCTED DRAWINGS' IS TO REFLECT ANY SIGNIFICANT CHANGES TO THE APPROVED CONSTRUCTION DRAWINGS AND PROVIDE COUNCIL WITH A RECORD OF DESIGN INTENT. ANY LEVELS AND COORDINATES SHOWN ON THESE PLANS ARE SUBJECT TO SURVEY AND WILL DIFFER. ARCADIS ACCEPT NO RESPONSIBILITY FOR LOSS OR DAMAGES RESULTING FROM THE INTERPRETATION OF THESE DRAWINGS. ALL DETAILS AND ASSETS MUST BE ASCERTAINED AND VERIFIED BY THE END USER.

Issue	Description	By	Ckd	PM	Date
B	AS CONSTRUCTED	WB	ZS	SE	07.10.21
A	ISSUED FOR CONSTRUCTION	WB	ZS	SE	04.12.20
04	UPDATES TO ADDRESS COUNCIL COMMENTS	HP	ZS	SE	19.08.20
03	UPDATES TO ADDRESS COUNCIL COMMENTS	WB	ZS	SE	03.08.20
02	ISSUED FOR APPROVAL	WB	ZS	SE	10.07.20
01	ISSUED TO CLIENT FOR REVIEW	WB	ZS	SE	07.11.19

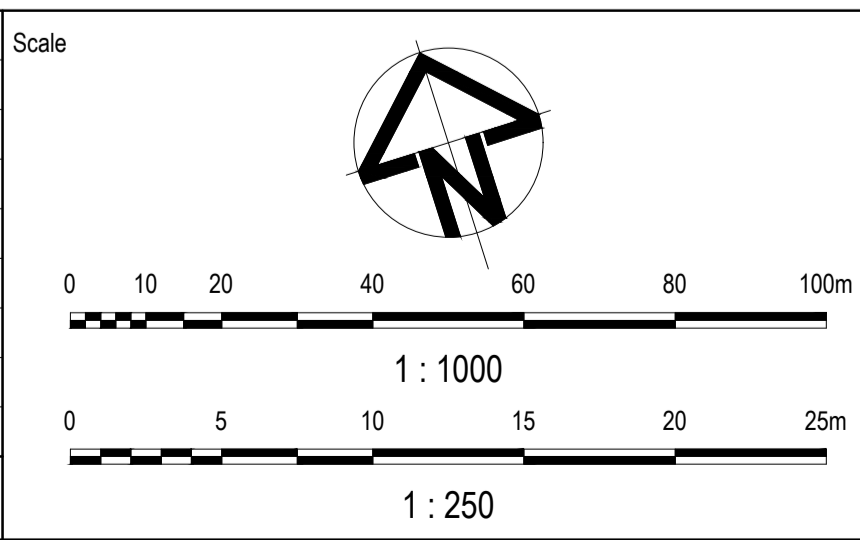

Planner

Client

Filename C-08c-281-10029435-TypicalDetails.dwg

Status	AS CONSTRUCTED
Verifier	Z.STROGUSZ
Original Issue Signatures	Drawn W.BUMAGAT Designed J.ROCK Project Manager S.EISEL
Scales	1:1000 1:250
Original Size	A1
Height Datum	AHD
Grid	MGA

Project

EYNEBURY TOWNSHIP  
STAGE 8C


Title

TYPICAL DETAILS  
SHEET 2 OF 2

Arcadis Australia Pacific Pty Limited  
Level 32, 140 William Street  
Melbourne VIC 3000  
ABN 76 104 485 289  
Tel No: +61 3 8623 4000  
www.arcadis.com

Drawing No. C-08C-281  
Project No. 10029435  
Issue B



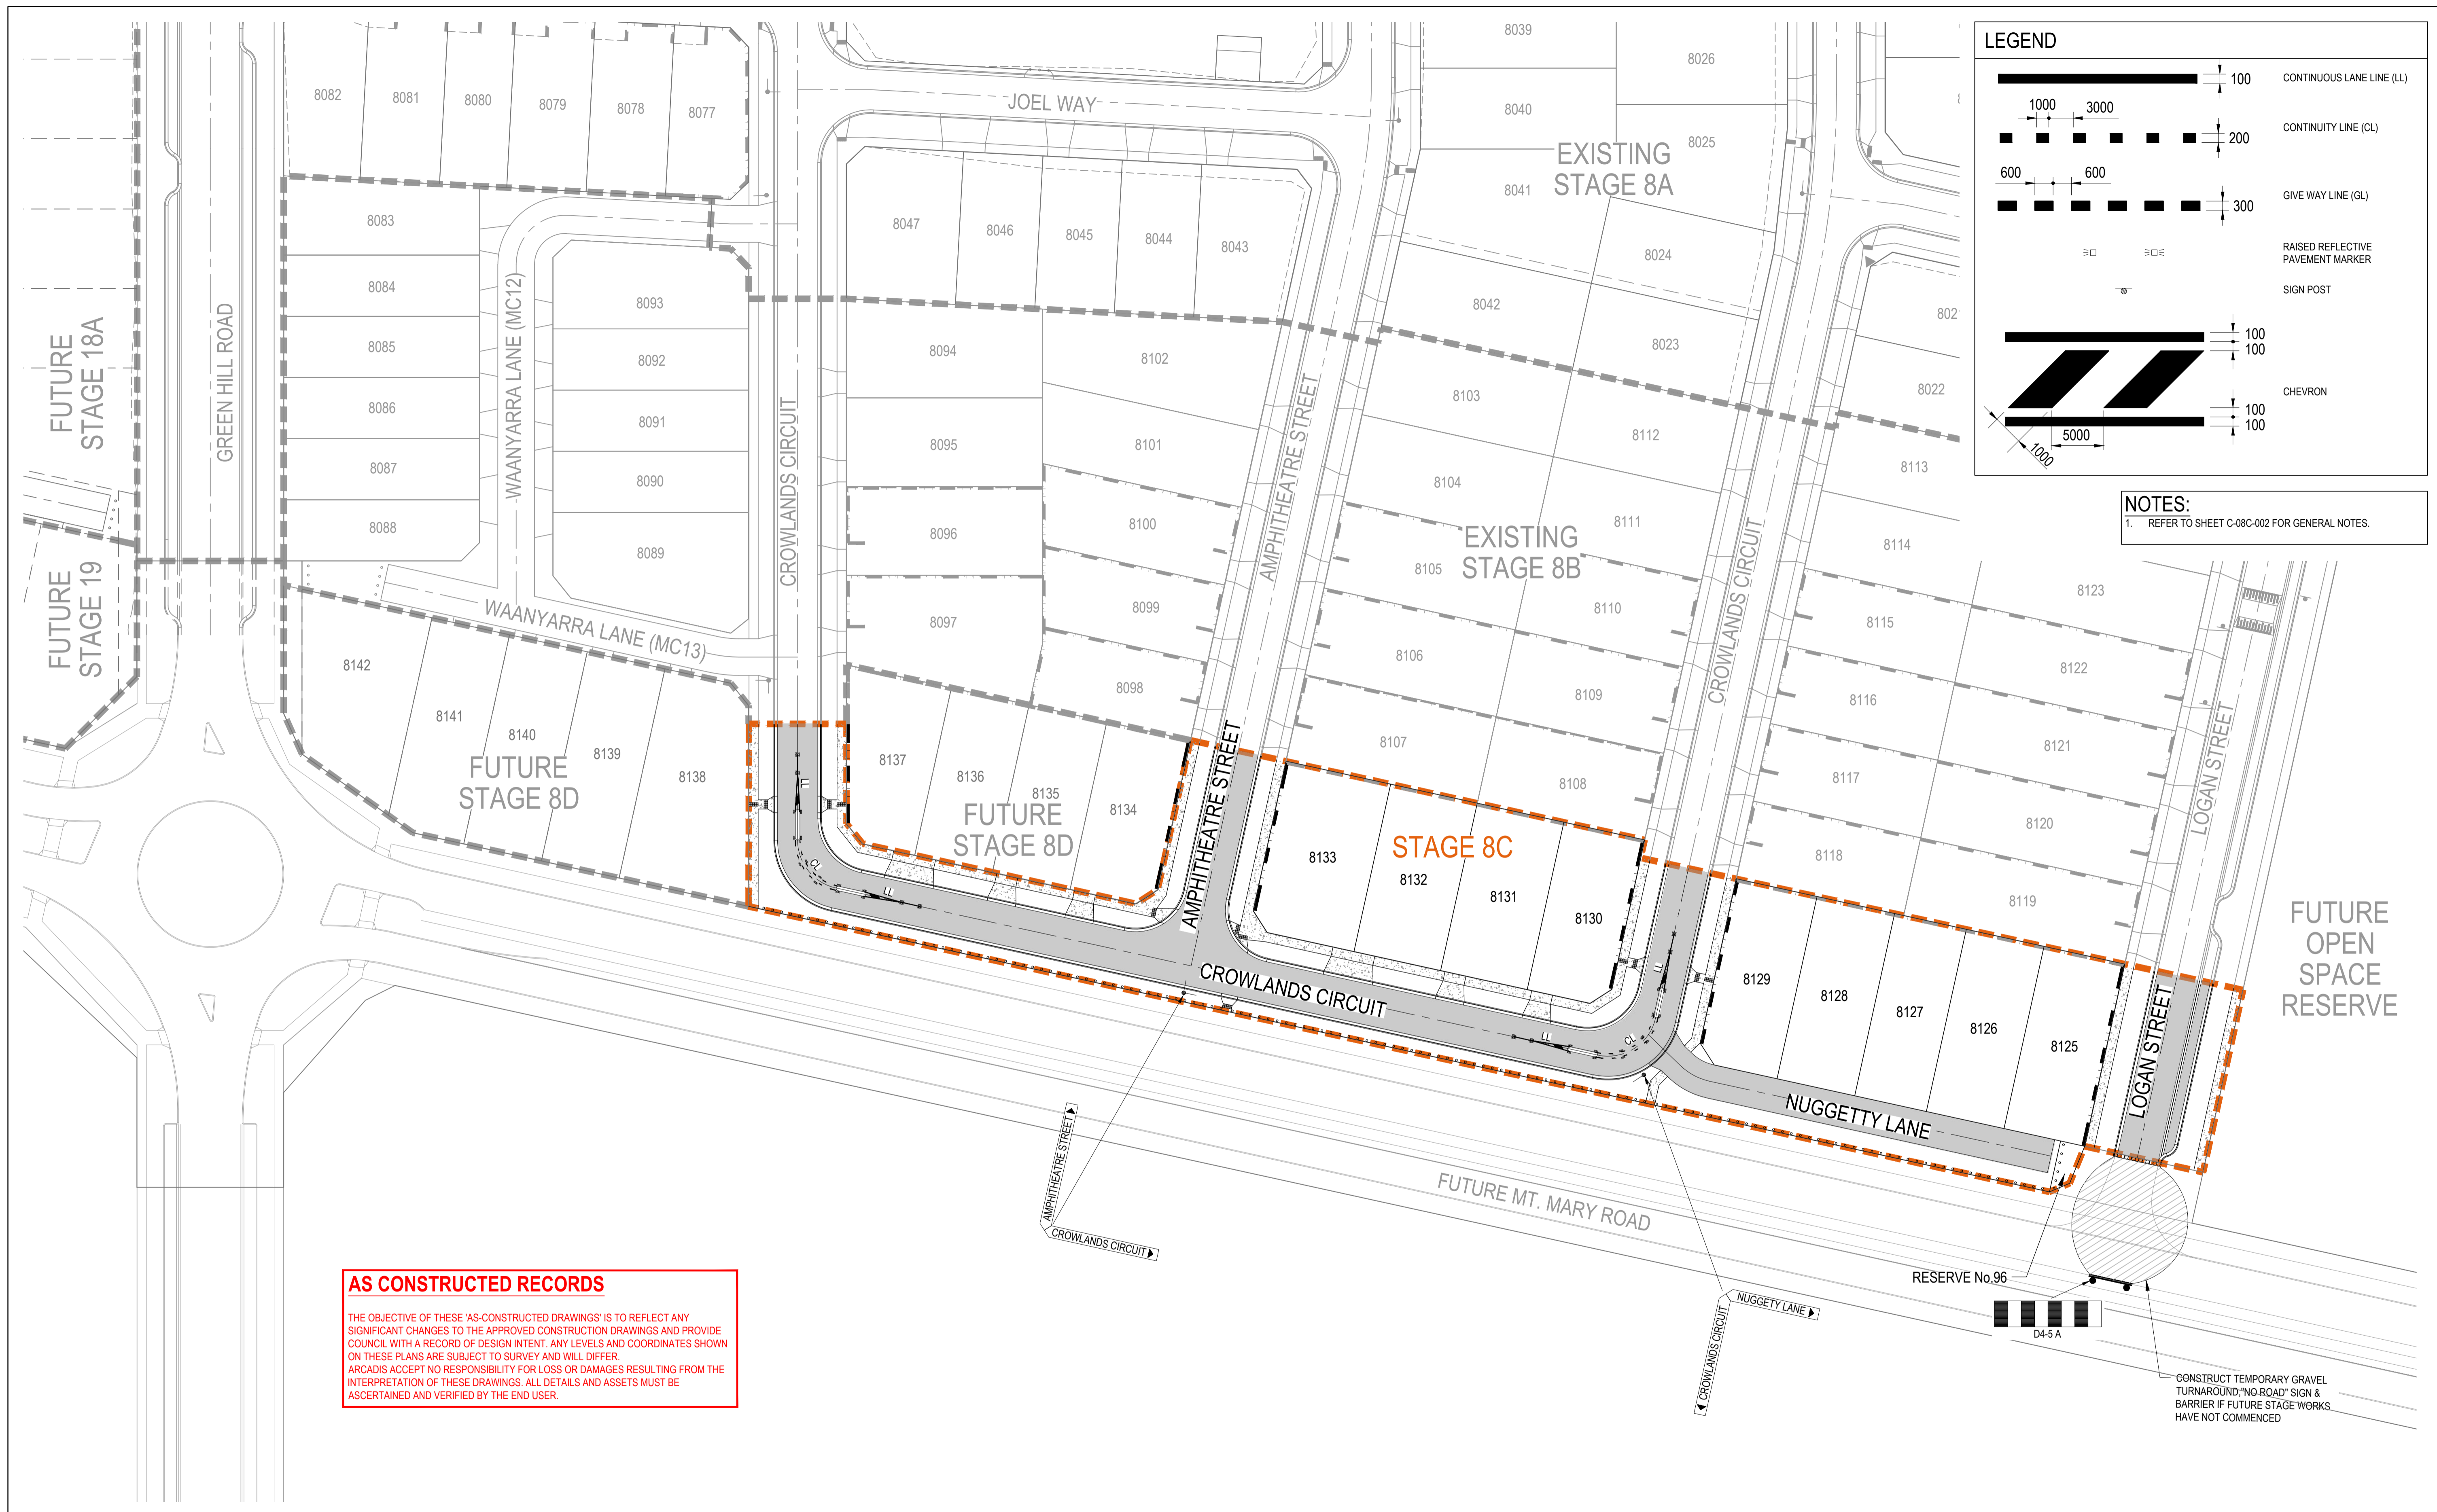

**LEGEND**

- CONTINUOUS LANE LINE (LL)
- CONTINUITY LINE (CL)
- GIVE WAY LINE (GL)
- RAISED REFLECTIVE PAVEMENT MARKER
- SIGN POST
- CHEVRON


**NOTES:**  
 1. REFER TO SHEET C-08C-002 FOR GENERAL NOTES.

**AS CONSTRUCTED RECORDS**

THE OBJECTIVE OF THESE 'AS-CONSTRUCTED DRAWINGS' IS TO REFLECT ANY SIGNIFICANT CHANGES TO THE APPROVED CONSTRUCTION DRAWINGS AND PROVIDE COUNCIL WITH A RECORD OF DESIGN INTENT. ANY LEVELS AND COORDINATES SHOWN ON THESE PLANS ARE SUBJECT TO SURVEY AND WILL DIFFER. ARCADIS ACCEPTS NO RESPONSIBILITY FOR LOSS OR DAMAGES RESULTING FROM THE INTERPRETATION OF THESE DRAWINGS. ALL DETAILS AND ASSETS MUST BE ASCERTAINED AND VERIFIED BY THE END USER.

CONSTRUCT TEMPORARY GRAVEL TURNAROUND, 'NO ROAD' SIGN & BARRIER IF FUTURE STAGE WORKS HAVE NOT COMMENCED

Issue	Description	By	Ckd	PM	Date
B	AS CONSTRUCTED	WB	ZS	SE	07.10.21
A	ISSUED FOR CONSTRUCTION	WB	ZS	SE	04.12.20
04	UPDATES TO ADDRESS COUNCIL COMMENTS	HP	ZS	SE	19.08.20
03	UPDATES TO ADDRESS COUNCIL COMMENTS	WB	ZS	SE	03.08.20
02	ISSUED FOR APPROVAL	WB	ZS	SE	10.07.20
01	ISSUED TO CLIENT FOR REVIEW	WB	ZS	SE	07.11.19

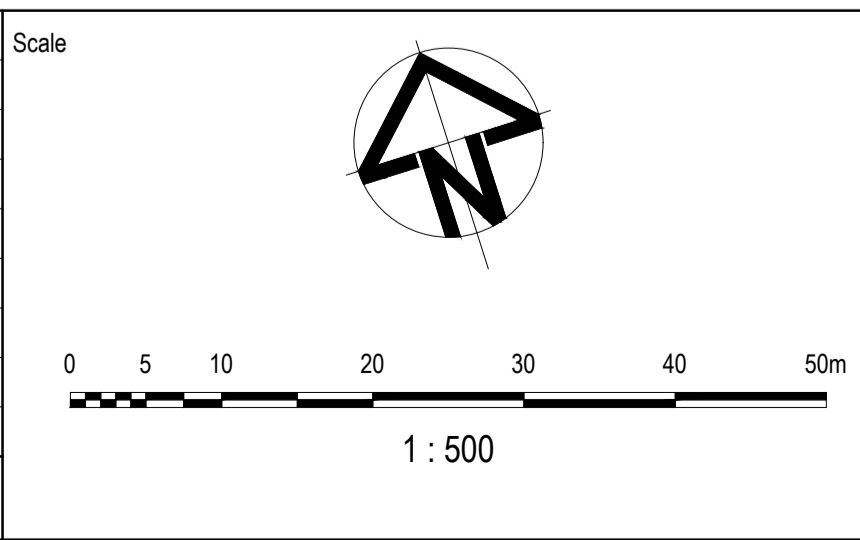

Planner

Client

Filename C-08c-290-10029435-Sign&LinemarkingPlan.dwg

Status

**AS CONSTRUCTED**

Verifier

Z.STROGUSZ

Scales

1:500

Original Issue Signatures

Drawn W.BUMAGAT

Designed J.ROCK

Project Manager S.EISEL

Original Size

A1

Height Datum

AHD

Grid

MGA

Copyright reserved

Project

EYNEBURY TOWNSHIP  
STAGE 8C

Title

LINEMARKING AND  
SIGNAGE PLAN

Arcadis Australia Pacific Pty Limited  
Level 32, 140 William Street  
Melbourne VIC 3000  
ABN 76 104 485 289  
Tel No: +61 3 8623 4000  
www.arcadis.com


Drawing No. C-08C-290



Project No. 10029435

Issue B

- NOTES:**
- PIPE TRENCHES WITHIN THE ROAD RESERVE MUST BE BACKFILLED WITH 20mm CLASS 3 CRUSHED ROCK TO BE COMPACTED TO A DRY DENSITY NOT LESS THAN 97% OF MAXIMUM FOUND IN THE STANDARD COMPACTION TEST FOR THE FOLLOWING:
    - BENEATH THE ROAD PAVEMENT OR DRIVEWAY CROSSOVER TO THE UNDERSIDE OF THE PAVEMENT OF CROSSOVER
    - ADJACENT TO KERBING OR CONCRETE WORKS TO A LEVEL THAT IS NOT AFFECTED BY A 45 DEGREE ANGLE OR REPOSE FROM NEAR THE LOWER EDGE
  - ALL DRAINAGE PIPES TO BE RUBBER RING BELLED SOCKET JOINT TYPE (RRJ).
  - ALL DRAINAGE PIPES SHALL BE CLASS 2 RCP, UNLESS OTHERWISE NOTED.
  - WHERE PITS DROP LESS THAN 50mm THE PIT FLOOR MUST BE SHAPED TO MATCH THE LOWER HALF OF THE PIPE.
  - REFER TO SHEET C-08C-002 FOR GENERAL NOTES.

**LEGEND**

 CRUSHED ROCK BACKFILL

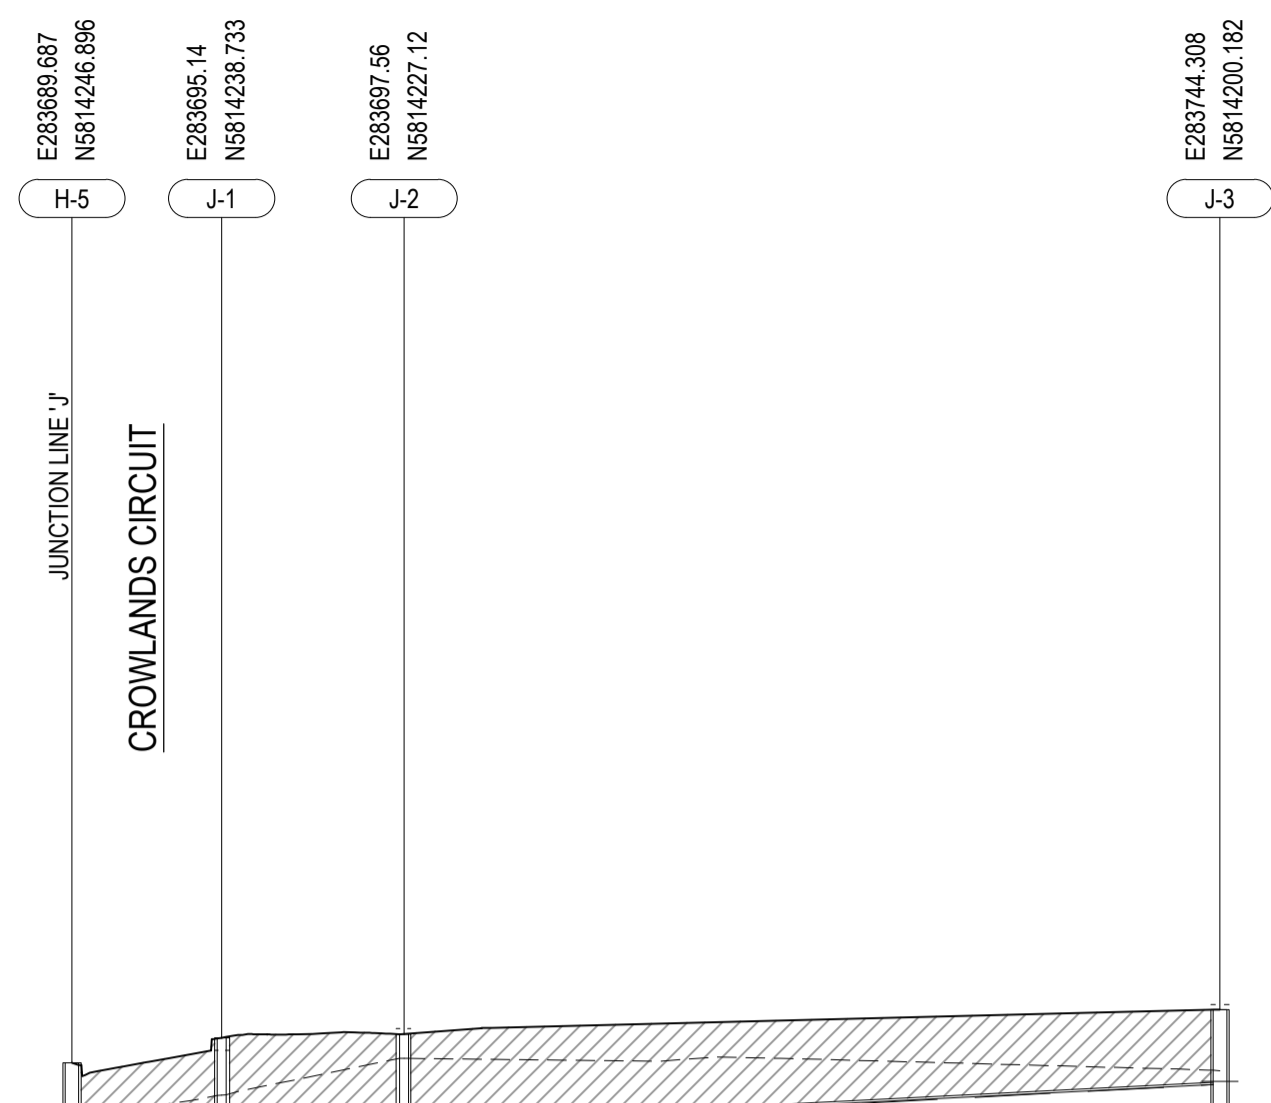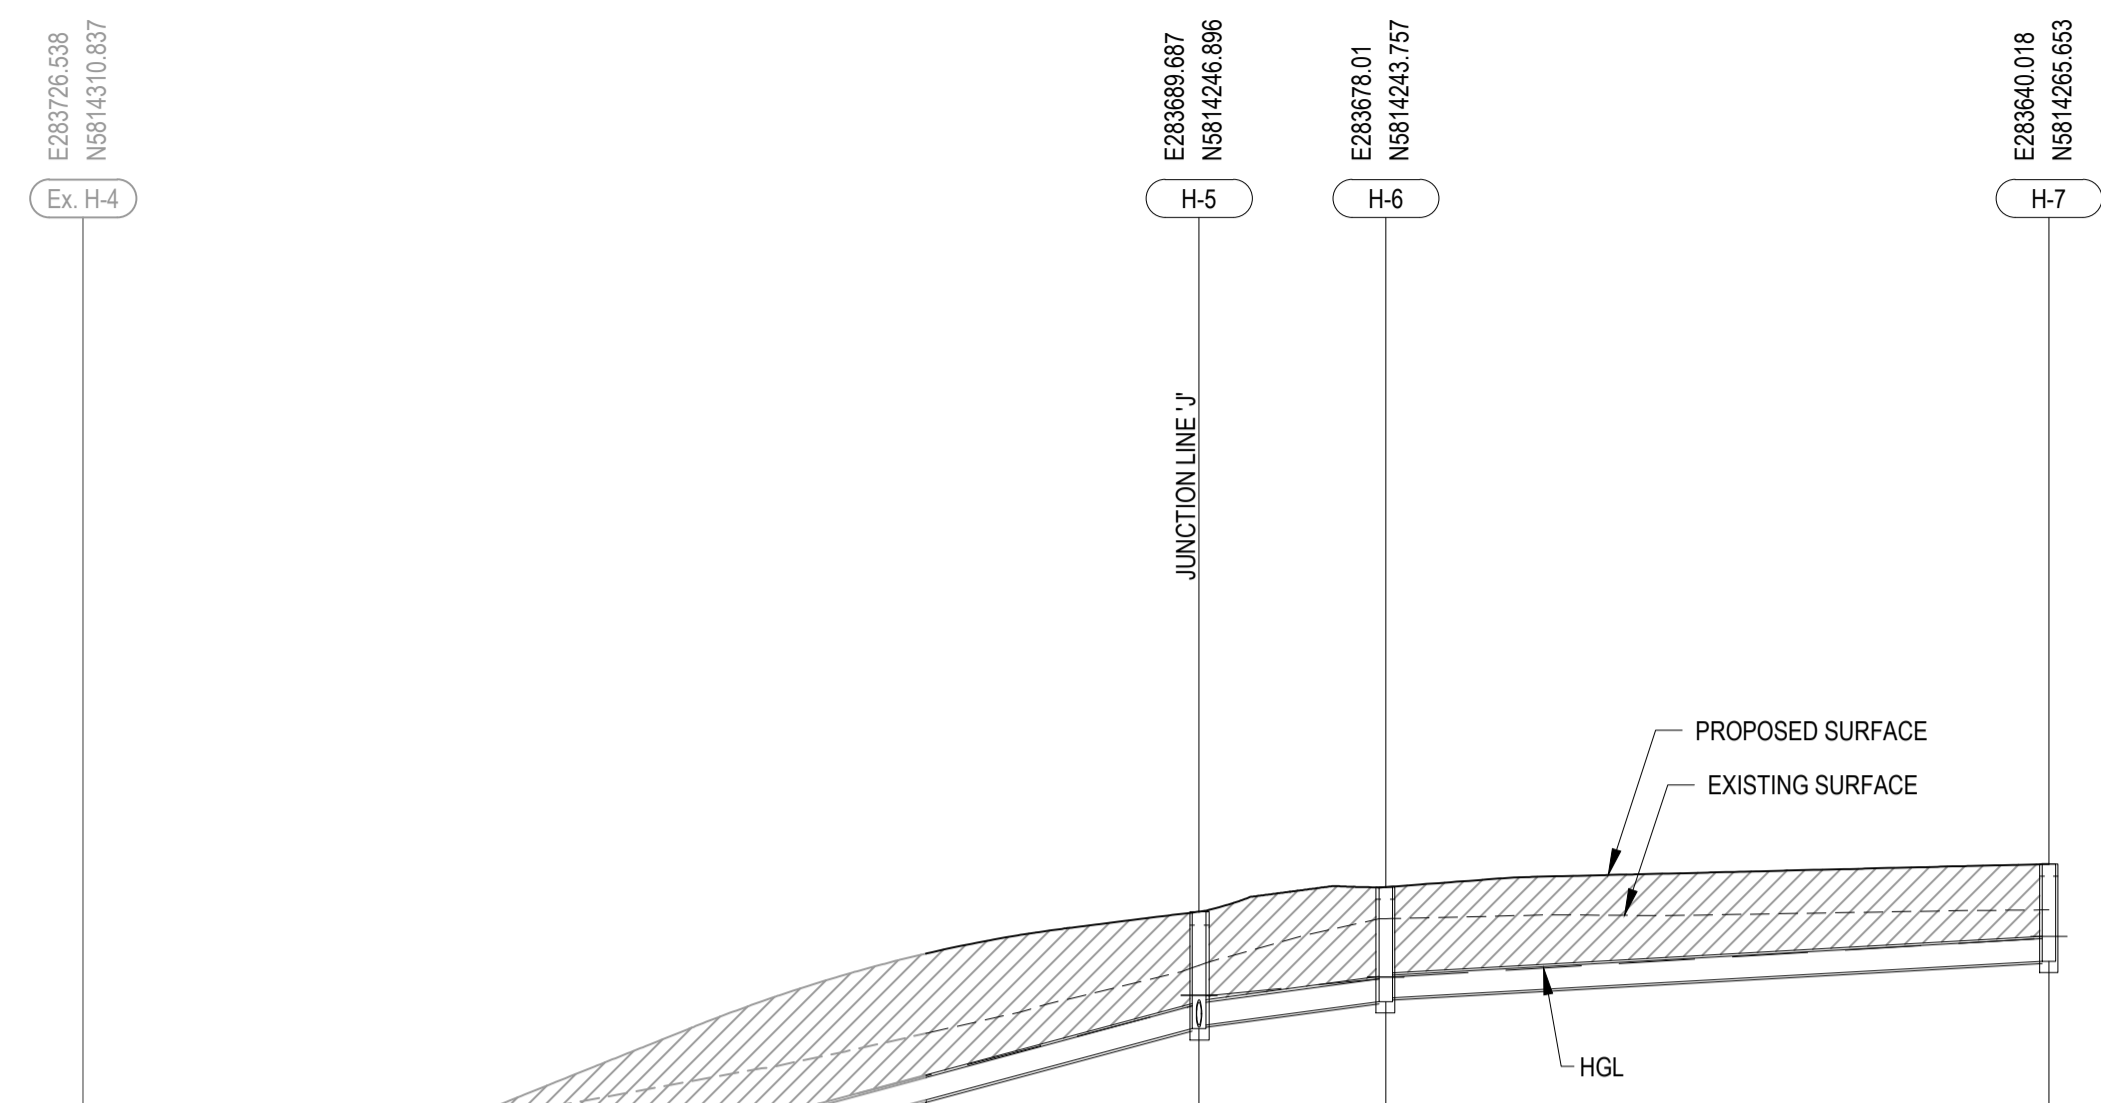

FLOW (m³/s)	0.085	0.033	0.021
FLOW CAPACITY (m³/s)	0.267	0.176	0.116
PIPE VELOCITY (m/s)	3.634	2.491	1.648
PIPE SIZE & CLASS	Ø300 RCP Class 2	Ø300 RCP Class 2	Ø300 RCP Class 2
GRADE (%)	5.3%	2.5%	1.1%

FLOW (m³/s)	0.033	0.034	0.025
FLOW CAPACITY (m³/s)	0.136	0.111	0.111
PIPE VELOCITY (m/s)	1.926	1.570	1.570
PIPE SIZE & CLASS	Ø300 RCP Class 2	Ø300 RCP Class 2	Ø300 RCP Class 2
GRADE (%)	1.5%	1.0%	1.0%

Datum R.L	76.00			
DEPTH TO INVERT	1.449	1.547	1.497	1.286
H.G.L. LEVEL 5 YEAR ARI	94.110	98.071	98.213	98.963
INVERT LEVEL	93.810	97.771	97.821	96.663
PROPOSED LEVEL	95.259	99.319	99.644	99.949
EXISTING LEVEL	95.767	96.609	99.225	99.342
CHAINAGE	143.892	217.692	230.047	273.887

Datum R.L	78.00			
DEPTH TO INVERT	1.547	1.497	1.682	1.293
H.G.L. LEVEL 5 YEAR ARI	98.071	98.213	98.273	99.030
INVERT LEVEL	97.771	97.821	96.020	96.730
PROPOSED LEVEL	99.319	99.652	99.702	100.023
EXISTING LEVEL	96.609	98.892	99.278	99.216
CHAINAGE	0.000	9.900	21.972	75.926

LINE H

LINE J

**AS CONSTRUCTED RECORDS**

THE OBJECTIVE OF THESE 'AS-CONSTRUCTED DRAWINGS' IS TO REFLECT ANY SIGNIFICANT CHANGES TO THE APPROVED CONSTRUCTION DRAWINGS AND PROVIDE COUNCIL WITH A RECORD OF DESIGN INTENT. ANY LEVELS AND COORDINATES SHOWN ON THESE PLANS ARE SUBJECT TO SURVEY AND WILL DIFFER. ARCADIS ACCEPT NO RESPONSIBILITY FOR LOSS OR DAMAGES RESULTING FROM THE INTERPRETATION OF THESE DRAWINGS. ALL DETAILS AND ASSETS MUST BE ASCERTAINED AND VERIFIED BY THE END USER.

Issue	Description	By	Ckd	PM	Date
B	AS CONSTRUCTED	WB	ZS	SE	07.10.21
A	ISSUED FOR CONSTRUCTION	WB	ZS	SE	04.12.20
03	UPDATES TO ADDRESS COUNCIL COMMENTS	WB	ZS	SE	03.08.20
02	ISSUED FOR APPROVAL	WB	ZS	SE	10.07.20
01	ISSUED TO CLIENT FOR REVIEW	WB	ZS	SE	07.11.19

Scale

0 5 10 20 30 40 50m

1 : 500 (H)

0 1 2 4 6 8 10m

1 : 100 (V)

Planner

**RD** RobertsDay  
planning.design.place

Filename C-08c-300-10029435-SwdLS.dwg

Client

**RESIMAX GROUP**

Status: AS CONSTRUCTED

Verifier: Z.STROGUSZ

Scales: 1:500 (H), 1:100 (V)

Original Size: A1

Height Datum: AHD

Grid: MGA

Original Issue Signatures: Drawn W.BUMAGAT, Designed J.ROCK, Project Manager S.EISEL

© Copyright reserved

Project: EYNESBURY TOWNSHIP STAGE 8C

Title: STORMWATER DRAINAGE LONGITUDINAL SECTIONS SHEET 1 OF 2


**ARCADIS**


Arcadis Australia Pacific Pty Limited  
Level 32, 140 William Street  
Melbourne VIC 3000  
ABN 76 104 485 289  
Tel No: +61 3 8623 4000  
www.arcadis.com

Drawing No: C-08C-300 — Project No: 10029435 — Issue: B

- NOTES:**
- PIPE TRENCHES WITHIN THE ROAD RESERVE MUST BE BACKFILLED WITH 20mm CLASS 3 CRUSHED ROCK TO BE COMPACTED TO A DENSITY NOT LESS THAN 97% OF MAXIMUM FOUND IN THE STANDARD COMPACTION TEST FOR THE FOLLOWING:
    - BENEATH THE ROAD PAVEMENT OR DRIVEWAY CROSSOVER TO THE UNDERSIDE OF THE PAVEMENT OF CROSSOVER
    - ADJACENT TO KERBING OR CONCRETE WORKS TO A LEVEL THAT IS NOT AFFECTED BY A 45 DEGREE ANGLE OR REPOSE FROM NEAR THE LOWER EDGE
  - ALL DRAINAGE PIPES TO BE RUBBER RING BELLED SOCKET JOINT TYPE (RRJ).
  - ALL DRAINAGE PIPES SHALL BE CLASS 2 RCP, UNLESS OTHERWISE NOTED.
  - WHERE PITS DROP LESS THAN 50mm THE PIT FLOOR MUST BE SHAPED TO MATCH THE LOWER HALF OF THE PIPE.
  - REFER TO SHEET C-08C-002 FOR GENERAL NOTES.

**LEGEND**

 CRUSHED ROCK BACKFILL

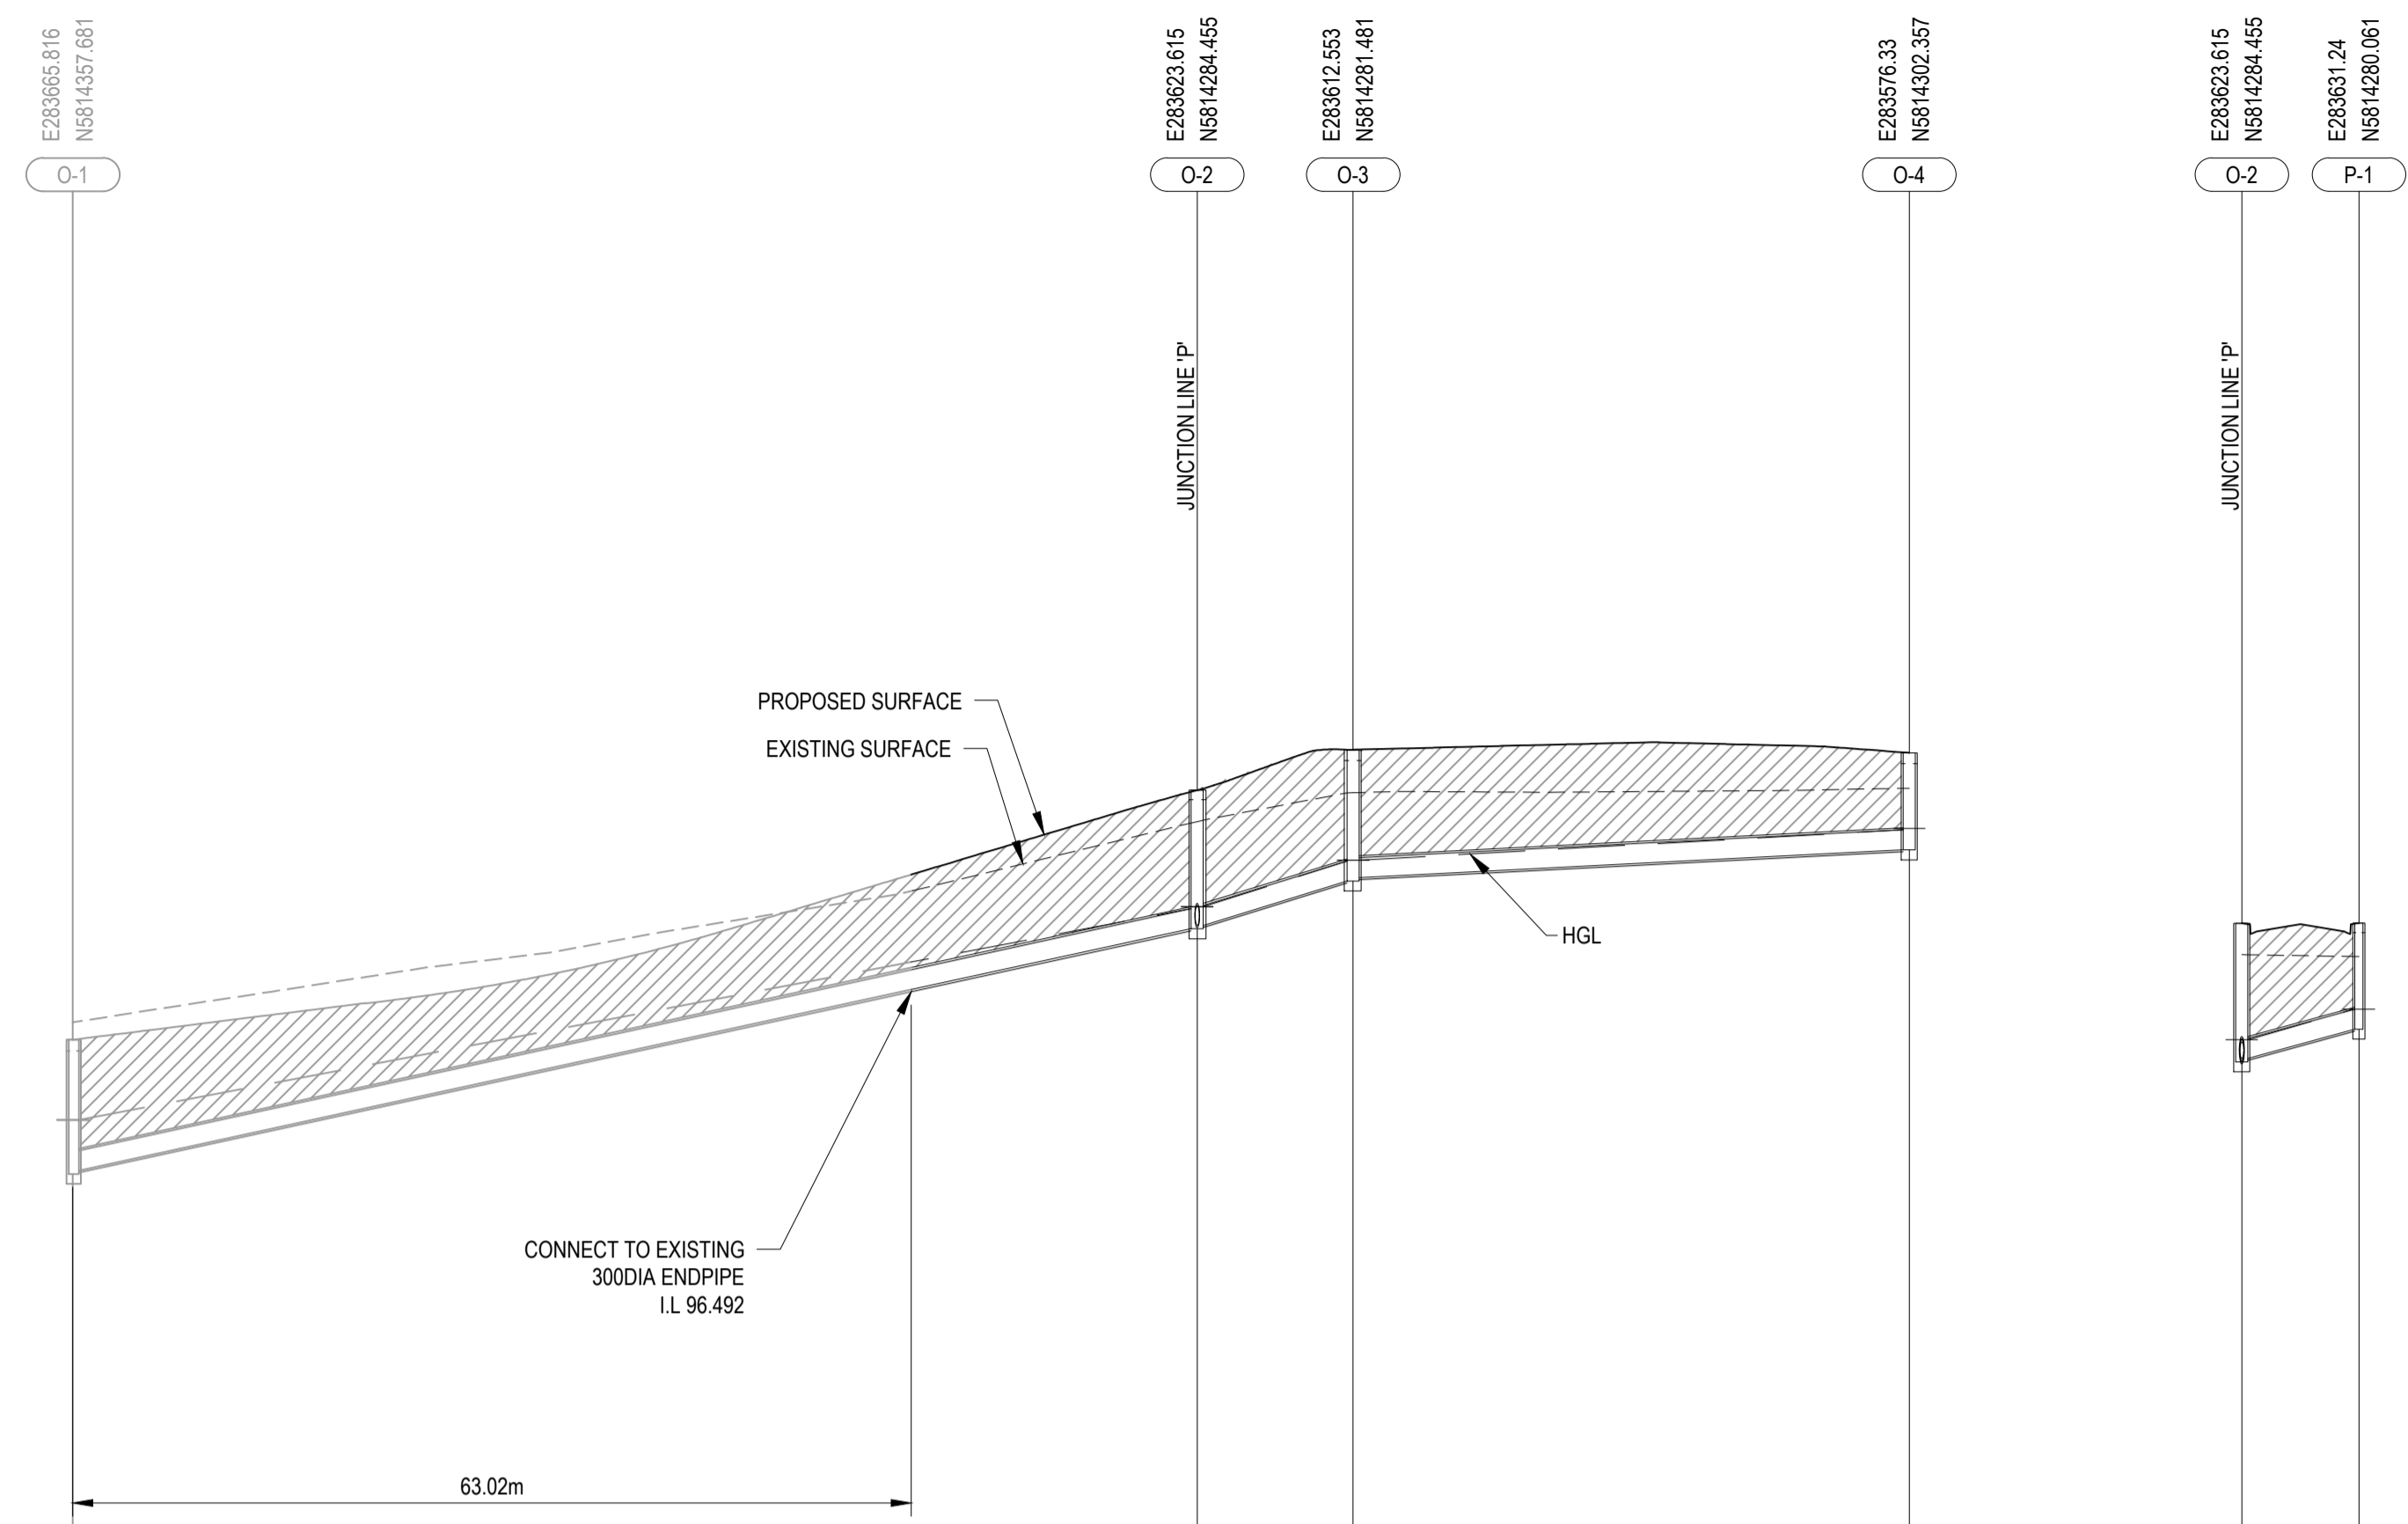


FLOW (m/s)	0.039	0.025	0.018	0.003
FLOW CAPACITY (m³/s)	0.231	0.266	0.111	0.249
PIPE VELOCITY (m/s)	3.272	3.769	1.570	3.529
PIPE SIZE & CLASS	Ø300 RCP Class 2	Ø300 RCP Class 2	Ø300 RCP Class 2	Ø300 RCP Class 2
GRADE (%)	4.3%	5.7%	1.0%	5.0%
Datum R.L	76.00			78.00
DEPTH TO INVERT	2.017 1.967	2.082 2.032	1.973 1.923	1.458
H.G.L. LEVEL 5 YEAR ARI	94.481 94.544	97.716 97.748	98.434 98.447	98.992 98.925
INVERT LEVEL	93.732 93.782	97.416 97.466	96.134 96.184	98.602 98.602
PROPOSED LEVEL	95.748 95.748	99.498 99.498	100.107 100.107	100.080 100.080
EXISTING LEVEL	96.010 96.010	99.027 99.027	99.461 99.461	99.527 99.527
CHAINAGE	9.829 L=84.516	94.345 L=11.719	106.063 L=41.808	147.871

**AS CONSTRUCTED RECORDS**

THE OBJECTIVE OF THESE 'AS-CONSTRUCTED DRAWINGS' IS TO REFLECT ANY SIGNIFICANT CHANGES TO THE APPROVED CONSTRUCTION DRAWINGS AND PROVIDE COUNCIL WITH A RECORD OF DESIGN INTENT. ANY LEVELS AND COORDINATES SHOWN ON THESE PLANS ARE SUBJECT TO SURVEY AND WILL DIFFER. ARCADIS ACCEPT NO RESPONSIBILITY FOR LOSS OR DAMAGES RESULTING FROM THE INTERPRETATION OF THESE DRAWINGS. ALL DETAILS AND ASSETS MUST BE ASCERTAINED AND VERIFIED BY THE END USER.

Issue	Description	By	Ckd	PM	Date
B	AS CONSTRUCTED	WB	ZS	SE	07.10.21
A	ISSUED FOR CONSTRUCTION	WB	ZS	SE	04.12.20
03	UPDATES TO ADDRESS COUNCIL COMMENTS	WB	ZS	SE	03.08.20
02	ISSUED FOR APPROVAL	WB	ZS	SE	10.07.20
01	ISSUED TO CLIENT FOR REVIEW	WB	ZS	SE	07.11.19

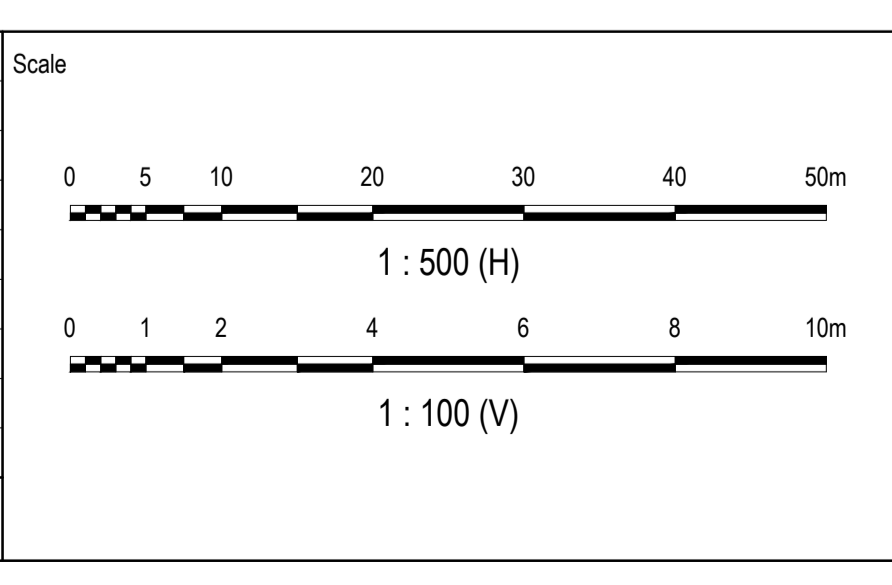

Planner

RD RobertsDay  
planning.design.place

Client

RESIMAX  
GROUP

Filename C-08c-301-10029435-SwdLS.dwg

Status

**AS CONSTRUCTED**

Verifier

Z.STROGUSZ

Scales

1:500 (H)  
1:100 (V)

Original Issue Signatures

Original Size

**A1**

Height Datum

AHD

Grid

MGA

Drawn

W.BUMAGAT

Designed

J.ROCK

Project Manager

S.EISEL

Copyright reserved

Project

EYNESBURY TOWNSHIP  
STAGE 8C

Title

STORMWATER DRAINAGE  
LONGITUDINAL SECTIONS  
SHEET 2 OF 2

Arcadis Australia Pacific Pty Limited  
Level 32, 140 William Street  
Melbourne VIC 3000  
ABN 76 104 485 289  
Tel No: +61 3 8623 4000  
www.arcadis.com

Drawing No.

C-08C-301

Project No.

10029435

Issue

B

**NOTES:**

- EASTING AND NORTHING SETOUT TO PIT CENTRE.
- SETOUT LEVEL TO PIT COVER LEVEL.
- REFER TO SHEET C-08C-002 FOR GENERAL NOTES.

PIT SCHEDULE													
NAME	PIT			INTERNAL		INLET		OUTLET		PIT		STANDARD DRAWING	REMARKS
	TYPE	EASTING	NORTHING	WIDTH	LENGTH	DIAMETER	IL	DIAMETER	IL	SETOUT RL	DEPTH		
H-5	SIDE ENTRY PIT GRATED	283689.687	5814246.896	0.9	0.9	300	97.821	300	97.771	99.319	1.547	EDCM 601 & 607	PIT TO BE HAUNCHED TO 0.6m x 0.9m
H-6	SIDE ENTRY PIT GRATED	283678.010	5814243.757	0.9	0.9	300	98.180	300	98.130	99.644	1.514	EDCM 601 & 607	PIT TO BE HAUNCHED TO 0.6m x 0.9m
H-7	JUNCTION PIT	283640.018	5814265.653	0.6	0.9			300	98.663	99.949	1.286	EDCM 605	CLASS D HEAVY DUTY CAST IRON COVER AS PER EDCM 605
J-1	JUNCTION PIT	283695.140	5814238.733	0.6	0.9	300	98.020	300	97.970	99.652	1.682	EDCM 605	CLASS D HEAVY DUTY CAST IRON COVER AS PER EDCM 605
J-2	GRATED PIT	283697.560	5814227.120	0.9	0.6	300	98.191	300	98.141	99.702	1.562	EDCM 605	CLASS D HEAVY DUTY V-GRATE
J-3	JUNCTION PIT	283744.308	5814200.182	0.6	0.9			300	98.730	100.023	1.293	EDCM 605	CLASS D HEAVY DUTY CAST IRON COVER AS PER EDCM 605
O-2	SIDE ENTRY PIT GRATED	283623.615	5814284.455	0.9	0.9	300	97.466	300	97.416	99.498	2.082	EDCM 601 & 607	PIT TO BE HAUNCHED TO 0.6m x 0.9m
O-3	SIDE ENTRY PIT GRATED	283612.553	5814281.481	0.9	0.9	300	98.184	300	98.134	100.107	1.973	EDCM 601 & 607	PIT TO BE HAUNCHED TO 0.6m x 0.9m
O-4	SIDE ENTRY PIT GRATED	283576.330	5814302.357	0.6	0.9			300	98.602	100.060	1.458	EDCM 601	
P-1	SIDE ENTRY PIT GRATED	283631.240	5814280.061	0.6	0.9			300	97.906	99.503	1.597	EDCM 601	


**AS CONSTRUCTED RECORDS**

THE OBJECTIVE OF THESE 'AS-CONSTRUCTED DRAWINGS' IS TO REFLECT ANY SIGNIFICANT CHANGES TO THE APPROVED CONSTRUCTION DRAWINGS AND PROVIDE COUNCIL WITH A RECORD OF DESIGN INTENT. ANY LEVELS AND COORDINATES SHOWN ON THESE PLANS ARE SUBJECT TO SURVEY AND WILL DIFFER. ARCADIS ACCEPT NO RESPONSIBILITY FOR LOSS OR DAMAGES RESULTING FROM THE INTERPRETATION OF THESE DRAWINGS. ALL DETAILS AND ASSETS MUST BE ASCERTAINED AND VERIFIED BY THE END USER.

Issue	Description	By	Ckd	PM	Date
B	AS CONSTRUCTED	WB	ZS	SE	07.10.21
A	ISSUED FOR CONSTRUCTION	WB	ZS	SE	04.12.20
03	UPDATES TO ADDRESS COUNCIL COMMENTS	WB	ZS	SE	03.08.20
02	ISSUED FOR APPROVAL	WB	ZS	SE	10.07.20
01	ISSUED TO CLIENT FOR REVIEW	WB	ZS	SE	07.11.19

Scale	
-------	--

Planner



Filename C-08c-320-10029435-SWDPISchedule.dwg

Client



Status **AS CONSTRUCTED**

Verifier **Z.STROGUSZ**

Scales

Original Size **A1**

Height Datum **AHD**

Grid **MGA**

Original Issue Signatures

Drawn **W.BUMAGAT**


Designed **J.ROCK**

Project Manager **S.EISEL**

© Copyright reserved


Project **EYNESBURY TOWNSHIP STAGE 8C**

Title **STORMWATER DRAINAGE PIT SCHEDULE**



Arcadis Australia Pacific Pty Limited  
Level 32, 140 William Street  
Melbourne VIC 3000  
ABN 76 104 485 289  
Tel No: +61 3 8623 4000  
www.arcadis.com

Drawing No. **C-08C-320** | Project No. **10029435** | Issue **B**

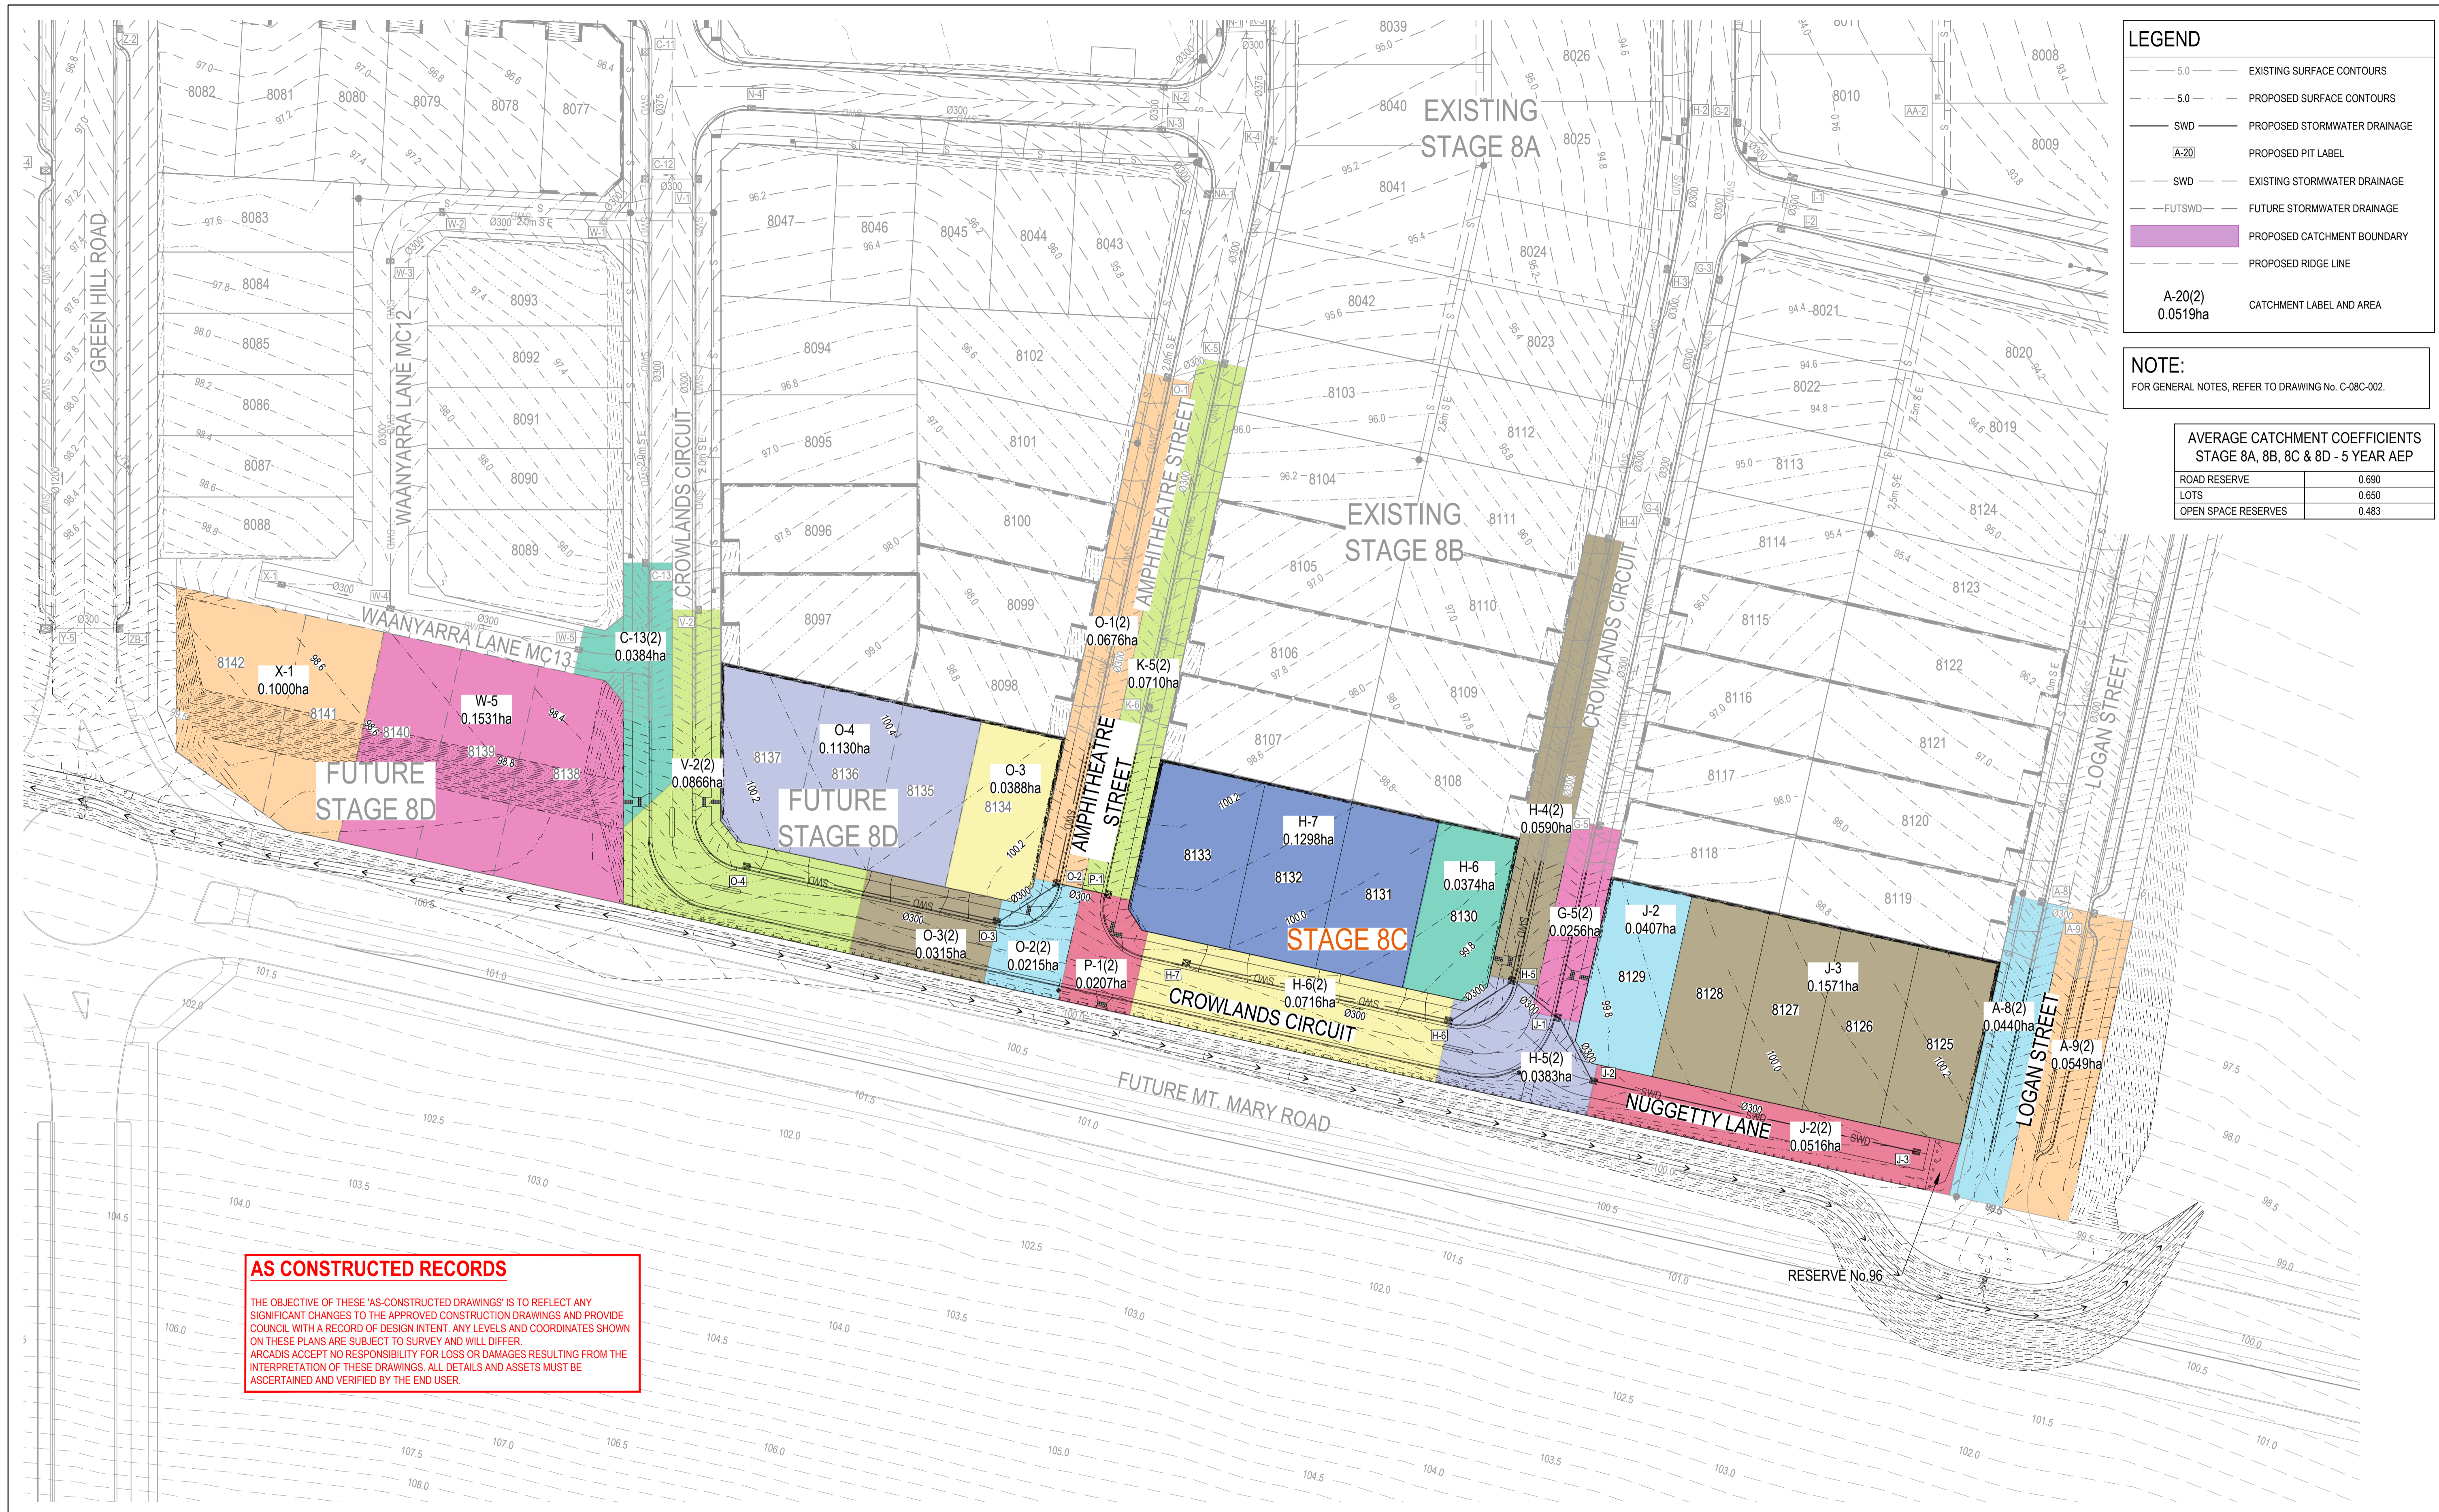

**LEGEND**

- 5.0 — EXISTING SURFACE CONTOURS
- 5.0 — PROPOSED SURFACE CONTOURS
- SWD — PROPOSED STORMWATER DRAINAGE
- A-20 — PROPOSED PIT LABEL
- SWD — EXISTING STORMWATER DRAINAGE
- FUTSWD — FUTURE STORMWATER DRAINAGE
- PROPOSED CATCHMENT BOUNDARY
- PROPOSED RIDGE LINE

A-20(2)  
0.0519ha  
CATCHMENT LABEL AND AREA

**NOTE:**  
FOR GENERAL NOTES, REFER TO DRAWING No. C-08C-002.


**AVERAGE CATCHMENT COEFFICIENTS  
STAGE 8A, 8B, 8C & 8D - 5 YEAR AEP**

ROAD RESERVE	0.690
LOTS	0.650
OPEN SPACE RESERVES	0.463

**AS CONSTRUCTED RECORDS**

THE OBJECTIVE OF THESE 'AS-CONSTRUCTED DRAWINGS' IS TO REFLECT ANY SIGNIFICANT CHANGES TO THE APPROVED CONSTRUCTION DRAWINGS AND PROVIDE COUNCIL WITH A RECORD OF DESIGN INTENT. ANY LEVELS AND COORDINATES SHOWN ON THESE PLANS ARE SUBJECT TO SURVEY AND WILL DIFFER. ARCADIS ACCEPT NO RESPONSIBILITY FOR LOSS OR DAMAGES RESULTING FROM THE INTERPRETATION OF THESE DRAWINGS. ALL DETAILS AND ASSETS MUST BE ASCERTAINED AND VERIFIED BY THE END USER.

Issue	Description	By	Ckd	PM	Date
C	AS CONSTRUCTED	WB	ZS	SE	07.10.21
B	UPDATES TO LOT 8138	WB	ZS	SE	12.08.21
A	ISSUED FOR CONSTRUCTION	WB	ZS	SE	04.12.20
04	UPDATES TO ADDRESS COUNCIL COMMENTS	HP	ZS	SE	19.08.20
03	UPDATES TO ADDRESS COUNCIL COMMENTS	WB	ZS	SE	03.08.20
02	ISSUED FOR APPROVAL	WB	ZS	SE	10.07.20
01	ISSUED TO CLIENT FOR REVIEW	WB	ZS	SE	07.11.19

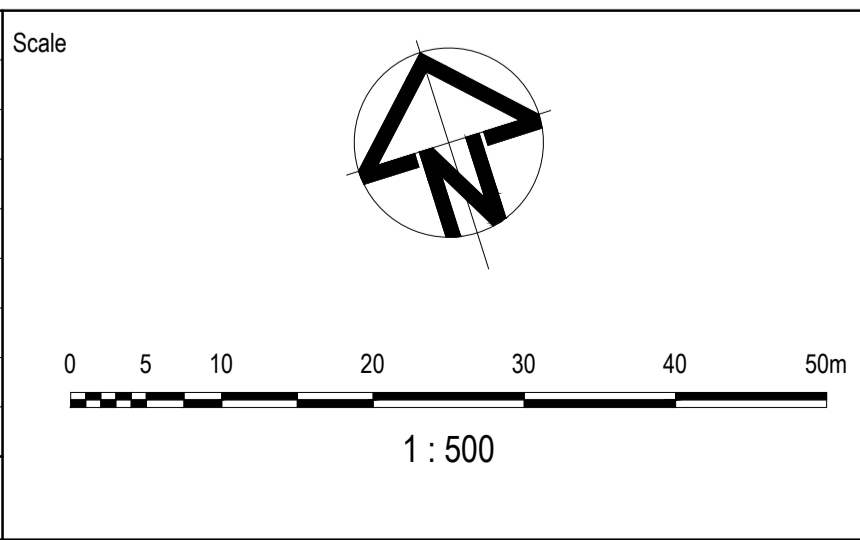

Planner

Client


Filename C-08c-350-10029435-Q5CatchmentPlan.dwg

Status	AS CONSTRUCTED	
Verifier	Z.STROGUSZ	
Scales	1:500	Original Issue Signatures
	Original Size	A1
Height Datum	AHD	Project Manager S.EISEL
Grid	MGA	© Copyright reserved

Project	EYNEBURY TOWNSHIP STAGE 8C
Title	STORMWATER DRAINAGE Q5 CATCHMENT PLAN

Arcadis Australia Pacific Pty Limited  
Level 32, 140 William Street  
Melbourne VIC 3000  
ABN 76 104 485 289  
Tel No: +61 3 8623 4000  
www.arcadis.com

Drawing No. C-08C-350  
Project No. 10029435  
Issue C

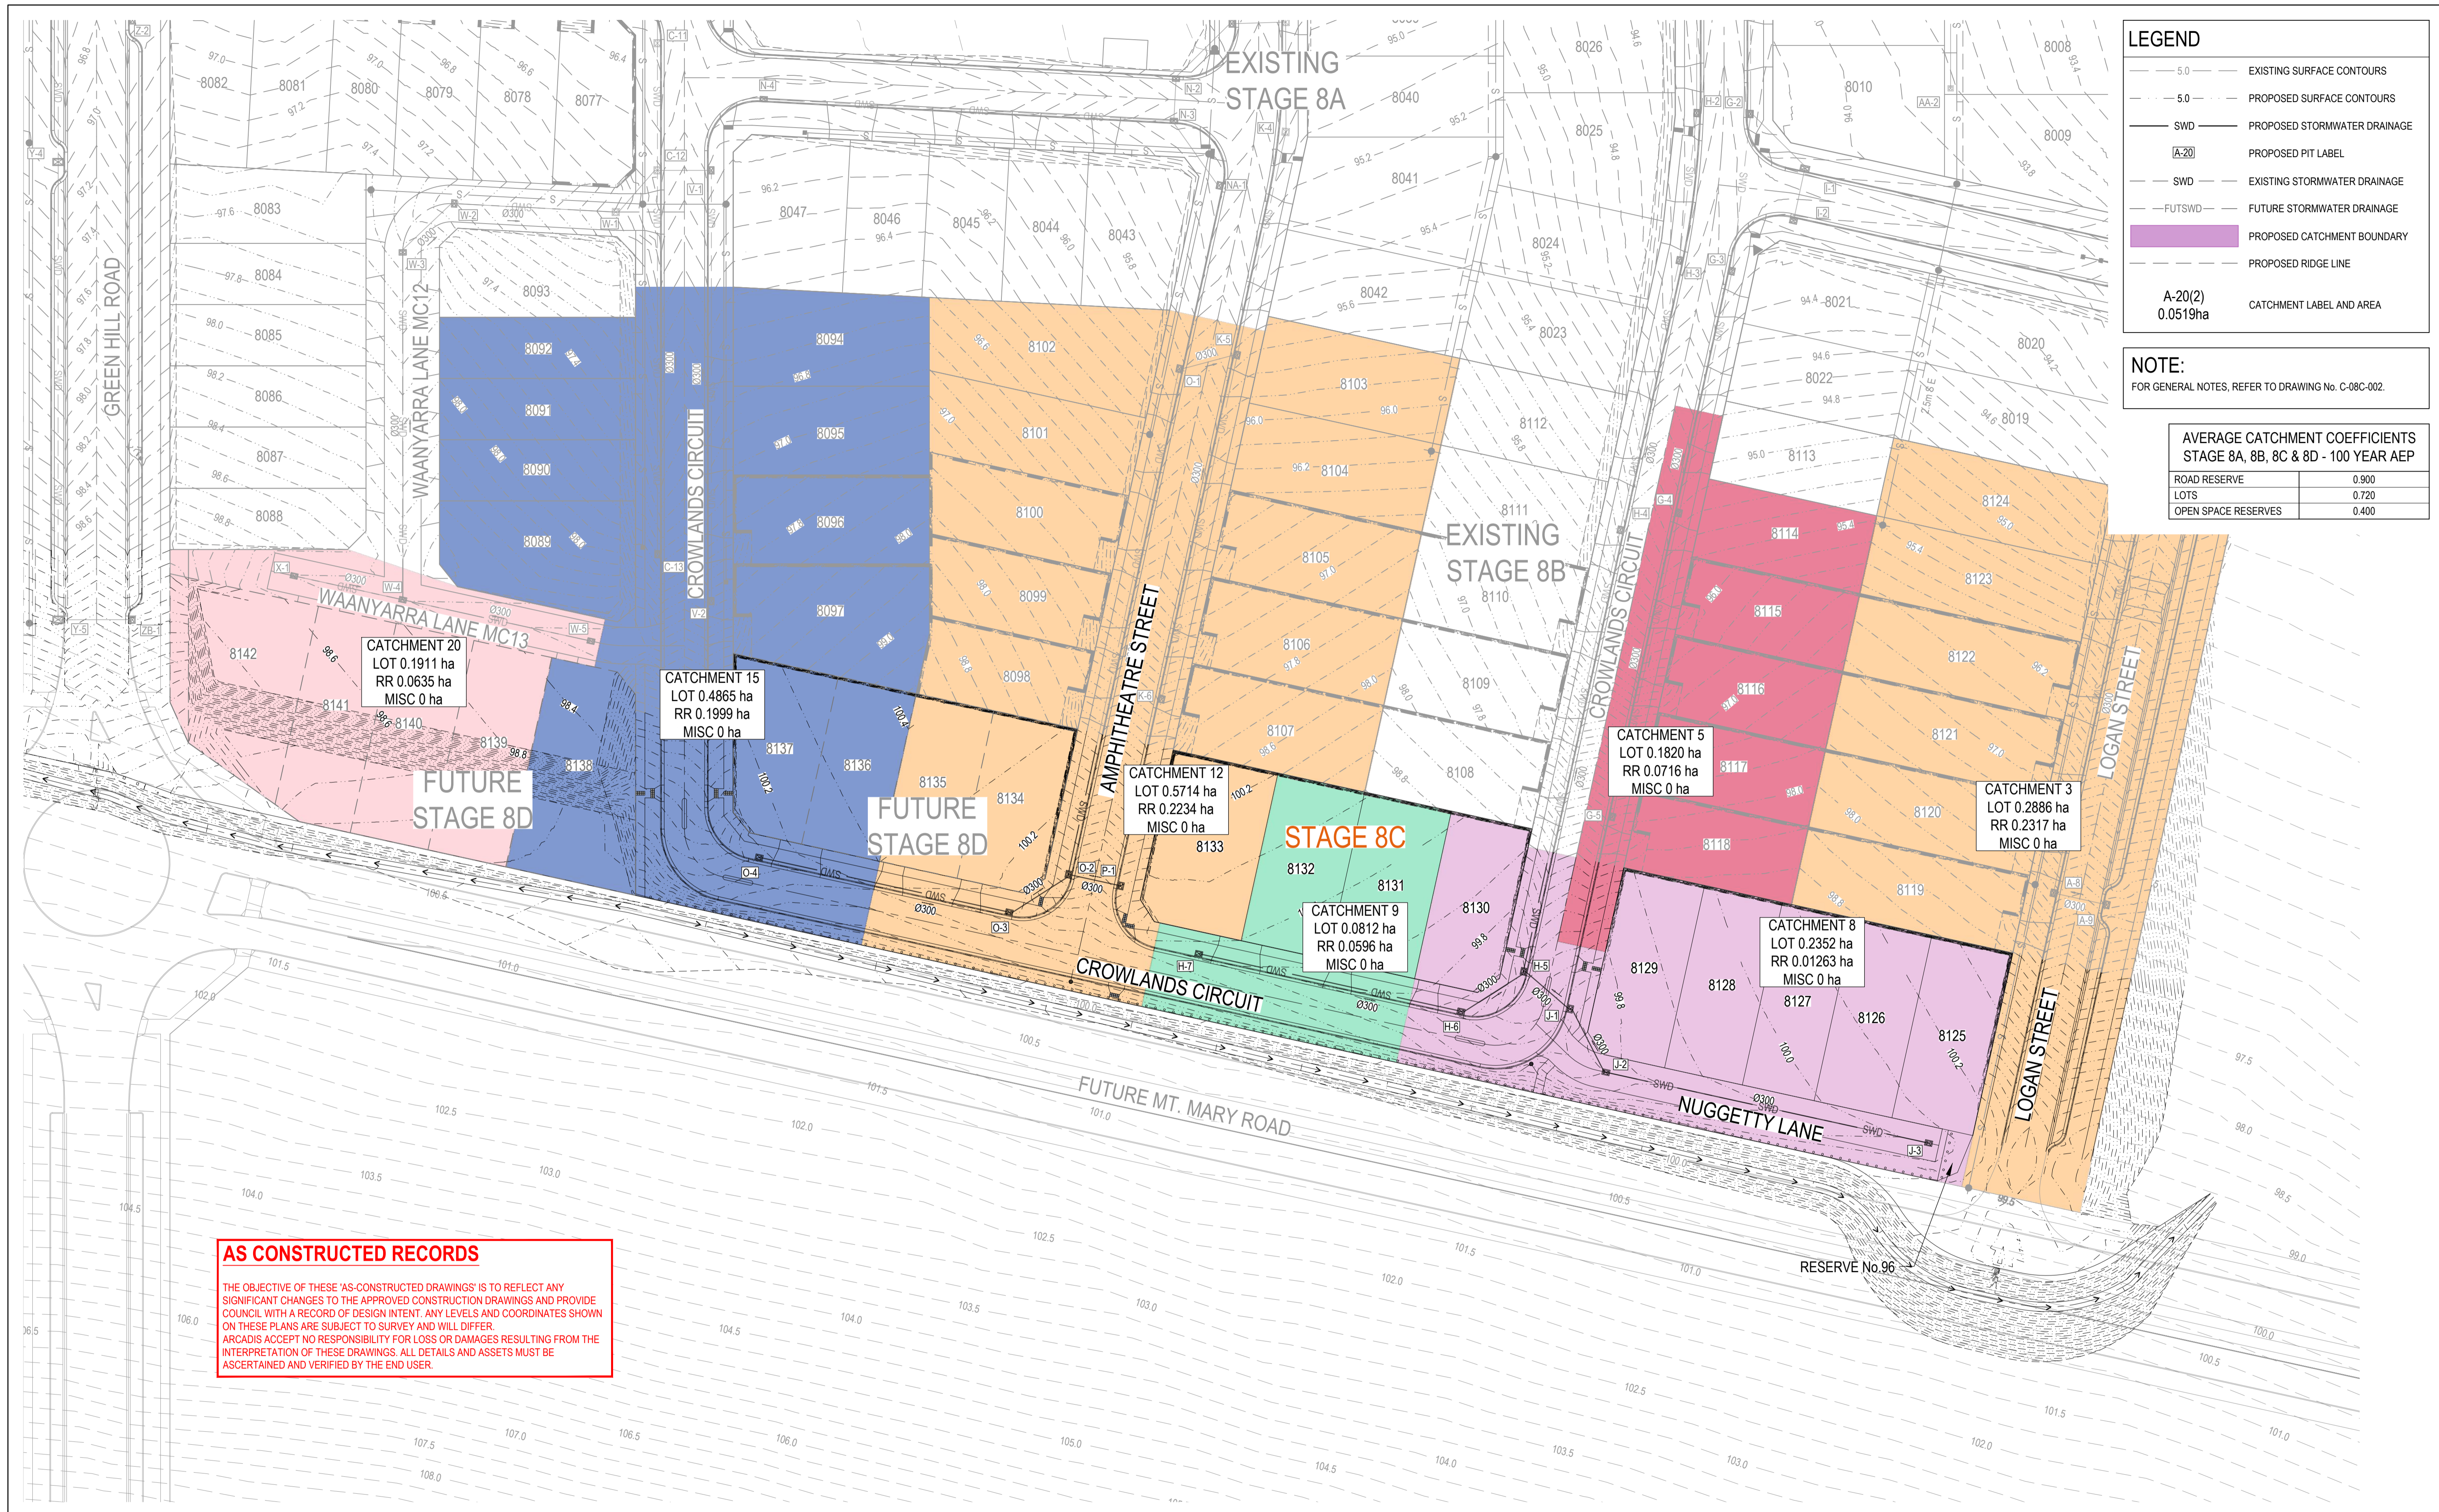

**LEGEND**

- 5.0 EXISTING SURFACE CONTOURS
- 5.0 PROPOSED SURFACE CONTOURS
- SWD PROPOSED STORMWATER DRAINAGE
- A-20 PROPOSED PIT LABEL
- SWD EXISTING STORMWATER DRAINAGE
- FUTSWD FUTURE STORMWATER DRAINAGE
- PROPOSED CATCHMENT BOUNDARY
- PROPOSED RIDGE LINE
- A-20(2)  
0.0519ha CATCHMENT LABEL AND AREA

**NOTE:**  
FOR GENERAL NOTES, REFER TO DRAWING No. C-08C-002.


**AVERAGE CATCHMENT COEFFICIENTS  
STAGE 8A, 8B, 8C & 8D - 100 YEAR AEP**

ROAD RESERVE	0.900
LOTS	0.720
OPEN SPACE RESERVES	0.400

**AS CONSTRUCTED RECORDS**

THE OBJECTIVE OF THESE 'AS-CONSTRUCTED DRAWINGS' IS TO REFLECT ANY SIGNIFICANT CHANGES TO THE APPROVED CONSTRUCTION DRAWINGS AND PROVIDE COUNCIL WITH A RECORD OF DESIGN INTENT. ANY LEVELS AND COORDINATES SHOWN ON THESE PLANS ARE SUBJECT TO SURVEY AND WILL DIFFER. ARCADIS ACCEPTS NO RESPONSIBILITY FOR LOSS OR DAMAGES RESULTING FROM THE INTERPRETATION OF THESE DRAWINGS. ALL DETAILS AND ASSETS MUST BE ASCERTAINED AND VERIFIED BY THE END USER.

Issue	Description	By	Ckd	PM	Date
C	AS CONSTRUCTED	WB	ZS	SE	07.10.21
B	UPDATES TO LOT 8138	WB	ZS	SE	12.08.21
A	ISSUED FOR CONSTRUCTION	WB	ZS	SE	04.12.20
04	UPDATES TO ADDRESS COUNCIL COMMENTS	HP	ZS	SE	19.08.20
03	UPDATES TO ADDRESS COUNCIL COMMENTS	WB	ZS	SE	03.08.20
02	ISSUED FOR APPROVAL	WB	ZS	SE	10.07.20
01	ISSUED TO CLIENT FOR REVIEW	WB	ZS	SE	07.11.19

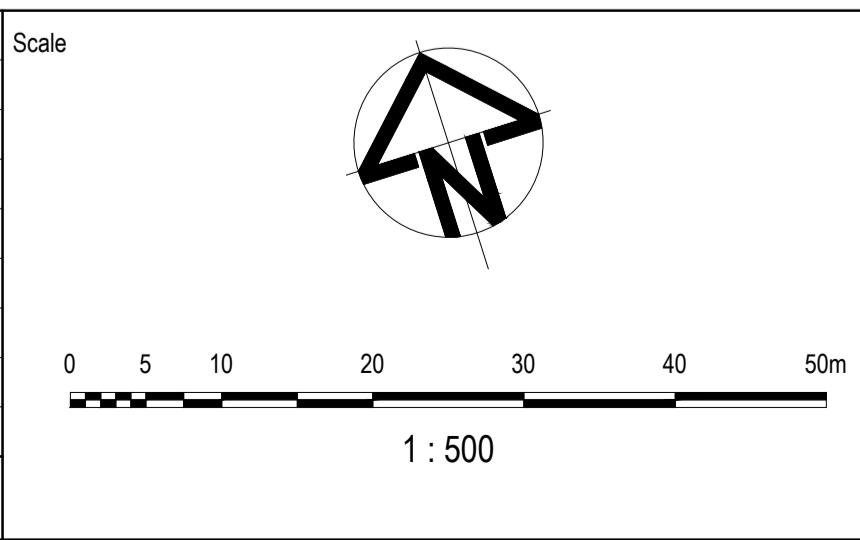

Planner

RobertsDay  
planning.design.place

Client

RESIMAX  
GROUP

Filename C-08c-351-10029435-Q100CatchmentPlan.dwg

Status: AS CONSTRUCTED

Verifier: Z.STROGUSZ

Scales: 1:500

Original Size: A1

Height Datum: AHD

Grid: MGA

Original Issue Signatures

Drawn: W.BUMAGAT

Designed: J.ROCK

Project Manager: S.EISEL

© Copyright reserved

Project: EYNEBURY TOWNSHIP  
STAGE 8C

Title: STORMWATER DRAINAGE Q100  
CATCHMENT PLAN

Arcadis Australia Pacific Pty Limited  
Level 32, 140 William Street  
Melbourne VIC 3000  
ABN 76 104 485 289  
Tel No: +61 3 8623 4000  
www.arcadis.com

Drawing No. C-08C-351  
Project No. 10029435  
Issue C

**NOTES:**  
 1. REFER TO SHEET C-08C-002 FOR GENERAL NOTES.

AVERAGE CATCHMENT COEFFICIENTS STAGE 8A, 8B, 8C & 8D - 5 YEAR AEP	
ROAD RESERVE	0.690
LOTS	0.650
OPEN SPACE RESERVES	0.483

HYDROLOGICAL DESIGN SHEET																
Pit Name	Pit Type	Setout Easting	Setout Northing	Setout RL	Catch ID	Time Tc	Intensity I	Runoff C	Area A	Full CA	Full Sum CA	Full Qc=CA	Partial CA	Partial Sum CA	Partial Qc=CA	Approach Flow Qa
(-)	(-)	(m)	(m)	(m)	(-)	(min)	(mm/hr)	(-)	(ha)	(ha)	(ha)	(L/s)	(ha)	(ha)	(L/s)	(L/s)
Ex H-4	SIDE ENTRY PIT GRATED	283726.54	5814310.84	95.26	1P	5	86.28	0.60	0.0487	0.0292	0.1214	29.10	0.0292	0.1214	29.10	29.10
					11	5	86.28	0.70	0.0731	0.0512			0.0512			
					2P	5	86.28	0.68	0.0148	0.0100			0.01			
					21	5	86.28	0.70	0.0443	0.0310			0.031			
H-5	SIDE ENTRY PIT GRATED	283689.69	5814246.9	99.32	1P	5	86.28	0.60	0.0487	0.0292	0.1070	25.70	0.0292	0.107	25.70	25.70
					11	5	86.28	0.70	0.0731	0.0512			0.0512			
					2P	5	86.28	0.68	0.0096	0.0065			0.0065			
					21	5	86.28	0.70	0.0288	0.0201			0.0201			
H-6	SIDE ENTRY PIT GRATED	283678.01	5814243.76	99.64	1P	5	86.28	0.60	0.0149	0.0090	0.0744	17.80	0.009	0.0744	17.80	17.80
					11	5	86.28	0.70	0.0224	0.0157			0.0157			
					2P	5	86.28	0.68	0.0179	0.0122			0.0122			
					21	5	86.28	0.70	0.0537	0.0376			0.0376			
H-7	JUNCTION PIT	283640.02	5814265.65	99.95	1P	5	86.28	0.60	0.0519	0.0311	0.0856	20.50	0.0311	0.0856	20.50	20.50
					11	5	86.28	0.70	0.0779	0.0545			0.0545			
J-1	JUNCTION PIT	283695.14	5814238.73	99.65												0.00
J-2	GRATED PIT	283697.56	5814227.12	99.70	1P	5	86.28	0.60	0.0163	0.0098	0.0627	15.00	0.0098	0.0627	15.00	15.00
					11	5	86.28	0.70	0.0244	0.0171			0.0171			
					2P	5	86.28	0.68	0.0129	0.0088			0.0088			
					21	5	86.28	0.70	0.0387	0.0271			0.0271			
J-3	JUNCTION PIT	283744.31	5814200.18	100.02	1P	5	86.28	0.60	0.0628	0.0377	0.1037	24.80	0.0377	0.1037	24.80	24.80
					11	5	86.28	0.70	0.0942	0.0660			0.066			
Ex O-1	SIDE ENTRY PIT GRATED	283665.82	5814357.68	95.75	1P	5	86.28	0.60	0.0571	0.0343	0.1412	33.80	0.0343	0.1412	33.80	33.80
					11	5	86.28	0.70	0.0856	0.0599			0.0599			
					2P	5	86.28	0.68	0.0189	0.0115			0.0115			
					21	5	86.28	0.70	0.0507	0.0355			0.0355			
O-2	SIDE ENTRY PIT GRATED	283623.62	5814284.45	99.50	1P	5	86.28	0.60	0.0292	0.0175	0.0631	15.10	0.0175	0.0631	15.10	15.10
					11	5	86.28	0.70	0.0438	0.0307			0.0307			
					2P	5	86.28	0.68	0.0054	0.0037			0.0037			
					21	5	86.28	0.70	0.0162	0.0113			0.0113			
O-3	SIDE ENTRY PIT GRATED	283612.55	5814281.48	100.11	1P	5	86.28	0.60	0.0155	0.0093	0.0475	11.40	0.0093	0.0475	11.40	11.40
					11	5	86.28	0.70	0.0233	0.0163			0.0163			
					2P	5	86.28	0.68	0.0079	0.0054			0.0054			
					21	5	86.28	0.70	0.0236	0.0165			0.0165			
O-4	SIDE ENTRY PIT GRATED	283576.33	5814302.36	100.06	1P	5	86.28	0.60	0.0452	0.0271	0.0746	17.90	0.0271	0.0746	17.90	17.90
					11	5	86.28	0.70	0.0678	0.0475			0.0475			
P-1	SIDE ENTRY PIT GRATED	283631.24	5814280.06	99.50	2P	5	86.28	0.68	0.0052	0.0035	0.0144	3.40	0.0035	0.0144	3.40	3.40
					21	5	86.28	0.70	0.0155	0.0109			0.0109			


**AS CONSTRUCTED RECORDS**

THE OBJECTIVE OF THESE 'AS-CONSTRUCTED DRAWINGS' IS TO REFLECT ANY SIGNIFICANT CHANGES TO THE APPROVED CONSTRUCTION DRAWINGS AND PROVIDE COUNCIL WITH A RECORD OF DESIGN INTENT. ANY LEVELS AND COORDINATES SHOWN ON THESE PLANS ARE SUBJECT TO SURVEY AND WILL DIFFER. ARCADIS ACCEPTS NO RESPONSIBILITY FOR LOSS OR DAMAGES RESULTING FROM THE INTERPRETATION OF THESE DRAWINGS. ALL DETAILS AND ASSETS MUST BE ASCERTAINED AND VERIFIED BY THE END USER.

Issue	Description	By	Ckd	PM	Date
B	AS CONSTRUCTED	WB	ZS	SE	07.10.21
A	ISSUED FOR CONSTRUCTION	WB	ZS	SE	04.12.20
03	UPDATES TO ADDRESS COUNCIL COMMENTS	WB	ZS	SE	03.08.20
02	ISSUED FOR APPROVAL	WB	ZS	SE	10.07.20
01	ISSUED TO CLIENT FOR REVIEW	WB	ZS	SE	07.11.19

Scale

Planner



Filename C-08c-360-10029435-SwdCalcsTable.dwg

Client



Status: AS CONSTRUCTED

Verifier: Z.STROGUSZ

Original Issue Signatures

Drawn: W.BUMAGAT

Designed: J.ROCK

Project Manager: S.EISEL

Original Size: A1


Height Datum: AHD

Grid: MGA

Copyright reserved

Project: EYNESBURY TOWNSHIP STAGE 8C

Title: STORMWATER DRAINAGE CALCULATION TABLES SHEET 1 OF 2



Arcadis Australia Pacific Pty Limited  
 Level 32, 140 William Street  
 Melbourne VIC 3000  
 ABN 76 104 485 289  
 Tel No: +61 3 8623 4000  
 www.arcadis.com

Drawing No: C-08C-360 — Project No: 10029435 — Issue: B

**NOTES:**  
 1. REFER TO SHEET C-08C-002 FOR GENERAL NOTES.

AVERAGE CATCHMENT COEFFICIENTS STAGE 8A, 8B, 8C & 8D - 5 YEAR AEP	
ROAD RESERVE	0.690
LOTS	0.650
OPEN SPACE RESERVES	0.483

**HYDRAULICS DESIGN SHEET**

Pipe ID	Pipe Type	Pipe Length	Pipe Size	Full Pipe Area Af	Pipe Grade	Pipe Grade	Full-area Tct	Full-area I	Full-area Sum CA	Full-area Qc=CIA	Part-area Tct	Part-area I	Part-area Sum CA	Part-area Qc=CIA	Pipe Flow Q	Capacity Flow Qcap	Q/Qcap Ratio	Full Pipe Vel Vf=Q/Af	Norm Depth Vn=Q/An	Crit Depth Vc=Q/Ac	Capacity Vel Vcap=Qcap/Af	US Pit Grate RL	Pipe US IL	Pipe DS IL	DS Pit Grate RL	Cover Limit	Cover Min	Pipe DS Bend	Pipe DS Drop	US Pit Ku	US Pit Kw	Pipe V/head	P'head Loss (Ku.V'head)	WSE Loss (Kw.V'head)	Pipe T'head Loss	US Pit HGL	Pipe US HGL	Pipe DS HGL	DS Pit HGL	HGL Grade	HGL Grade	F'board US
(-)	(-)	(m)	(mm)	(sq.m)	(%)	(1 in)	(min)	(mm/hr)	(ha)	(L/s)	(min)	(mm/hr)	(ha)	(L/s)	(L/s)	(L/s)	(-)	(m/s)	(m/s)	(m/s)	(m/s)	(m)	(m)	(m)	(m)	(m)	(m)	(deg)	(m)	(-)	(-)	(m)	(m)	(m)	(m)	(m)	(m)	(m)	(%)	(1 in)	(m)	
H-5 to H-4	RCP Class 2	73.80	300	0.071	5.30	18.90	8.33	70.45	0.4335	84.80	7.96	71.80	0.4259	84.90	84.90	256.90	0.33	1.20	3.27	1.48	3.63	99.14	97.77	93.86	95.08	0.90	0.90	0.00	0.05	1.80	1.92	0.07	0.13	0.14	3.82	98.21	98.07	94.25	94.25	5.18	19.30	0.93
H-6 to H-5	RCP Class 2	12.36	300	0.071	2.50	40.00	7.52	73.55	0.1601	32.70	5.00	86.28	0.1169	28.00	32.70	176.10	0.19	0.46	1.92	1.02	2.49	99.48	98.13	97.82	99.14	1.10	1.18	45.00	0.05	2.31		0.01	0.03	0.23	98.46	98.43	98.20	98.21	1.83	54.70	1.03	
H-7 to H-6	RCP Class 2	43.85	300	0.071	1.10	90.90	5.00	86.28	0.0856	20.50	5.00	86.28	0.0856	20.50	20.50	116.50	0.18	0.29	1.25	0.89	1.65	99.79	98.66	98.18	99.48	0.90	0.95	45.00	0.05	7.00		0.00	0.03	0.51	98.99	98.96	98.46	98.46	1.16	86.50	0.79	
J-1 to H-5	RCP Class 2	9.90	300	0.071	1.50	66.70	7.98	71.75	0.1664	33.20	5.42	83.72	0.1134	26.40	33.20	136.20	0.24	0.47	1.60	1.03	1.93	99.48	97.97	97.82	99.14	0.90	0.99	-61.60	0.05	0.27		0.01	0.00	0.07	98.27	98.27	98.20	98.21	0.66	150.90	1.21	
J-2 to J-1	RCP Class 2	12.07	300	0.071	1.00	100.00	7.56	73.38	0.1664	33.90	5.00	86.28	0.1134	27.20	33.90	111.00	0.31	0.48	1.38	1.04	1.57	99.77	98.14	98.02	99.48	1.10	1.23	22.10	0.05	2.05	2.14	0.01	0.02	0.03	0.16	98.47	98.44	98.27	98.27	1.39	72.00	1.31
J-3 to J-2	RCP Class 2	53.95	300	0.071	1.00	100.00	5.00	86.28	0.1037	24.80	5.00	86.28	0.1037	24.80	24.80	111.00	0.22	0.35	1.27	0.94	1.57	100.09	98.73	98.19	99.77	0.90	0.96	-50.50	0.05	7.00		0.01	0.04	0.56	99.07	99.03	98.46	98.47	1.05	95.40	1.02	
O-2 to O-1	RCP Class 2	84.52	300	0.071	4.30	23.30	8.32	70.49	0.1996	39.10	8.01	71.64	0.1949	38.80	39.10	231.30	0.17	0.55	2.45	1.08	3.27	99.36	97.42	93.78	95.58	0.90	1.08	-62.70	0.05	1.98	2.07	0.02	0.03	0.03	3.17	97.75	97.72	94.54	94.54	3.75	26.6	1.61
O-3 to O-2	RCP Class 2	11.72	300	0.071	5.70	17.50	7.76	72.60	0.1220	24.60	5.00	86.28	0.0809	19.40	24.60	266.40	0.09	0.35	2.38	0.94	3.77	99.94	98.13	97.47	99.36	1.10	1.64	45.00	0.05	2.10		0.01	0.01	0.69	98.45	98.43	97.75	97.75	5.86	17.1	1.5	
O-4 to O-3	RCP Class 2	41.81	300	0.071	1.00	100.00	5.00	86.28	0.0746	17.90	5.00	86.28	0.0746	17.90	17.90	111.00	0.16	0.25	1.16	0.85	1.57	99.90	98.60	98.18	99.94	0.90	1.13	45.00	0.05	7.00		0.00	0.02	0.45	98.92	98.90	98.45	98.45	1.09	91.90	0.97	
P-1 to O-2	RCP Class 2	8.8	300	0.071	5	20	5	86.28	0.0144	3.4	5	86.28	0.0144	3.4	3.4	249.5	0.01	0.05	1.27	0.54	3.53	99.36	97.91	97.47	99.36	0.9	1.12	-90	0.05	9.7		0	0	0.46	98.21	98.21	97.75	97.75	5.22	19.2	1.15	


**AS CONSTRUCTED RECORDS**

THE OBJECTIVE OF THESE 'AS-CONSTRUCTED DRAWINGS' IS TO REFLECT ANY SIGNIFICANT CHANGES TO THE APPROVED CONSTRUCTION DRAWINGS AND PROVIDE COUNCIL WITH A RECORD OF DESIGN INTENT. ANY LEVELS AND COORDINATES SHOWN ON THESE PLANS ARE SUBJECT TO SURVEY AND WILL DIFFER. ARCADIS ACCEPT NO RESPONSIBILITY FOR LOSS OR DAMAGES RESULTING FROM THE INTERPRETATION OF THESE DRAWINGS. ALL DETAILS AND ASSETS MUST BE ASCERTAINED AND VERIFIED BY THE END USER.

Issue	Description	By	Ckd	PM	Date
B	AS CONSTRUCTED	WB	ZS	SE	07.10.21
A	ISSUED FOR CONSTRUCTION	WB	ZS	SE	04.12.20
03	UPDATES TO ADDRESS COUNCIL COMMENTS	WB	ZS	SE	03.08.20
02	ISSUED FOR APPROVAL	WB	ZS	SE	10.07.20
01	ISSUED TO CLIENT FOR REVIEW	WB	ZS	SE	07.11.19

Scale	
-------	--

Planner



Filename C-08c-361-10029435-SwdCalcsTable.dwg

Client



Status: AS CONSTRUCTED

Verifier: Z.STROGUSZ

Scales: Original Issue Signatures

Original Size: A1


Height Datum: AHD

Grid: MGA

Copyright reserved

Project: EYNESBURY TOWNSHIP STAGE 8C

Title: STORMWATER DRAINAGE CALCULATION TABLES SHEET 2 OF 2





Arcadis Australia Pacific Pty Limited  
 Level 32, 140 William Street  
 Melbourne VIC 3000  
 ABN 76 104 485 289  
 Tel No: +61 3 8623 4000  
 www.arcadis.com

Drawing No: C-08C-361 — Project No: 10029435 — Issue: B



LEGEND	
	PROPOSED STAGE BOUNDARY
FR98.86	FINISHED RIDGE LEVEL
FS97.14	FINISHED SURFACE LEVEL
TW98.16	TOP OF WALL LEVEL
BW98.16	BOTTOM OF WALL LEVEL
93.750	EXISTING SURFACE LEVEL
	PROPOSED CONCRETE FOOTPATH/DRIVEWAY
	PROPOSED KERB & CHANNEL
	PROPOSED RETAINING WALL
	EXISTING RETAINING WALL
	PROPOSED RIDGE LINE


**NOTE:**  
 1. FOR RETAINING WALL DESIGN AND DETAILS REFER TO MIGLIC STRUCTURAL DESIGN PLANS.

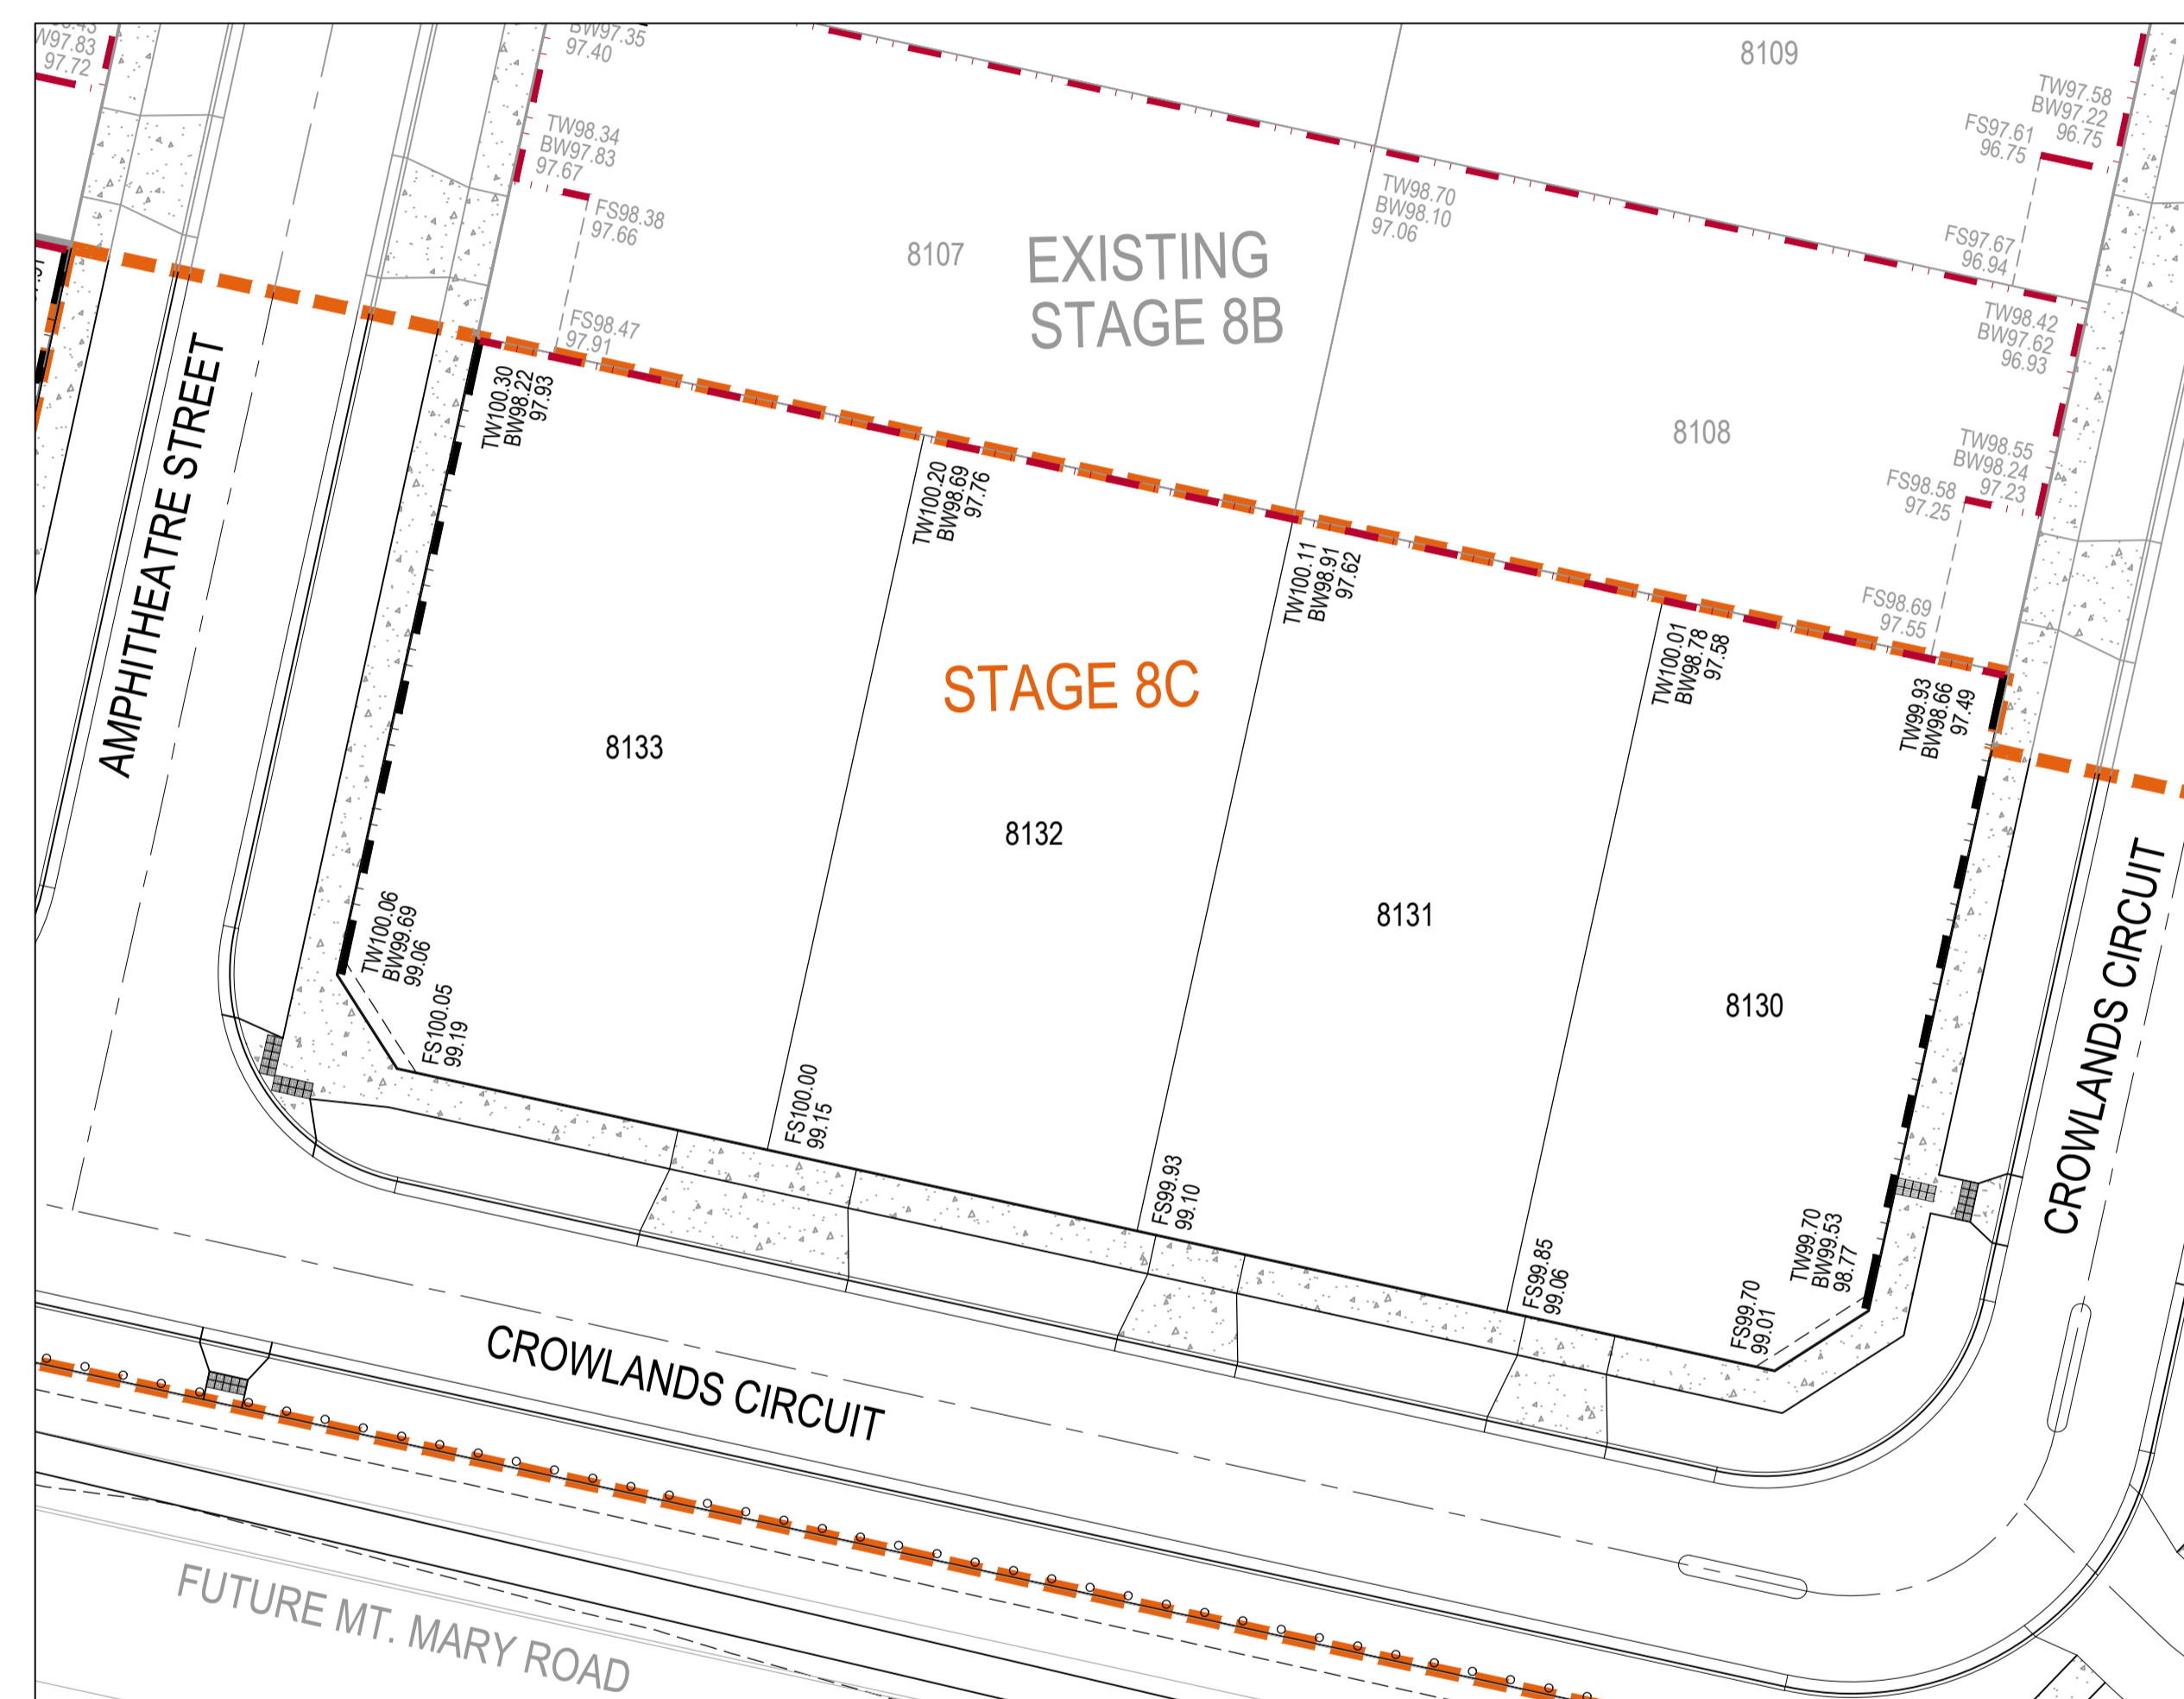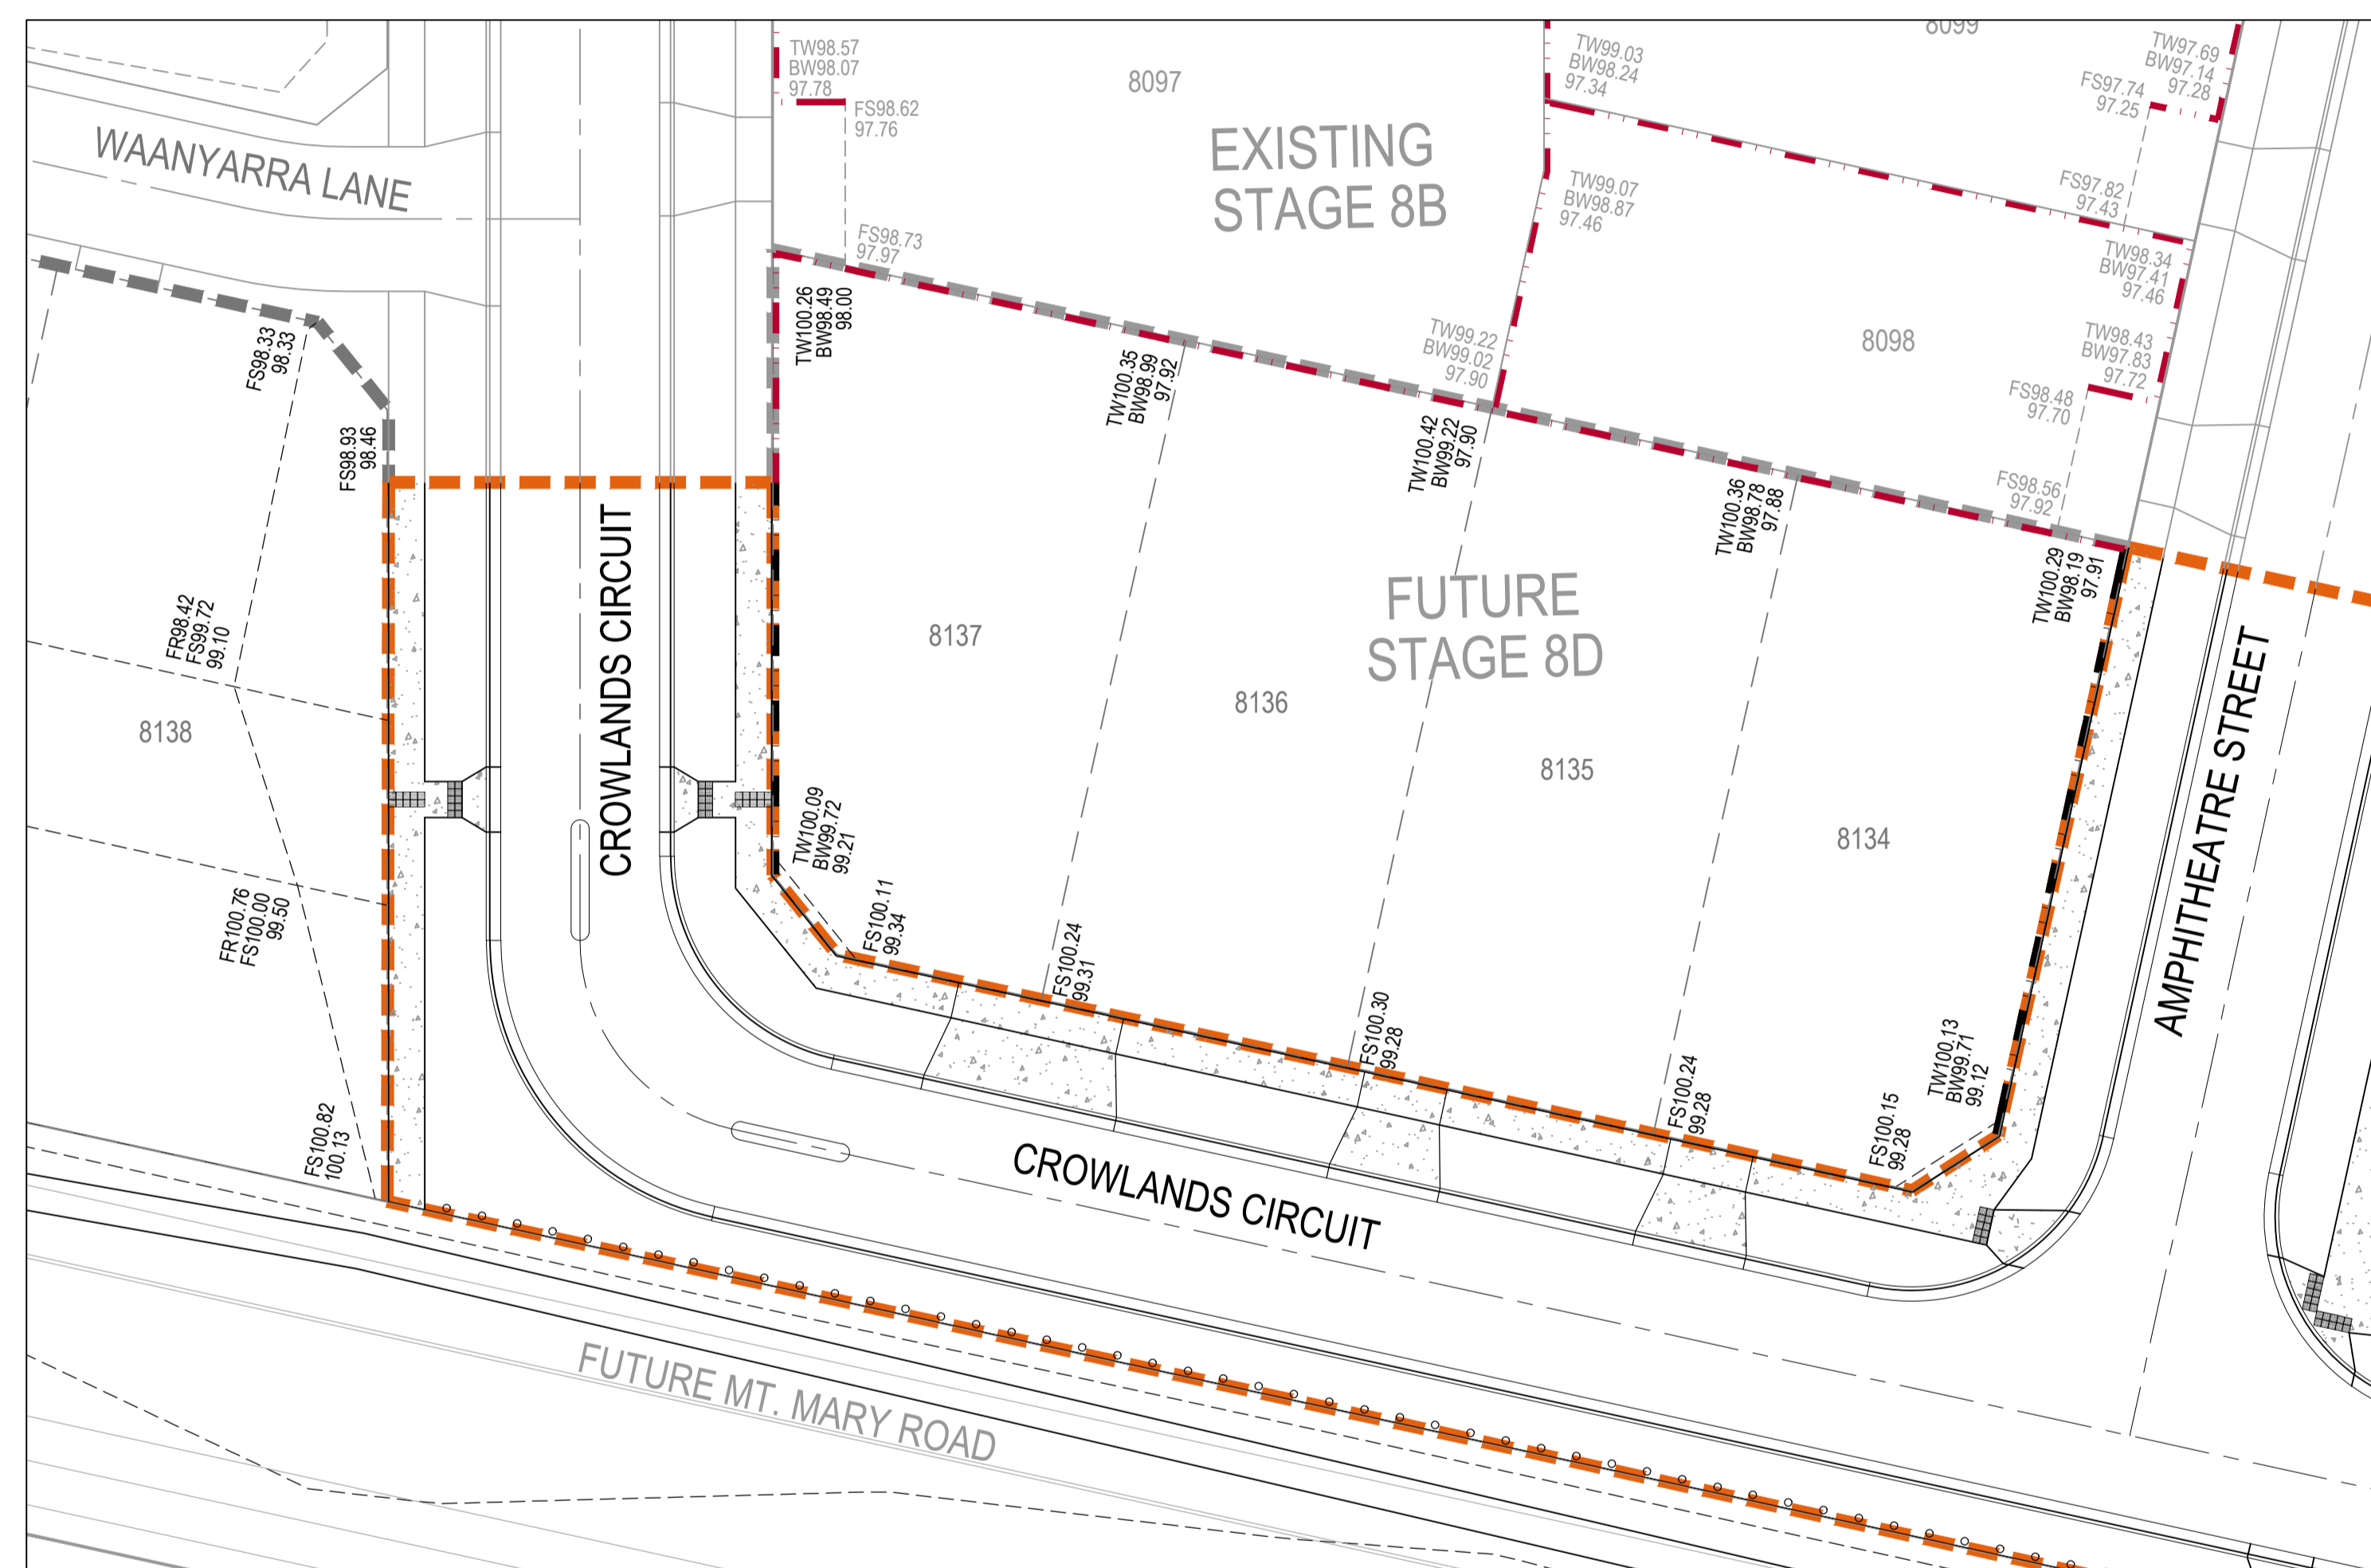

**AS CONSTRUCTED RECORDS**

THE OBJECTIVE OF THESE 'AS-CONSTRUCTED DRAWINGS' IS TO REFLECT ANY SIGNIFICANT CHANGES TO THE APPROVED CONSTRUCTION DRAWINGS AND PROVIDE COUNCIL WITH A RECORD OF DESIGN INTENT. ANY LEVELS AND COORDINATES SHOWN ON THESE PLANS ARE SUBJECT TO SURVEY AND WILL DIFFER. ARCADIS ACCEPTS NO RESPONSIBILITY FOR LOSS OR DAMAGES RESULTING FROM THE INTERPRETATION OF THESE DRAWINGS. ALL DETAILS AND ASSETS MUST BE ASCERTAINED AND VERIFIED BY THE END USER.

Issue	Description	By	Ckd	PM	Date
C	AS CONSTRUCTED	WB	ZS	SE	07.10.21
B	UPDATES TO LOT 8138	WB	ZS	SE	12.08.21
A	ISSUED FOR CONSTRUCTION	WB	ZS	SE	04.12.20
03	UPDATES TO ADDRESS COUNCIL COMMENTS	WB	ZS	SE	03.08.20
02	ISSUED FOR APPROVAL	WB	ZS	SE	10.07.20
01	ISSUED TO CLIENT FOR REVIEW	WB	ZS	SE	07.11.19

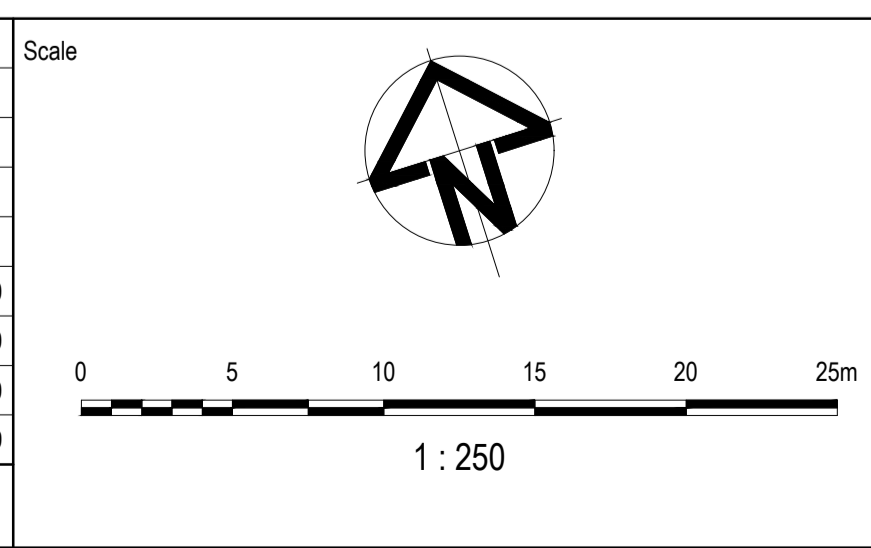

Planner

Client

Filename C-08c-700-10029435-RetainingWallPlan.dwg

Status

**AS CONSTRUCTED**

Verifier

Z.STROGUSZ

Scales

1:250

Original Issue Signatures

Original Size

A1

Height Datum

AHD

Grid

MGA

Drawn

W.BUMAGAT

Designed

J.ROCK

Project Manager

S.EISEL

© Copyright reserved

Project

EYNESBURY TOWNSHIP  
STAGE 8C

Title

RETAINING WALL LAYOUT  
PLAN SHEET 1 OF 2

Arcadis Australia Pacific Pty Limited  
Level 32, 140 William Street  
Melbourne VIC 3000  
ABN 76 104 485 289  
Tel No: +61 3 8623 4000  
www.arcadis.com

Drawing No.

C-08C-700

Project No.

10029435

Issue

C


Scale

1 : 250

100mm on Original

LEGEND	
	PROPOSED STAGE BOUNDARY
FR98.86	FINISHED RIDGE LEVEL
FS97.14	FINISHED SURFACE LEVEL
TW98.16	TOP OF WALL LEVEL
BW98.16	BOTTOM OF WALL LEVEL
93.750	EXISTING SURFACE LEVEL
	PROPOSED CONCRETE FOOTPATH/DRIVEWAY
	PROPOSED KERB & CHANNEL
	PROPOSED RETAINING WALL
	EXISTING RETAINING WALL
	PROPOSED RIDGE LINE


**NOTE:**  
 1. FOR RETAINING WALL DESIGN AND DETAILS REFER TO MIGLIC STRUCTURAL DESIGN PLANS.

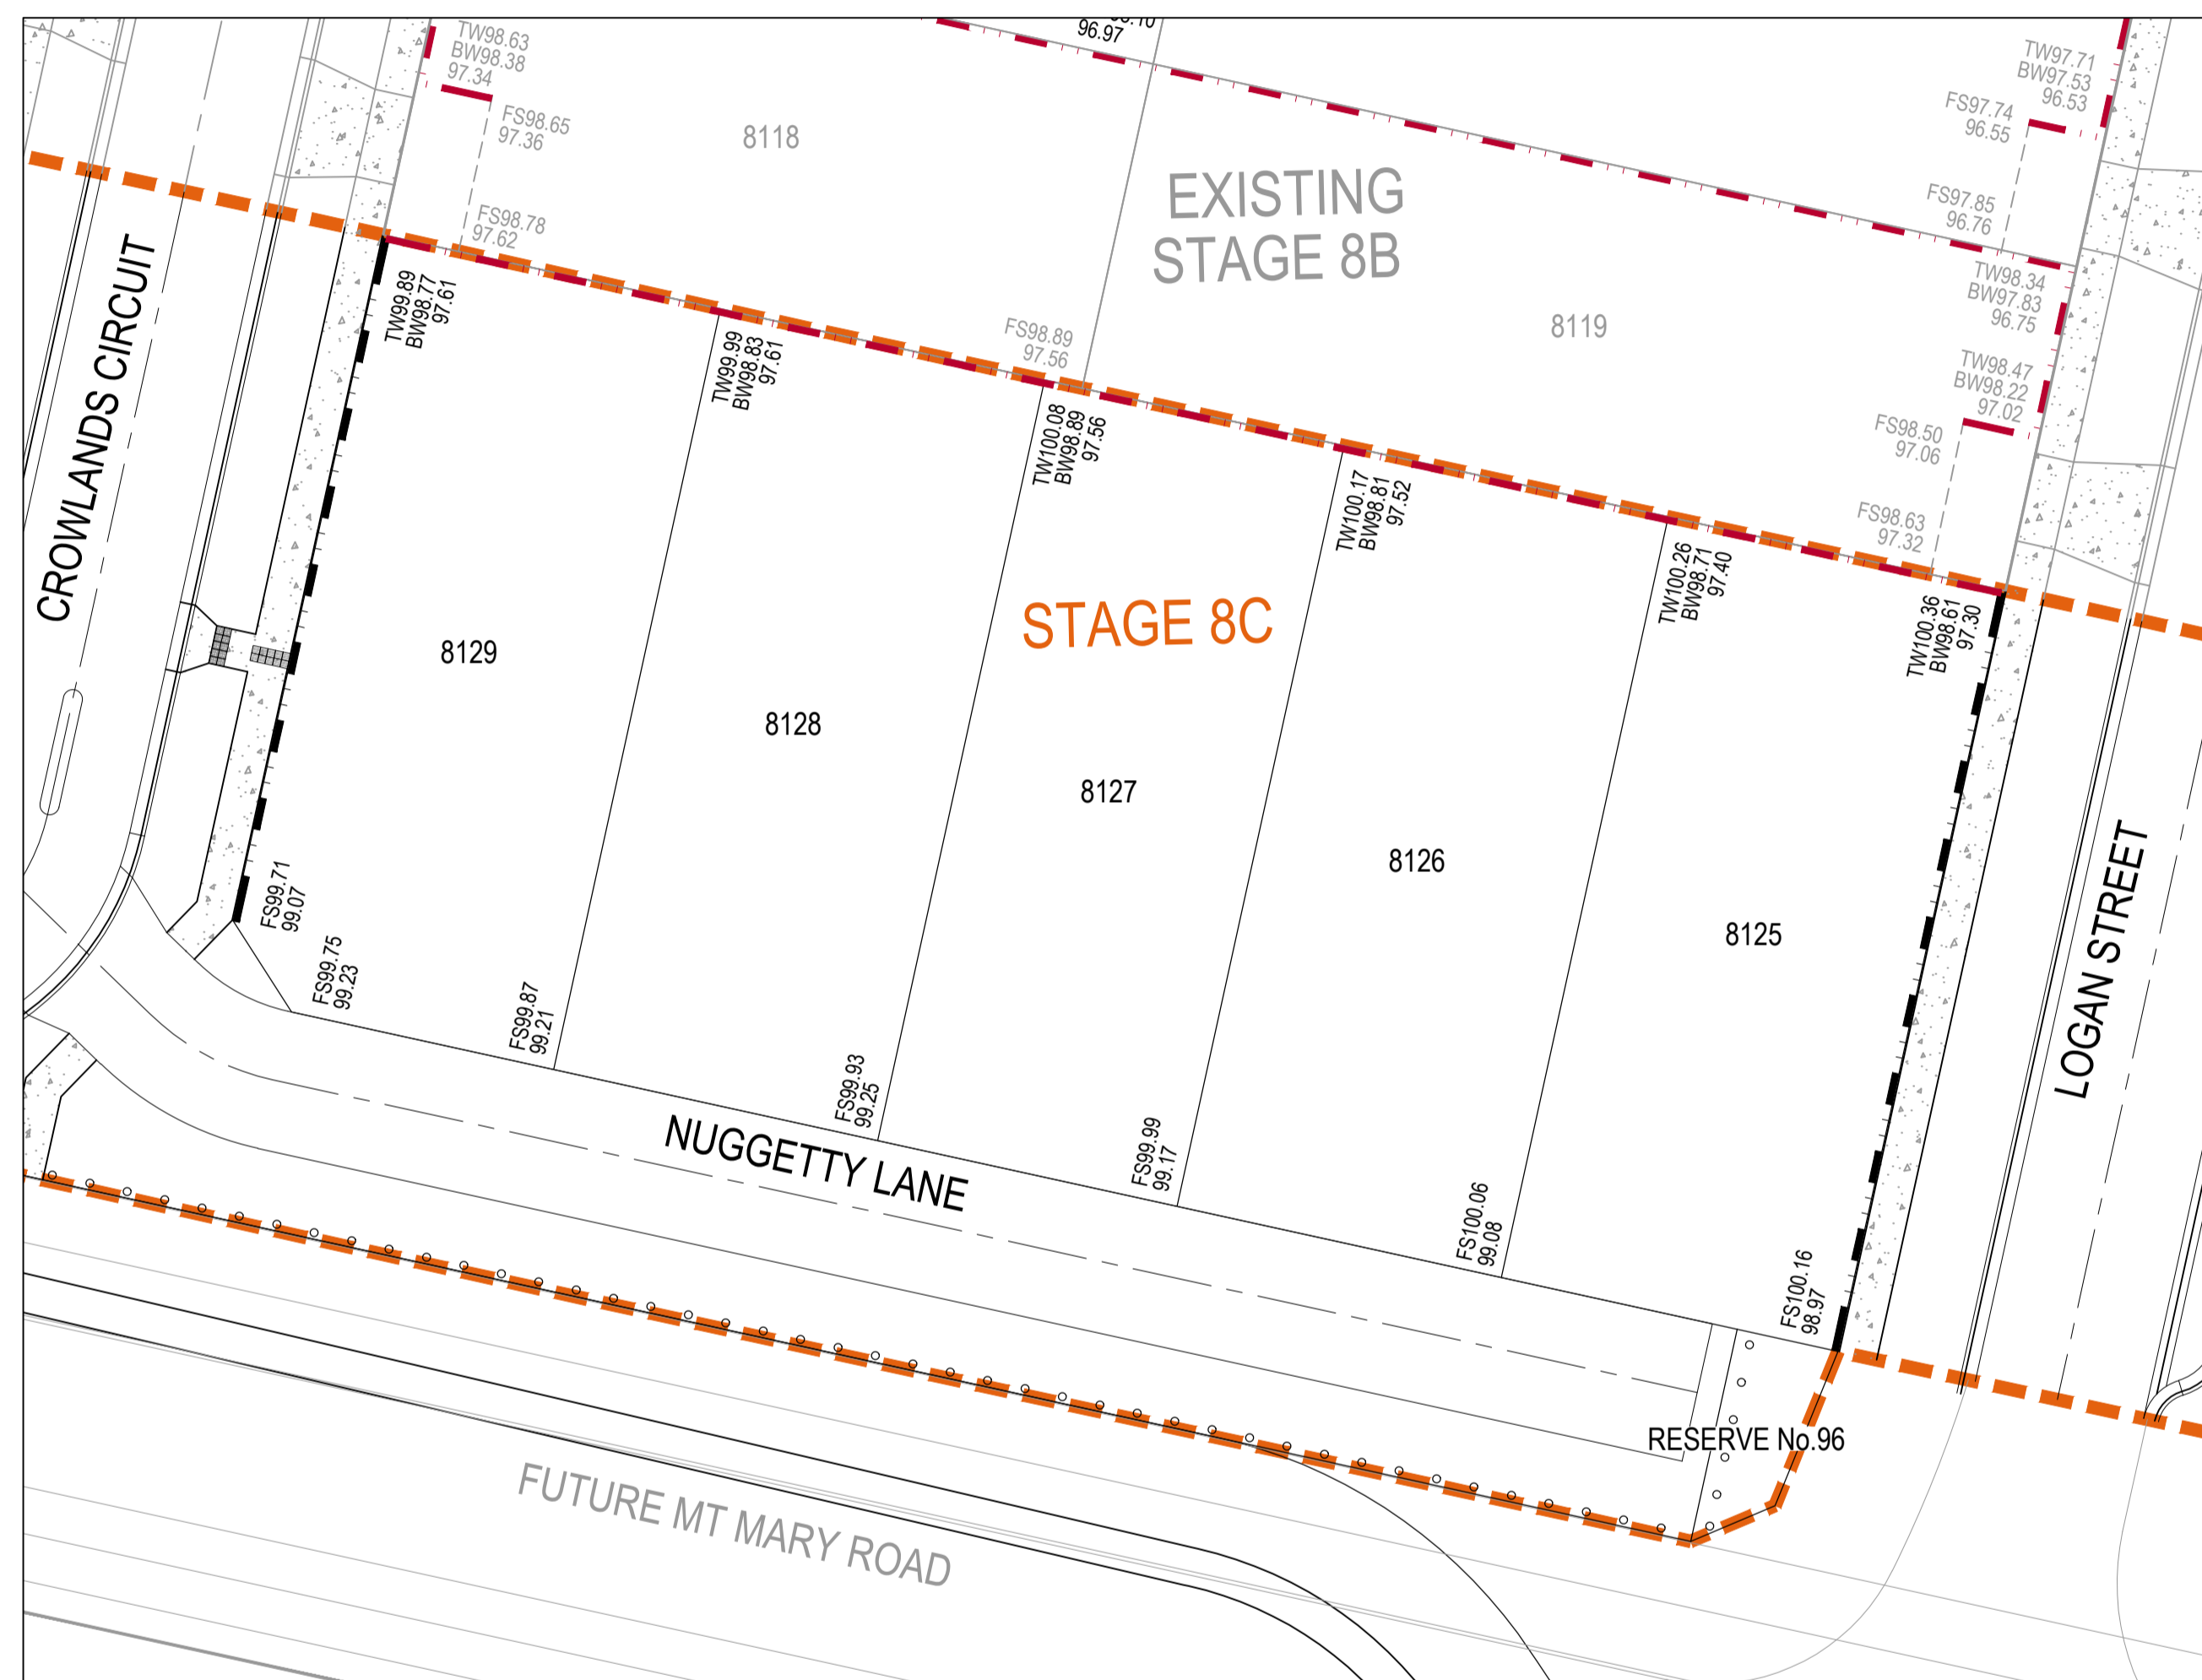

**AS CONSTRUCTED RECORDS**

THE OBJECTIVE OF THESE 'AS-CONSTRUCTED DRAWINGS' IS TO REFLECT ANY SIGNIFICANT CHANGES TO THE APPROVED CONSTRUCTION DRAWINGS AND PROVIDE COUNCIL WITH A RECORD OF DESIGN INTENT. ANY LEVELS AND COORDINATES SHOWN ON THESE PLANS ARE SUBJECT TO SURVEY AND WILL DIFFER. ARCADIS ACCEPT NO RESPONSIBILITY FOR LOSS OR DAMAGES RESULTING FROM THE INTERPRETATION OF THESE DRAWINGS. ALL DETAILS AND ASSETS MUST BE ASCERTAINED AND VERIFIED BY THE END USER.

Issue	Description	By	Ckd	PM	Date
B	AS CONSTRUCTED	WB	ZS	SE	07.10.21
A	ISSUED FOR CONSTRUCTION	WB	ZS	SE	04.12.20
03	UPDATES TO ADDRESS COUNCIL COMMENTS	WB	ZS	SE	03.08.20
02	ISSUED FOR APPROVAL	WB	ZS	SE	10.07.20
01	ISSUED TO CLIENT FOR REVIEW	WB	ZS	SE	07.11.19

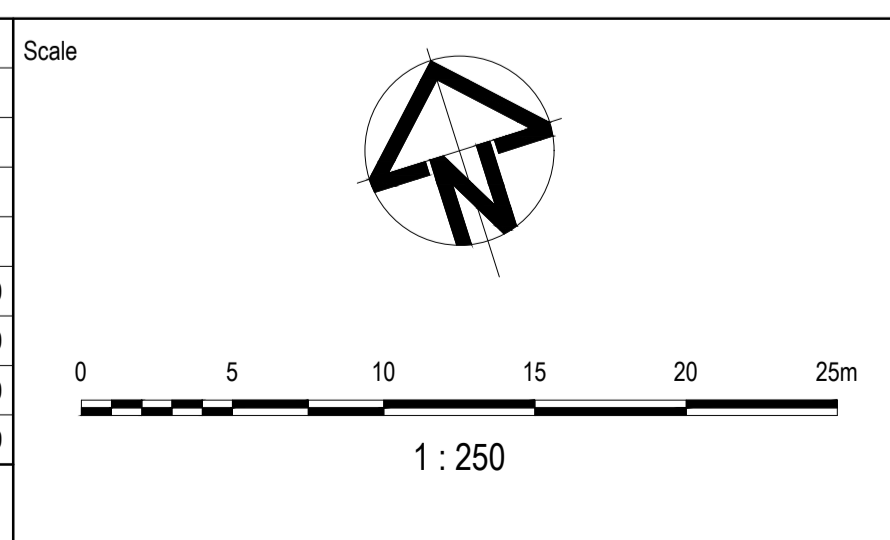

Planner

Client


Filename C-08c-701-10029435-RetainingWallPlan.dwg

Status	AS CONSTRUCTED	
Verifier	Z.STROGUSZ	
Scales	1:250	Original Issue Signatures
		Drawn W.BUMAGAT
Original Size	A1	Designed J.ROCK
Height Datum	AHD	Project Manager S.EISEL
Grid	MGA	© Copyright reserved

Project	EYNEBURY TOWNSHIP STAGE 8C
Title	RETAINING WALL LAYOUT PLAN SHEET 2 OF 2

Arcadis Australia Pacific Pty Limited  
 Level 32, 140 William Street  
 Melbourne VIC 3000  
 ABN 76 104 485 289  
 Tel No: +61 3 8623 4000  
 www.arcadis.com

Drawing No.	Project No.	Issue
C-08C-701	10029435	B

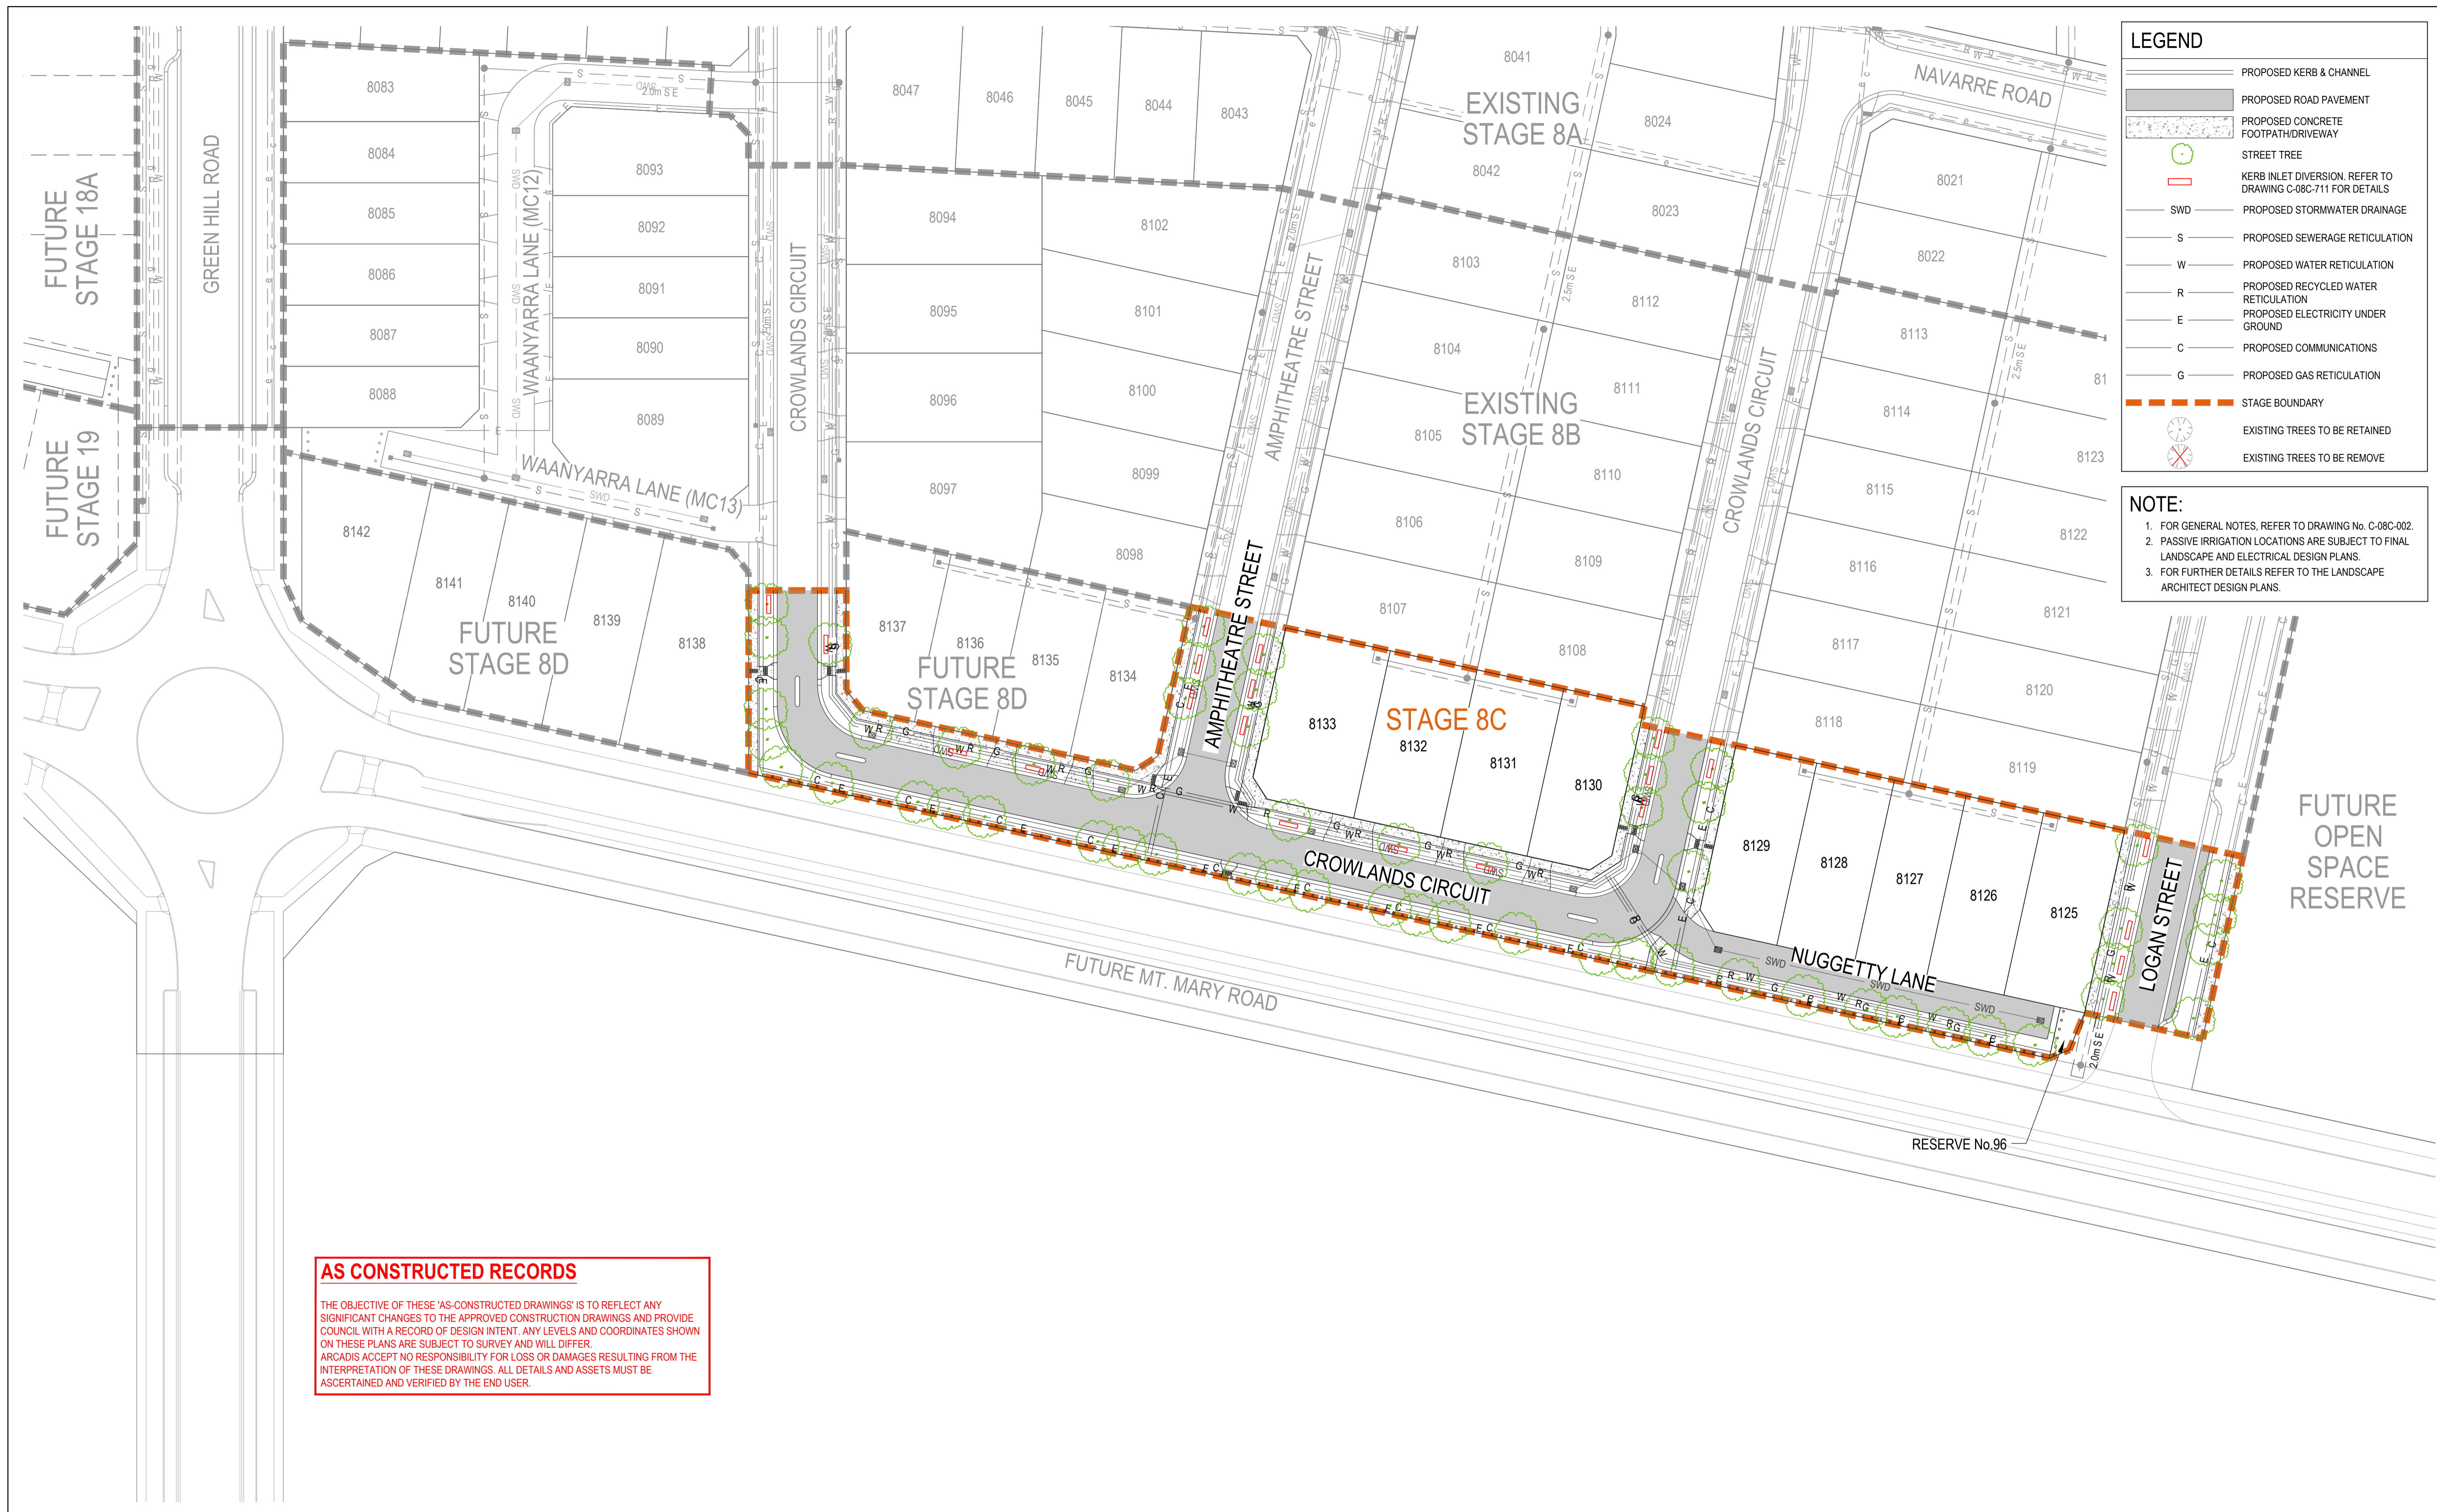

**LEGEND**

- PROPOSED KERB & CHANNEL
- PROPOSED ROAD PAVEMENT
- PROPOSED CONCRETE FOOTPATH/DRIVEWAY
- STREET TREE
- KERB INLET DIVERSION. REFER TO DRAWING C-08C-711 FOR DETAILS
- SWD PROPOSED STORMWATER DRAINAGE
- PROPOSED SEWERAGE RETICULATION
- PROPOSED WATER RETICULATION
- PROPOSED RECYCLED WATER RETICULATION
- PROPOSED ELECTRICITY UNDER GROUND
- PROPOSED COMMUNICATIONS
- PROPOSED GAS RETICULATION
- STAGE BOUNDARY
- EXISTING TREES TO BE RETAINED
- EXISTING TREES TO BE REMOVE


**NOTE:**

1. FOR GENERAL NOTES, REFER TO DRAWING No. C-08C-002.
2. PASSIVE IRRIGATION LOCATIONS ARE SUBJECT TO FINAL LANDSCAPE AND ELECTRICAL DESIGN PLANS.
3. FOR FURTHER DETAILS REFER TO THE LANDSCAPE ARCHITECT DESIGN PLANS.

**AS CONSTRUCTED RECORDS**

THE OBJECTIVE OF THESE 'AS-CONSTRUCTED DRAWINGS' IS TO REFLECT ANY SIGNIFICANT CHANGES TO THE APPROVED CONSTRUCTION DRAWINGS AND PROVIDE COUNCIL WITH A RECORD OF DESIGN INTENT. ANY LEVELS AND COORDINATES SHOWN ON THESE PLANS ARE SUBJECT TO SURVEY AND WILL DIFFER. ARCADIS ACCEPT NO RESPONSIBILITY FOR LOSS OR DAMAGES RESULTING FROM THE INTERPRETATION OF THESE DRAWINGS. ALL DETAILS AND ASSETS MUST BE ASCERTAINED AND VERIFIED BY THE END USER.

Issue	Description	By	Ckd	PM	Date
B	AS CONSTRUCTED	WB	ZS	SE	07.10.21
A	ISSUED FOR CONSTRUCTION	WB	ZS	SE	04.12.20
04	UPDATES TO ADDRESS COUNCIL COMMENTS	HP	ZS	SE	19.08.20
03	UPDATES TO ADDRESS COUNCIL COMMENTS	WB	ZS	SE	03.08.20
02	ISSUED FOR APPROVAL	WB	ZS	SE	10.07.20
01	ISSUED TO CLIENT FOR REVIEW	WB	ZS	SE	07.11.19

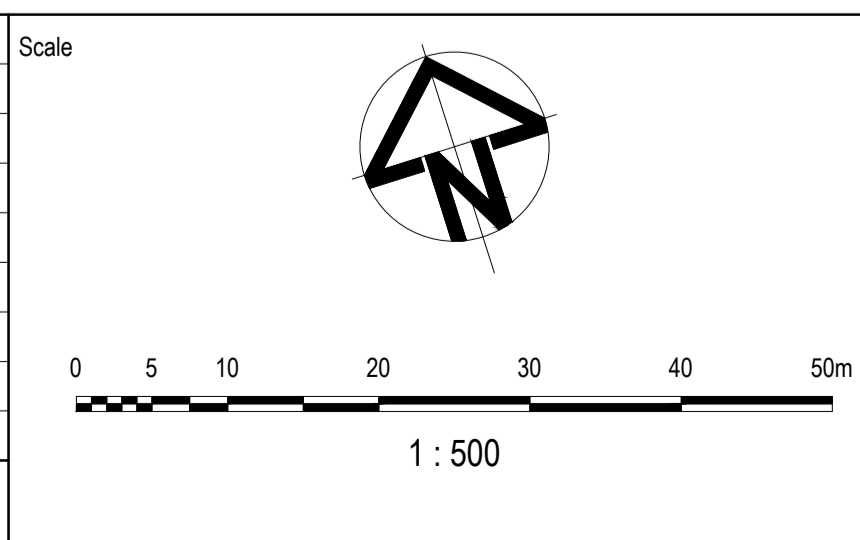

Planner

Filename C-08c-710-10029435-LandscapeLayoutPlan.dwg

Client

Status	AS CONSTRUCTED	
Verifier	Z.STROGUSZ	
Scales	1:500	Original Issue Signatures
		Drawn W.BUMAGAT
Original Size	A1	Designed J.ROCK
Height Datum	AHD	Project Manager S.EISEL
Grid	MGA	© Copyright reserved

Project

EYNEBURY TOWNSHIP  
STAGE 8C



Title

PASSIVE IRRIGATION LAYOUT

Arcadis Australia Pacific Pty Limited  
Level 32, 140 William Street  
Melbourne VIC 3000  
ABN 76 104 485 289  
Tel No: +61 3 8623 4000  
www.arcadis.com

Drawing No. C-08C-710 Project No. 10029435 Issue B

- NOTE:**  
**GRAVEL TRENCH - KERB INLET**
1. TOP OF GRAVEL TRENCH TO BE LINED WITH NON-WOVEN GEOTEXTILE MATERIAL AS SHOWN TO PREVENT FINE MIGRATION INTO TRENCH.
  2. PASSIVE IRRIGATION PIPES AND FITTINGS TO BE 90mm DIAMETER PVC SEWER CLASS.
  3. ALL PVC JOINTS TO BE SEALED WITH SOLVENT CEMENT.
  4. ALL GRASSED AREAS TO BE TOP DRESSED WITH 100 MM TOPSOIL AND SEEDED AS SPECIFIED.
  5. SERVICE DEPTHS AND LOCATIONS ARE INDICATIVE ONLY.
  6. FOR GENERAL NOTES, REFER TO DRAWING No. C-08C-002.

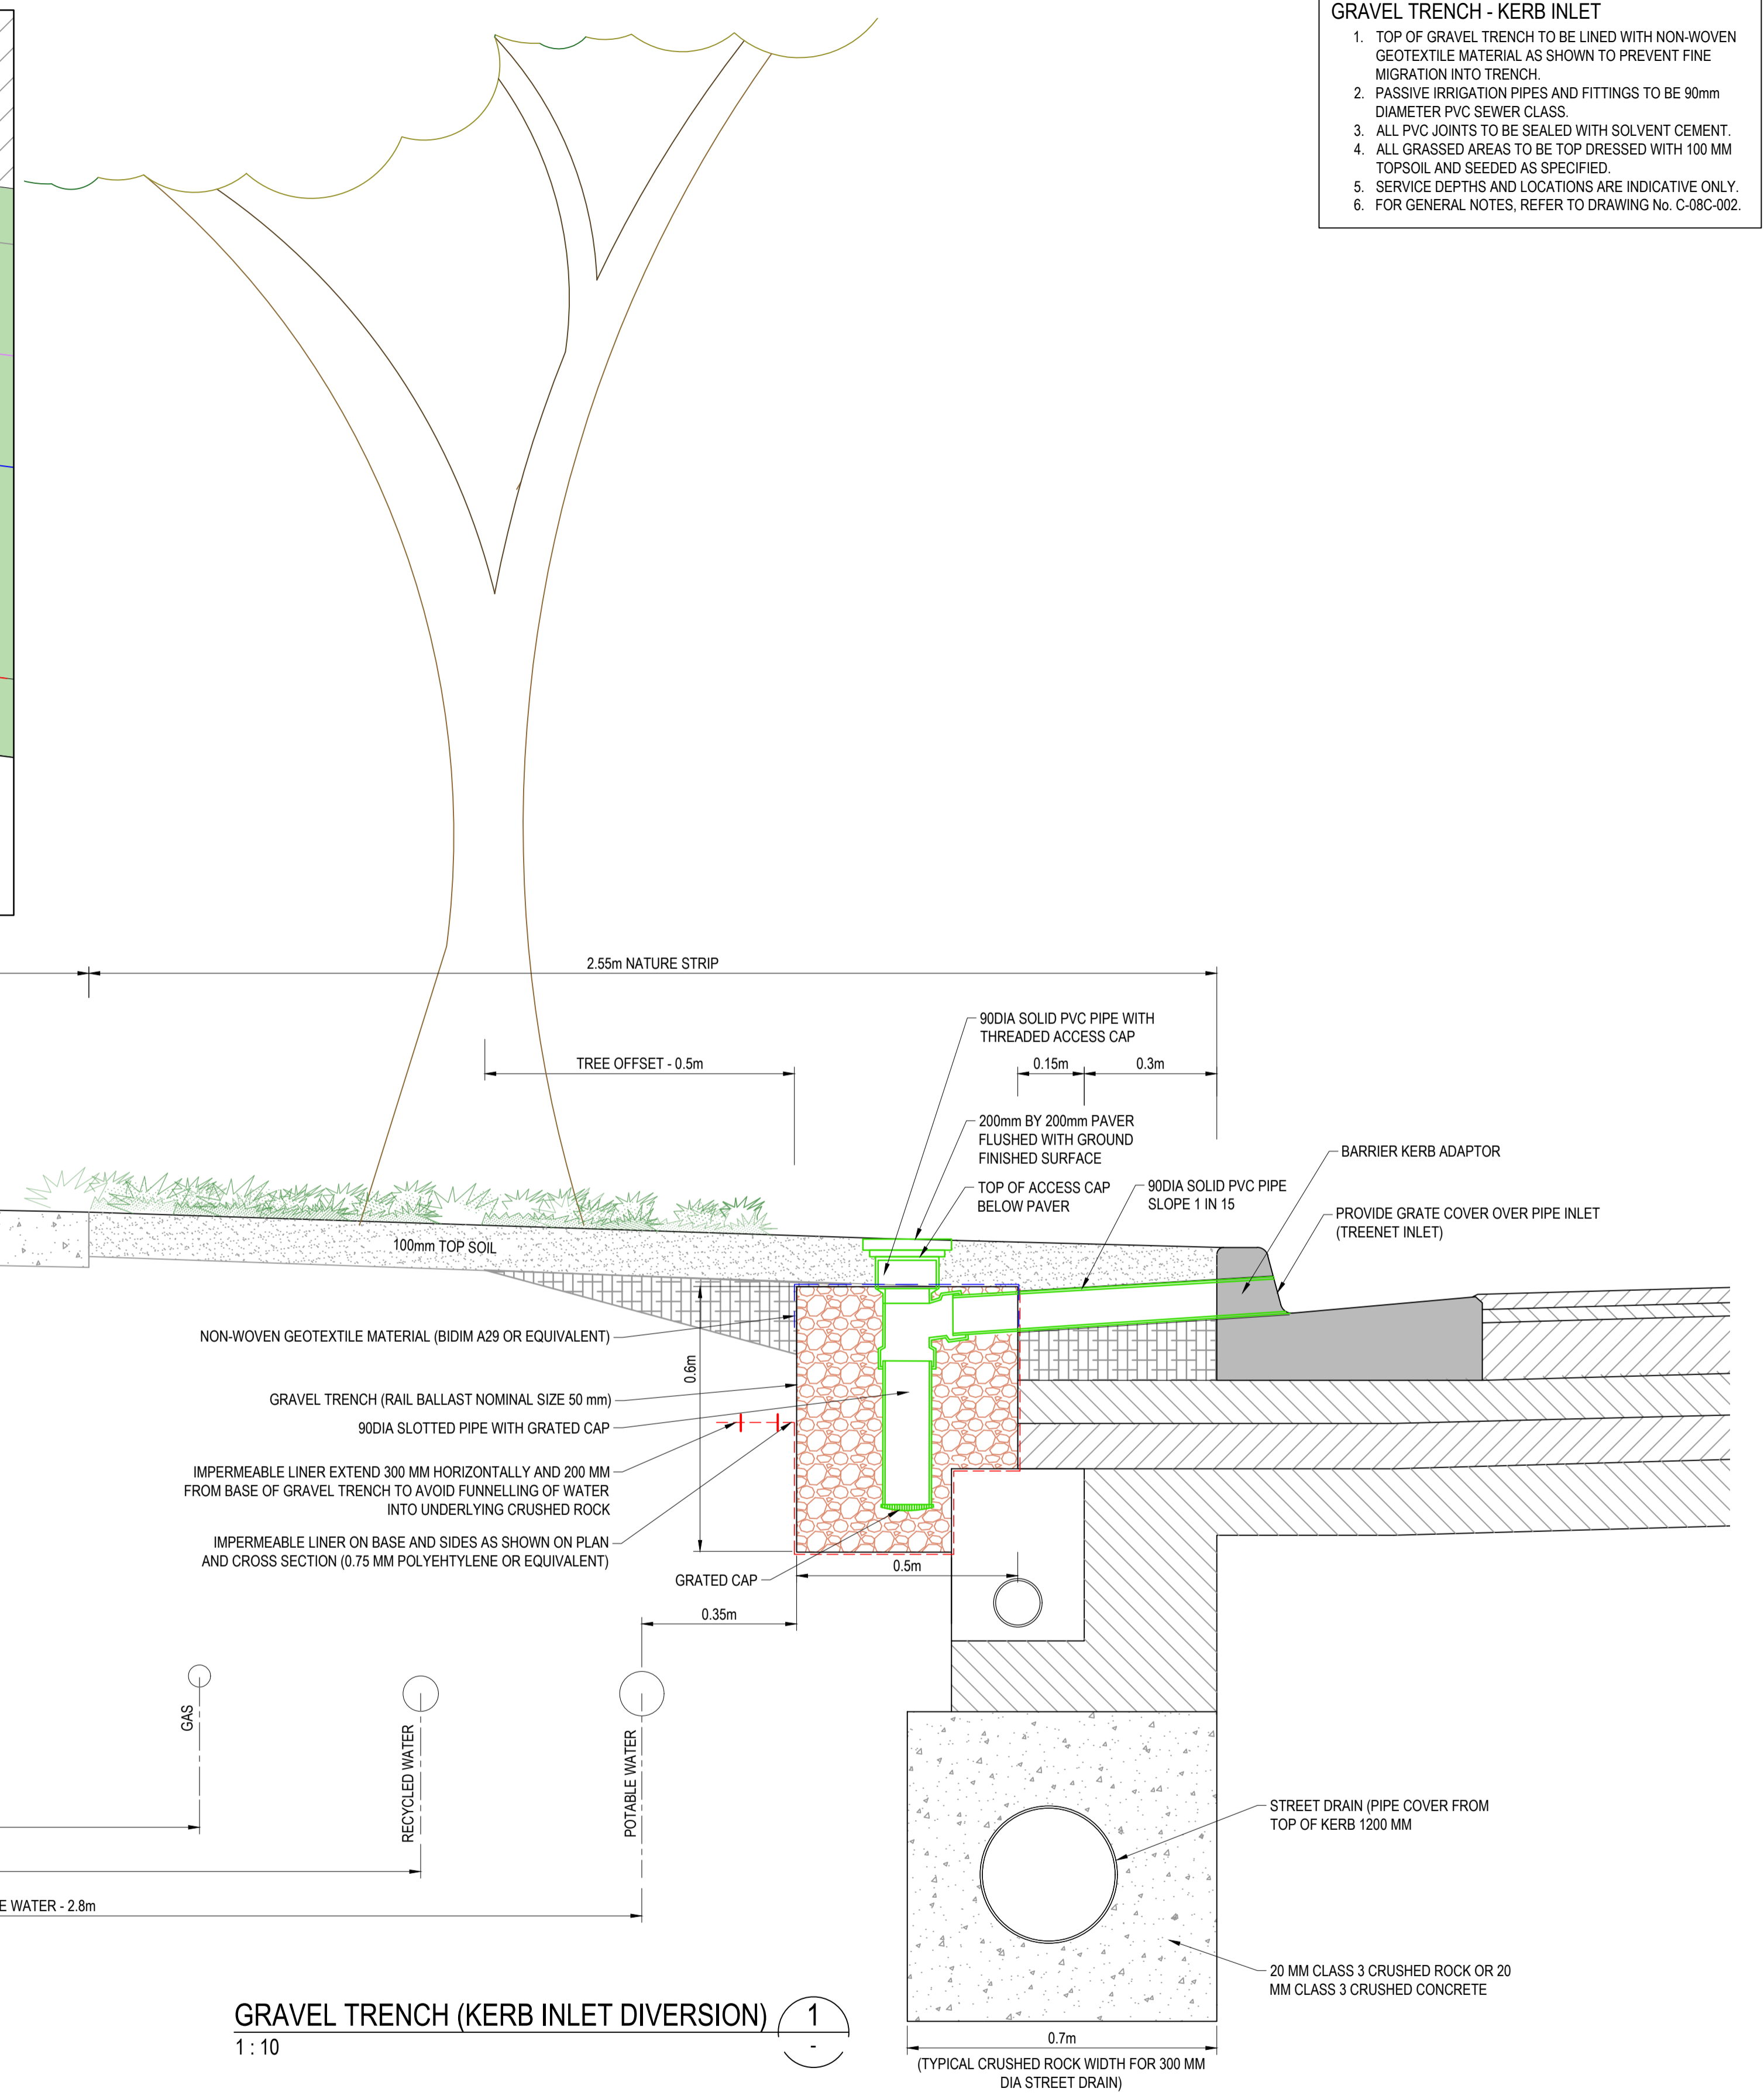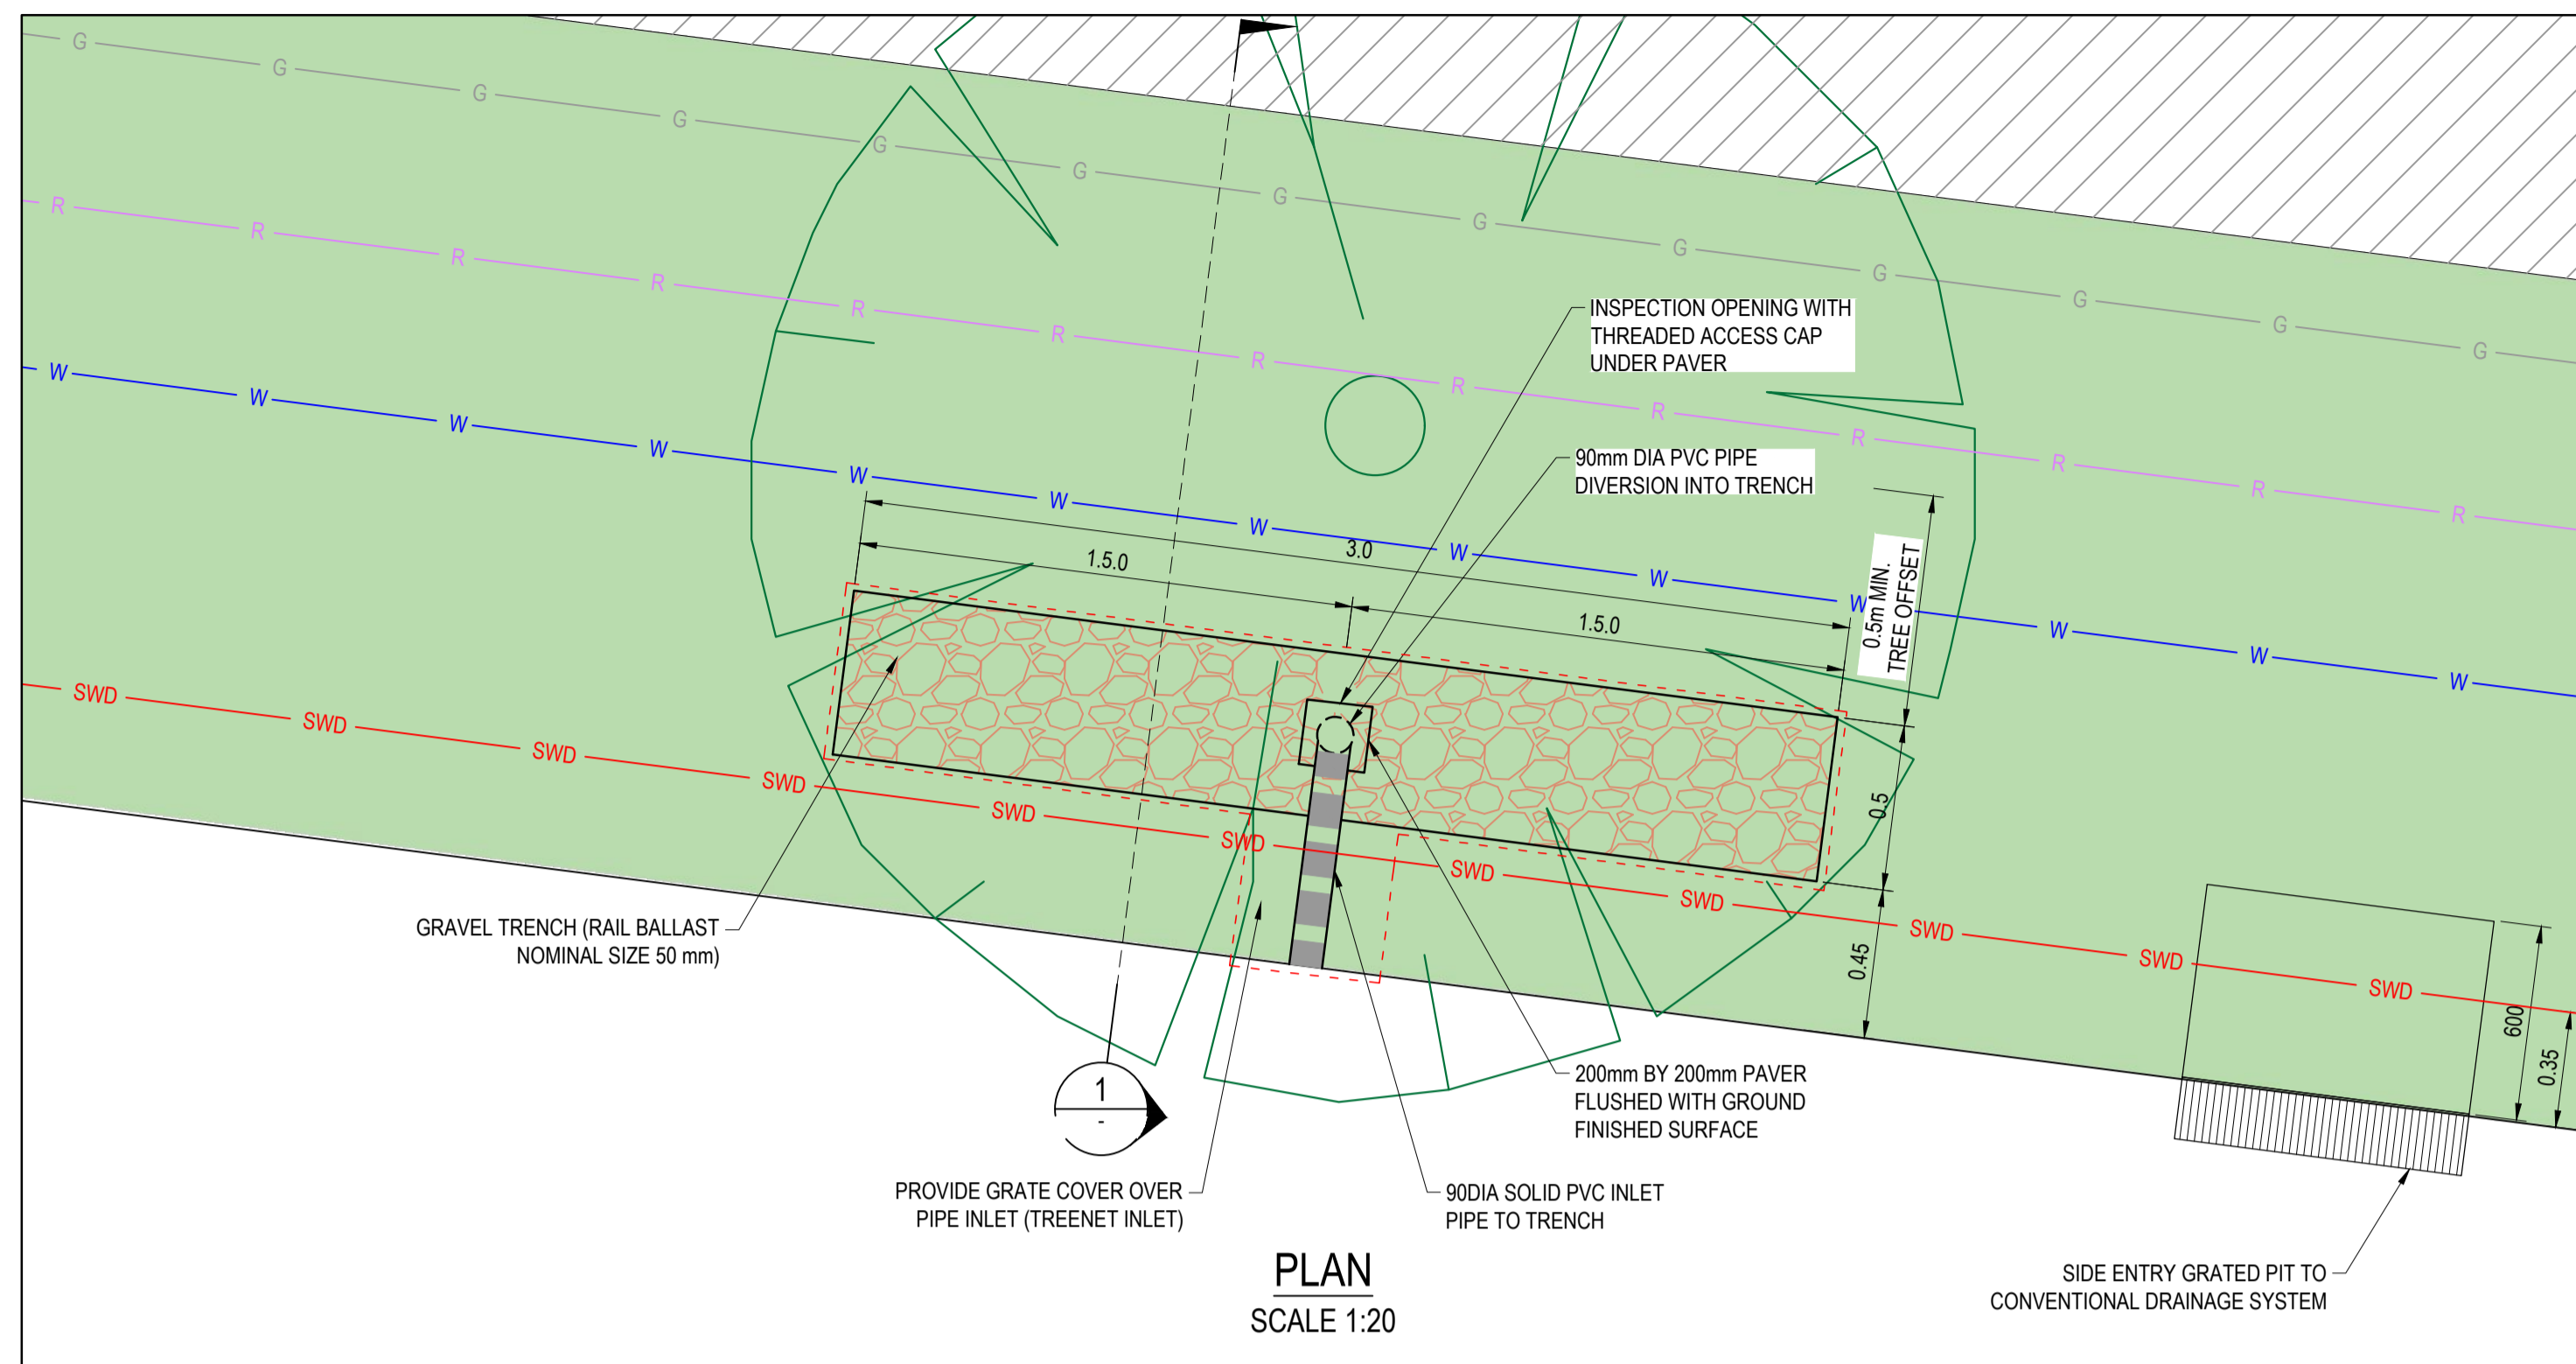


TREENET INLET

**AS CONSTRUCTED RECORDS**

THE OBJECTIVE OF THESE 'AS-CONSTRUCTED DRAWINGS' IS TO REFLECT ANY SIGNIFICANT CHANGES TO THE APPROVED CONSTRUCTION DRAWINGS AND PROVIDE COUNCIL WITH A RECORD OF DESIGN INTENT. ANY LEVELS AND COORDINATES SHOWN ON THESE PLANS ARE SUBJECT TO SURVEY AND WILL DIFFER. ARCADIS ACCEPT NO RESPONSIBILITY FOR LOSS OR DAMAGES RESULTING FROM THE INTERPRETATION OF THESE DRAWINGS. ALL DETAILS AND ASSETS MUST BE ASCERTAINED AND VERIFIED BY THE END USER.

Issue	Description	By	Ckd	PM	Date
B	AS CONSTRUCTED	WB	ZS	SE	07.10.21
A	ISSUED FOR CONSTRUCTION	WB	ZS	SE	04.12.20
05	SUBSOIL DRAIN EXTENTS AMENDED	MD	ZS	JM	26.08.20
04	UPDATES TO ADDRESS COUNCIL COMMENTS	HP	ZS	SE	19.08.20
03	UPDATES TO ADDRESS COUNCIL COMMENTS	WB	ZS	SE	03.08.20
02	ISSUED FOR APPROVAL	WB	ZS	SE	10.07.20
01	ISSUED TO CLIENT FOR REVIEW	WB	ZS	SE	07.11.19

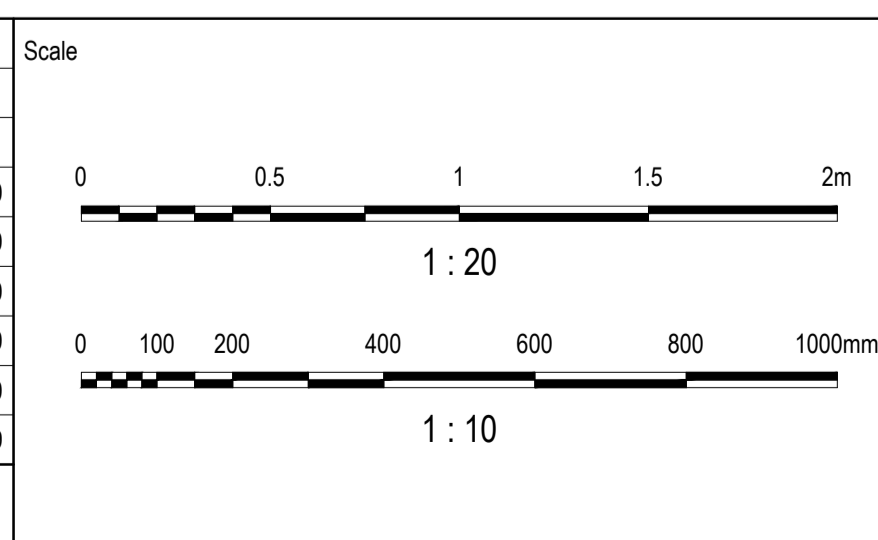

Planner

RD RobertsDay  
planning.design.place

Client

RESIMAX  
GROUP

Filename C-08c-711-10029435-LandscapeDetails.dwg

Status

AS CONSTRUCTED

Verifier

Z.STROGUSZ

Scales

1:10  
1:20

Original Issue Signatures

Drawn  
W.BUMAGAT

Designed  
J.ROCK

Project Manager  
S.EISEL

Original Size

A1

Height Datum

AHD

Grid

MGA

© Copyright reserved

Project

EYNESBURY TOWNSHIP  
STAGE 8C

Title

PASSIVE IRRIGATION DETAILS

Arcadis Australia Pacific Pty Limited  
Level 32, 140 William Street  
Melbourne VIC 3000  
ABN 76 104 485 289  
Tel No: +61 3 8623 4000  
www.arcadis.com

Drawing No.

C-08C-711

Project No.

10029435

Issue

B